

TEMPORARY 4 INCH WHITE LINE, PAINT
 DURABLE 4 INCH WHITE LINE (OPTION ITEM)
 122+50 TO 123+95 SOLID LT & RT
 124+04 TO 125+03 SOLID LT
 124+04 TO 126+12 SOLID RT
 124+96 TO 125+03 SOLID LT (VT 25B)
 125+05 TO 126+69 SOLID LT
 126+41 TO 126+42 SOLID LT (NO PARKING)
 126+53 TO 126+54 SOLID LT (NO PARKING)
 126+76 TO 126+97 SOLID LT (NO PARKING)
 126+76 TO 127+12 SOLID RT (NO PARKING)
 126+97 TO 127+47 SOLID LT (PARKING)
 127+09 TO 127+63 SOLID RT (PARKING)
 127+49 TO 127+67 SOLID LT (NO PARKING)
 127+75 TO 127+78 SOLID LT (TH 63)
 127+60 TO 127+94 SOLID RT (NO PARKING)
 127+98 TO 127+99 SOLID LT (TH 63)
 128+09 TO 128+29 SOLID LT (NO PARKING)
 128+28 TO 128+43 SOLID RT (NO PARKING)
 128+29 TO 128+50 SOLID LT (PARKING)
 128+40 TO 128+50 SOLID RT (PARKING)

TEMPORARY 4 INCH YELLOW LINE, PAINT
 DURABLE 4 INCH YELLOW LINE (OPTION ITEM)
 122+50 TO 123+95 SOLID LT & RT
 124+04 TO 125+50 SOLID LT & RT
 125+01 TO 125+20 SOLID LT (VT 25B)
 125+90 TO 126+14 SOLID LT & RT
 126+34 DOUBLE SOLID RT (TH 68)
 126+54 TO 126+68 SOLID LT & RT
 126+78 TO 127+67 SOLID LT & RT
 127+87 TO 127+88 DOUBLE SOLID LT (TH 63)
 128+05 TO 128+50 SOLID LT & RT
 TEMPORARY 8 INCH WHITE LINE, PAINT
 DURABLE 8 INCH WHITE LINE (OPTION ITEM)
 126+41 TO 126+54 SOLID LT (NO PARKING)
 TEMPORARY 24 INCH STOP BAR, PAINT
 DURABLE 24 INCH STOP BAR (OPTION ITEM)
 125+14 TO 125+20 LT (VT 25B)
 126+35 TO 126+51 RT (TH 68)
 127+76 TO 127+86 LT (TH 63)

TEMPORARY LETTER OR SYMBOL, PAINT
 DURABLE LETTER OR SYMBOL (OPTION ITEM)
 125+10 LT *STOP* (VT 25B)
 126+44 RT *STOP* (TH 68)
 127+51 LT ACCESSIBLE PARKING SYMBOL
 127+56 RT ACCESSIBLE PARKING SYMBOL
 127+81 LT *STOP* (TH 63)

TEMPORARY CROSSWALK MARKING, PAINT
 DURABLE CROSSWALK MARKING (OPTION ITEM)
 124+00 LT TO RT
 126+18 TO 126+53 RT (TH 68)
 126+72 TO 126+75 RT TO LT
 127+68 TO 128+02 LT (TH 63)
 127+97 TO 128+05 RT TO LT

CHANGING ELEVATION OF
 DROP INLETS, CATCH BASINS, OR MANHOLES
 126+81 LT (DMH)

REHAB. DROP INLETS, CATCH BASINS,
 OR MANHOLES, CLASS I, CLASS II
 123+34 LT
 124+08 LT
 125+05 LT (VT 25B)
 125+06 LT
 126+08 LT
 126+80 RT

VERTICAL GRANITE CURB
 122+76 TO 123+32 LT

PORTLAND CEMENT
 CONCRETE SIDEWALK, 5 INCH
 122+76 TO 123+32 LT
 123+96 TO 124+02 RT (RAMP TYPE 6)
 123+97 TO 124+02 LT (RAMP TYPE 6)
 126+10 TO 126+18 RT (RAMP TYPE 1)
 126+71 TO 126+77 LT (RAMP TYPE 1)
 128+03 TO 128+08 LT (RAMP TYPE 3)


DETECTABLE WARNING SURFACE (DWS)

124+00 RT
 124+00 LT
 126+17 RT
 126+74 LT
 128+04 LT
 128+05 LT
 126+17 LT

REMOVING SIGNS
 AS SHOWN - 14

ERECTING SALVAGED SIGNS
 AS SHOWN - 10

THINNING AND TRIMMING FOR SIGNS
 123+94 RT

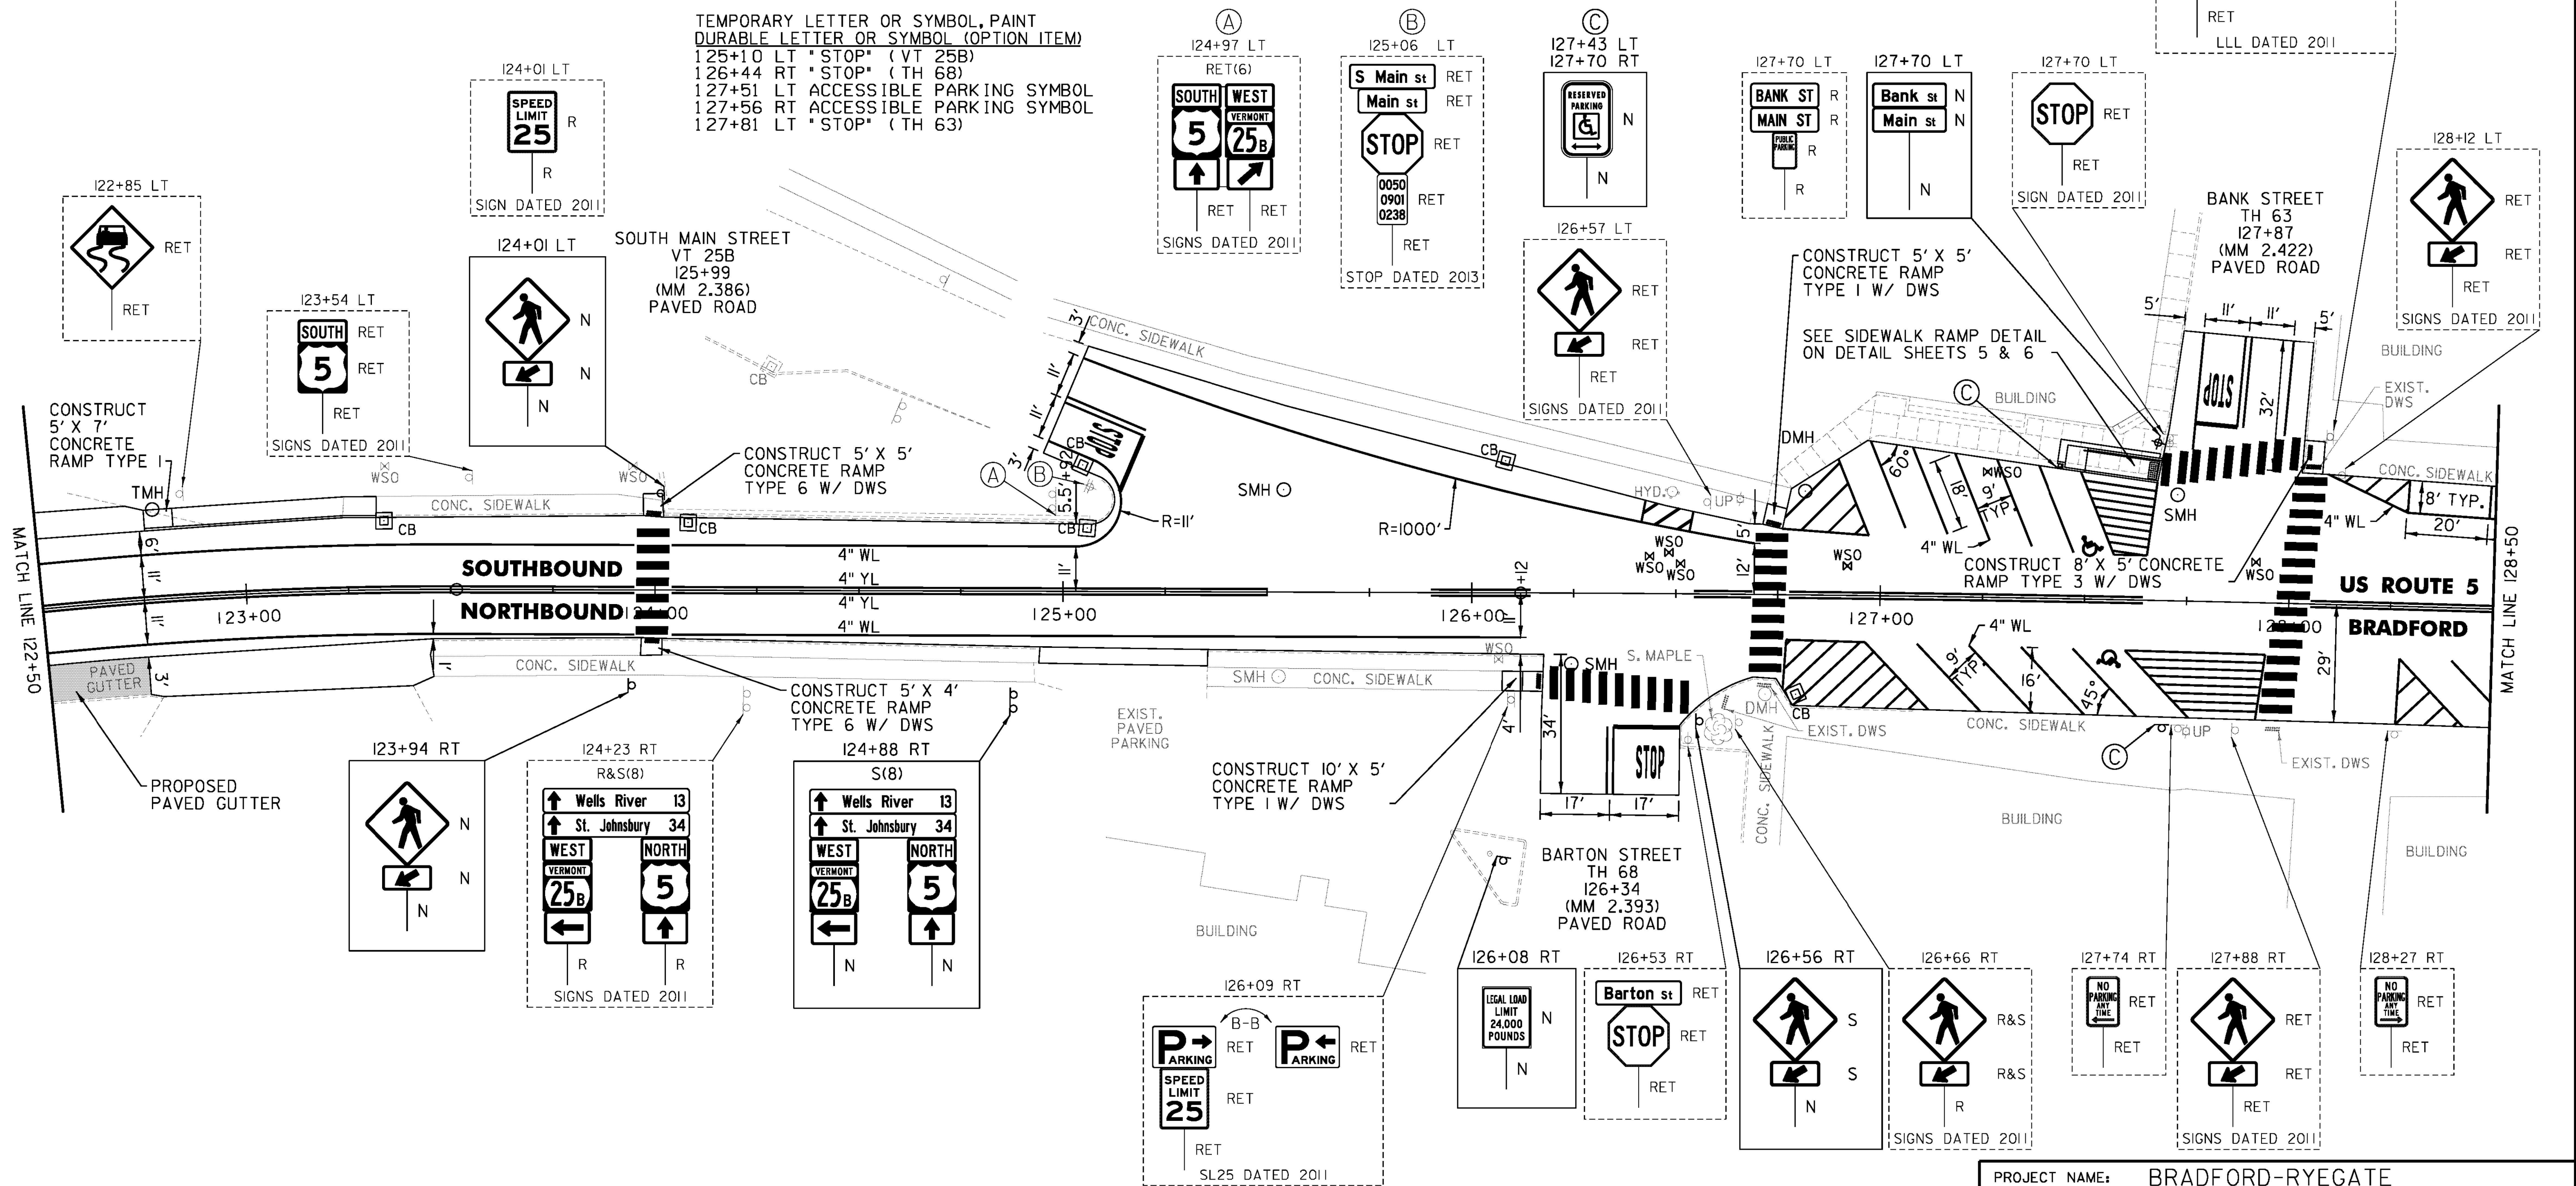

NOT TO SCALE

PROJECT NAME:	BRADFORD-RYEGATE
PROJECT NUMBER:	STP 2929(I)
FILE NAME:	z10c264bdr.dgn
PROJECT LEADER:	P. SHEDD
DESIGNED BY:	N. LEMAY
US 5 PLAN SHEET 8	
PLOT DATE:	2/4/2016
DRAWN BY:	W. GORDON
CHECKED BY:	P. SHEDD
SHEET	66 OF 239

CLD 14-0278