

TEMPORARY 4 INCH WHITE LINE, PAINT
 DURABLE 4 INCH WHITE LINE (OPTION ITEM)
 128+50 TO 131+51 SOLID RT (PARKING)
 128+50 TO 128+91 SOLID LT (PARKING)
 129+16 TO 129+78 SOLID LT (PARKING)
 131+47 TO 131+89 SOLID RT (NO PARKING)
 131+92 SOLID RT (TH 74)
 132+28 SOLID RT (TH 74)
 132+39 TO 133+50 SOLID LT
 132+39 TO 133+50 SOLID RT
 132+41 SOLID RT (NO PARKING)
 132+53 SOLID RT (NO PARKING)

TEMPORARY 4 INCH YELLOW LINE, PAINT
 DURABLE 4 INCH YELLOW LINE (OPTION ITEM)
 128+50 TO 131+90 SOLID LT & RT
 132+10 DOUBLE SOLID RT (TH 74)
 132+39 TO 133+50 SOLID LT & RT

TEMPORARY 8 INCH WHITE LINE, PAINT
 DURABLE 8 INCH WHITE LINE (OPTION ITEM)
 132+41 TO 132+53 SOLID RT (NO PARKING)

TEMPORARY 24 INCH STOP BAR, PAINT
 DURABLE 24 INCH STOP BAR (OPTION ITEM)
 132+10 TO 132+28 RT (TH 74)

TEMPORARY LETTER OR SYMBOL, PAINT
 DURABLE LETTER OR SYMBOL (OPTION ITEM)
 132+19 RT *STOP* (TH 74)

TEMPORARY CROSSWALK MARKING, PAINT
 DURABLE CROSSWALK MARKING (OPTION ITEM)
 131+89 TO 132+28 RT
 132+34 LT TO RT

REHAB. DROP INLETS, CATCH BASINS,
 OR MANHOLES, CLASS I, CLASS II

130+03 RT
 130+27 LT
 132+00 RT
 132+27 LT

CHANGING ELEVATION
 OF SEWER MANHOLES (NON-PART)
 132+77 RT (TMH)

PORTLAND CEMENT
 CONCRETE SIDEWALK, 5 INCH
 132+30 TO 132+39 RT (RAMP TYPE 3)
 132+32 TO 132+37 LT (RAMP TYPE 6)


DETECTABLE WARNING SURFACE (DWS)
 132+31 RT
 132+34 RT
 132+34 LT

BITUMINOUS CONCRETE
 GUTTERS AND TRAFFIC ISLANDS
 132+29 TO 133+03 LT
 133+18 TO 133+50 LT


REMOVING SIGNS
 AS SHOWN - 6

ERECTING SALVAGED SIGNS
 AS SHOWN - 3

THINNING AND TRIMMING FOR SIGNS
 132+37 LT

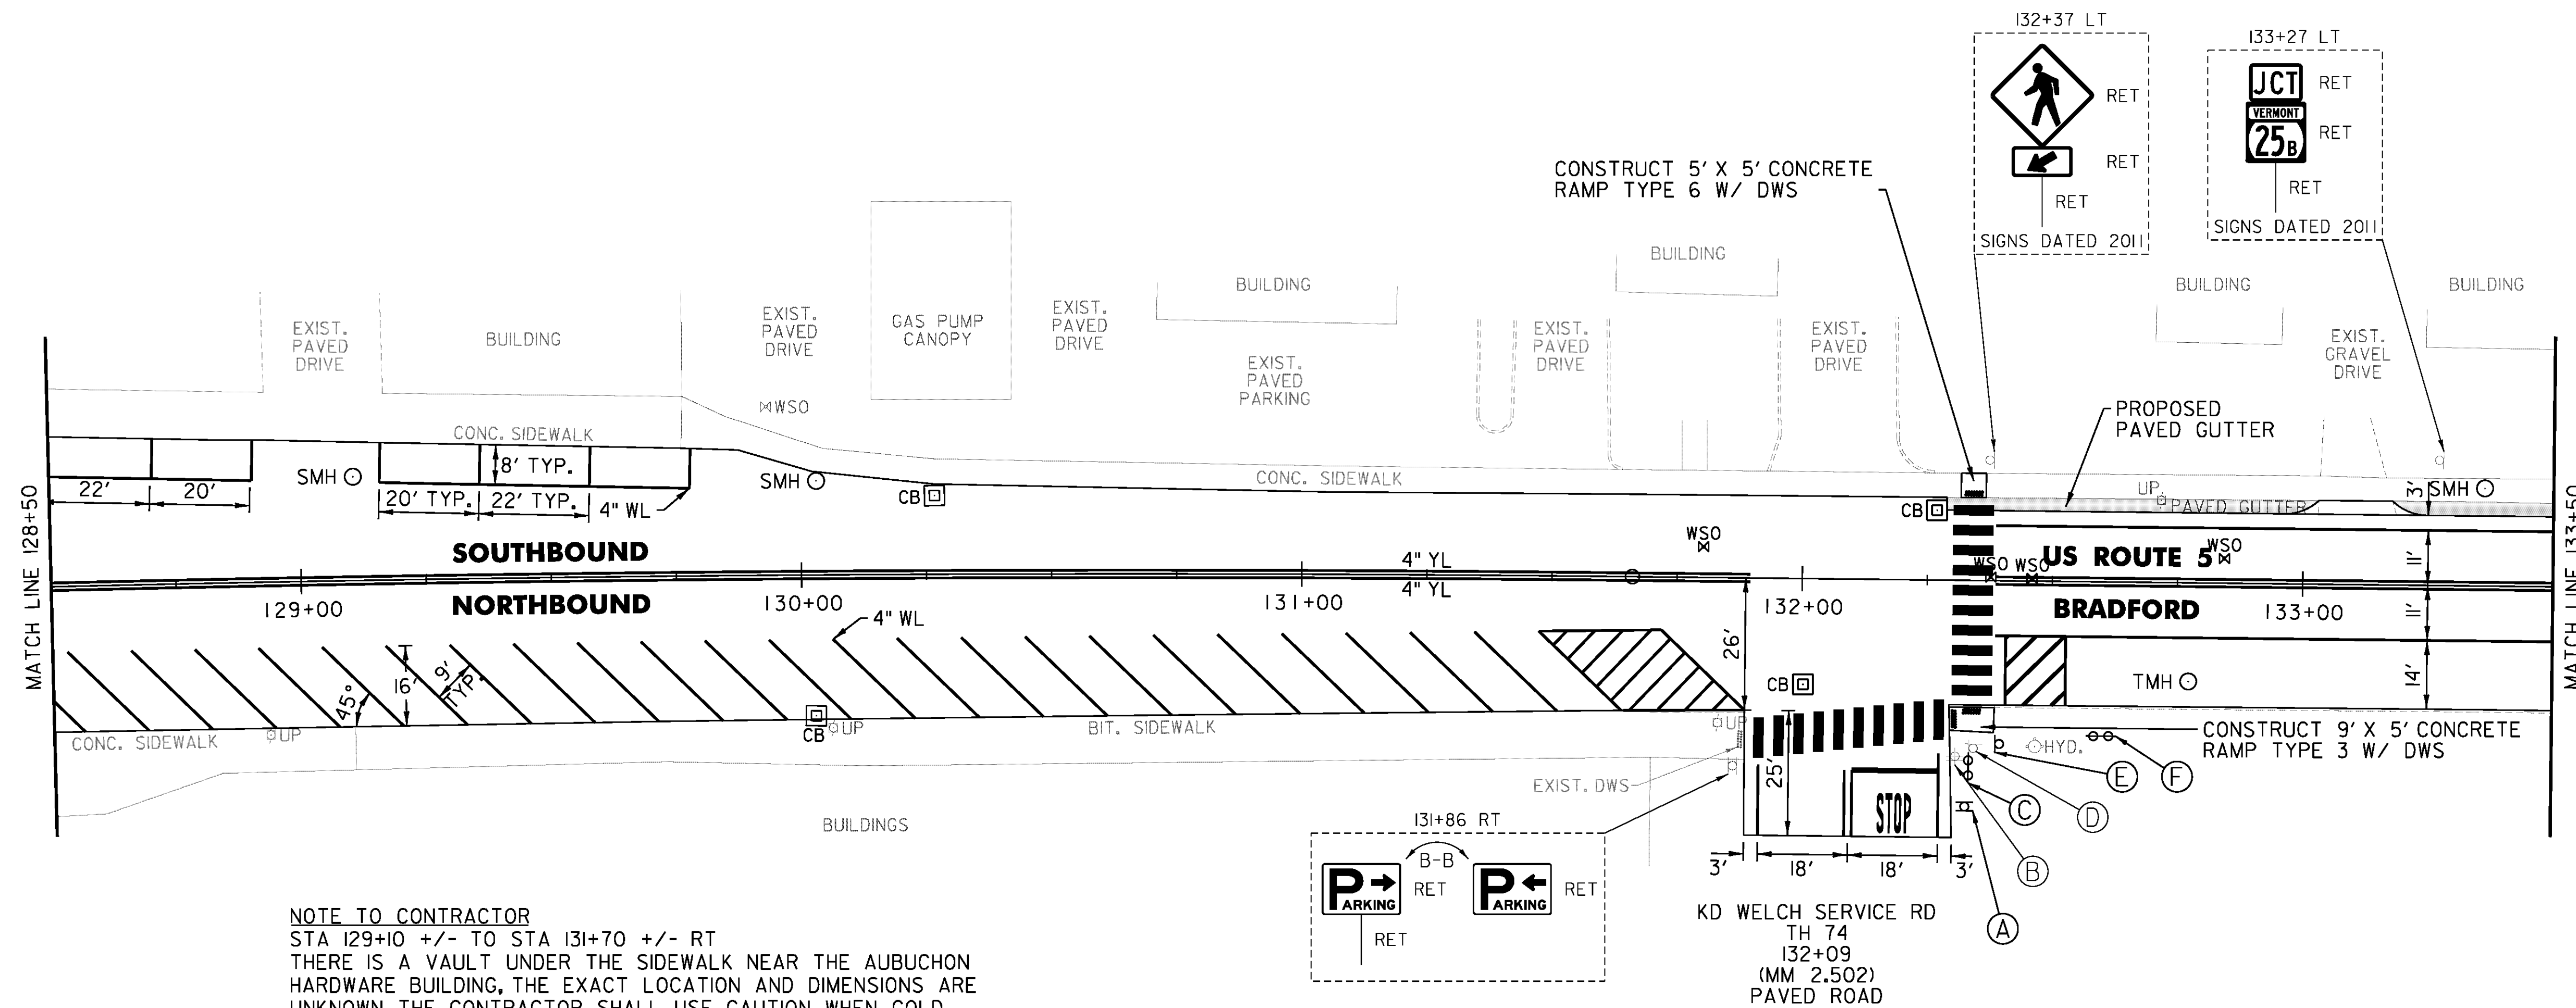

NOTE TO CONTRACTOR
 STA 129+10 +/- TO STA 131+70 +/- RT
 THERE IS A VAULT UNDER THE SIDEWALK NEAR THE AUBUCHON
 HARDWARE BUILDING, THE EXACT LOCATION AND DIMENSIONS ARE
 UNKNOWN. THE CONTRACTOR SHALL USE CAUTION WHEN COLD
 PLANING AND PAVING OPERATIONS OCCUR IN THIS AREA. SHOULD
 ANY DAMAGE OCCUR AS A RESULT OF THESE OPERATIONS IT WILL
 BE REPAIRED BY THE CONTRACTOR AT NO COST TO THE STATE.

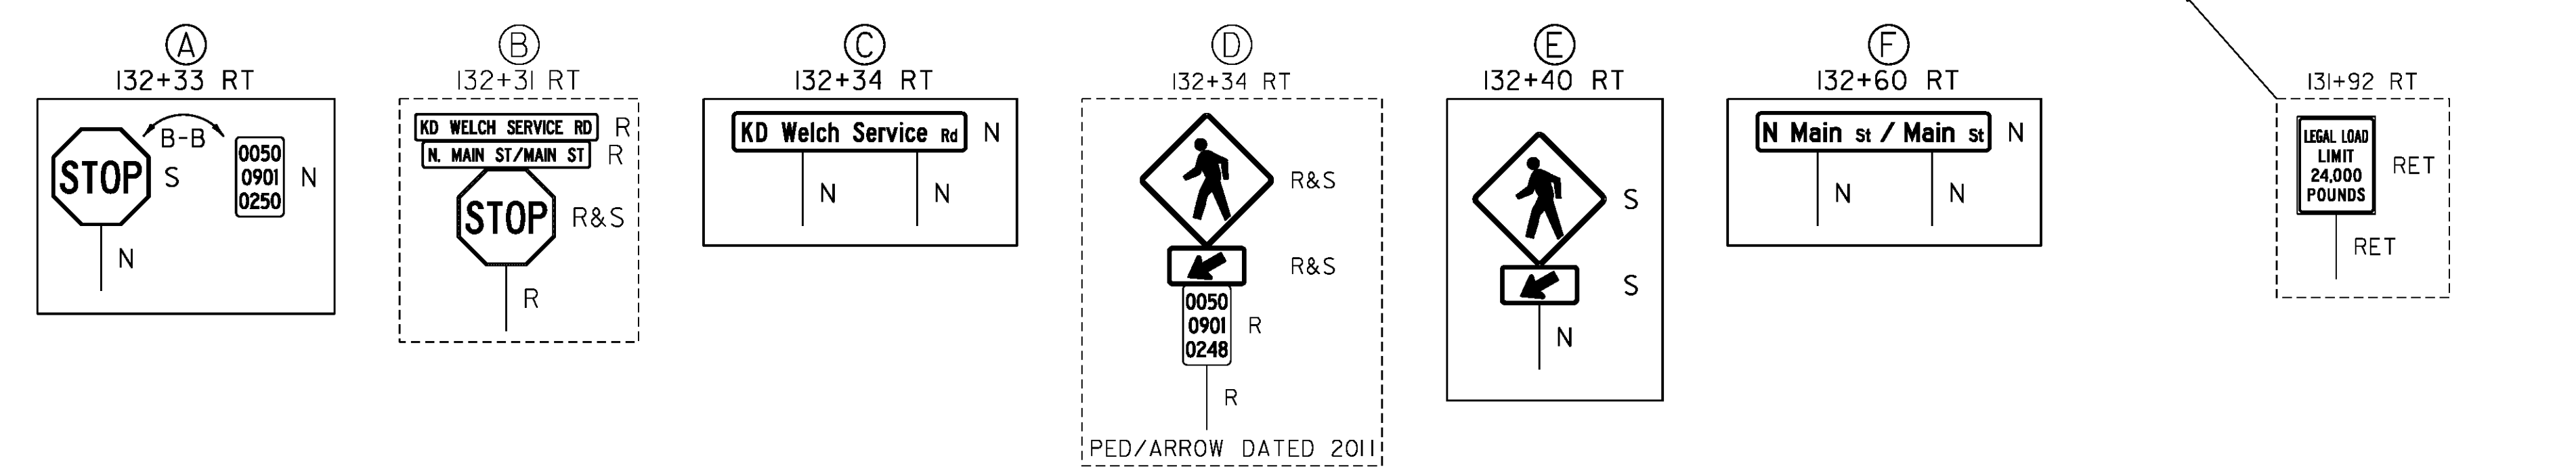

NOT TO SCALE

PROJECT NAME:	BRADFORD-RYEGATE
PROJECT NUMBER:	STP 2929(I)
FILE NAME:	z10c264bdr.dgn
PROJECT LEADER:	P. SHEDD
DESIGNED BY:	N. LEMAY
PLOT DATE:	2/4/2016
DRAWN BY:	W. GORDON
CHECKED BY:	P. SHEDD
US 5 PLAN SHEET 9	SHEET 67 OF 239

GLD 14-0278