

TEMPORARY 4 INCH WHITE LINE, PAINT  
 DURABLE 4 INCH WHITE LINE (OPTION ITEM)  
 133+50 TO 139+50 SOLID LT & RT  
 135+86 SOLID LT (NO PARKING)  
 135+98 SOLID LT (NO PARKING)  
 139+01 SOLID LT (NO PARKING)  
 139+13 SOLID LT (NO PARKING)

TEMPORARY 4 INCH YELLOW LINE, PAINT  
 DURABLE 4 INCH YELLOW LINE (OPTION ITEM)  
 133+50 TO 139+50 SOLID LT & RT

TEMPORARY 8 INCH WHITE LINE, PAINT  
 DURABLE 8 INCH WHITE LINE (OPTION ITEM)  
 135+86 TO 135+98 SOLID LT (NO PARKING)  
 139+01 TO 139+13 SOLID LT (NO PARKING)


BITUMINOUS CONCRETE  
 GUTTERS AND TRAFFIC ISLANDS  
 133+50 TO 133+70 LT  
 133+83 TO 134+16 LT  
 134+29 TO 134+85 LT  
 134+93 TO 136+37 LT

~~VERTICAL GRANITE CURB~~  
~~135+74 TO 135+94 RT~~

REHAB. DROP INLETS, CATCH BASINS,  
 OR MANHOLES, CLASS I, CLASS II  
 135+79 LT

REMOVING SIGNS  
 AS SHOWN - 1

**PAVED GUTTER**  
 REMOVE EXISTING PAVED GUTTER, PAID FOR UNDER  
 EXCAVATION OF SURFACES AND PAVEMENTS.  
 PLACE STONE FILL, TYPE 1 SEE DITCH CLEANING SHEET

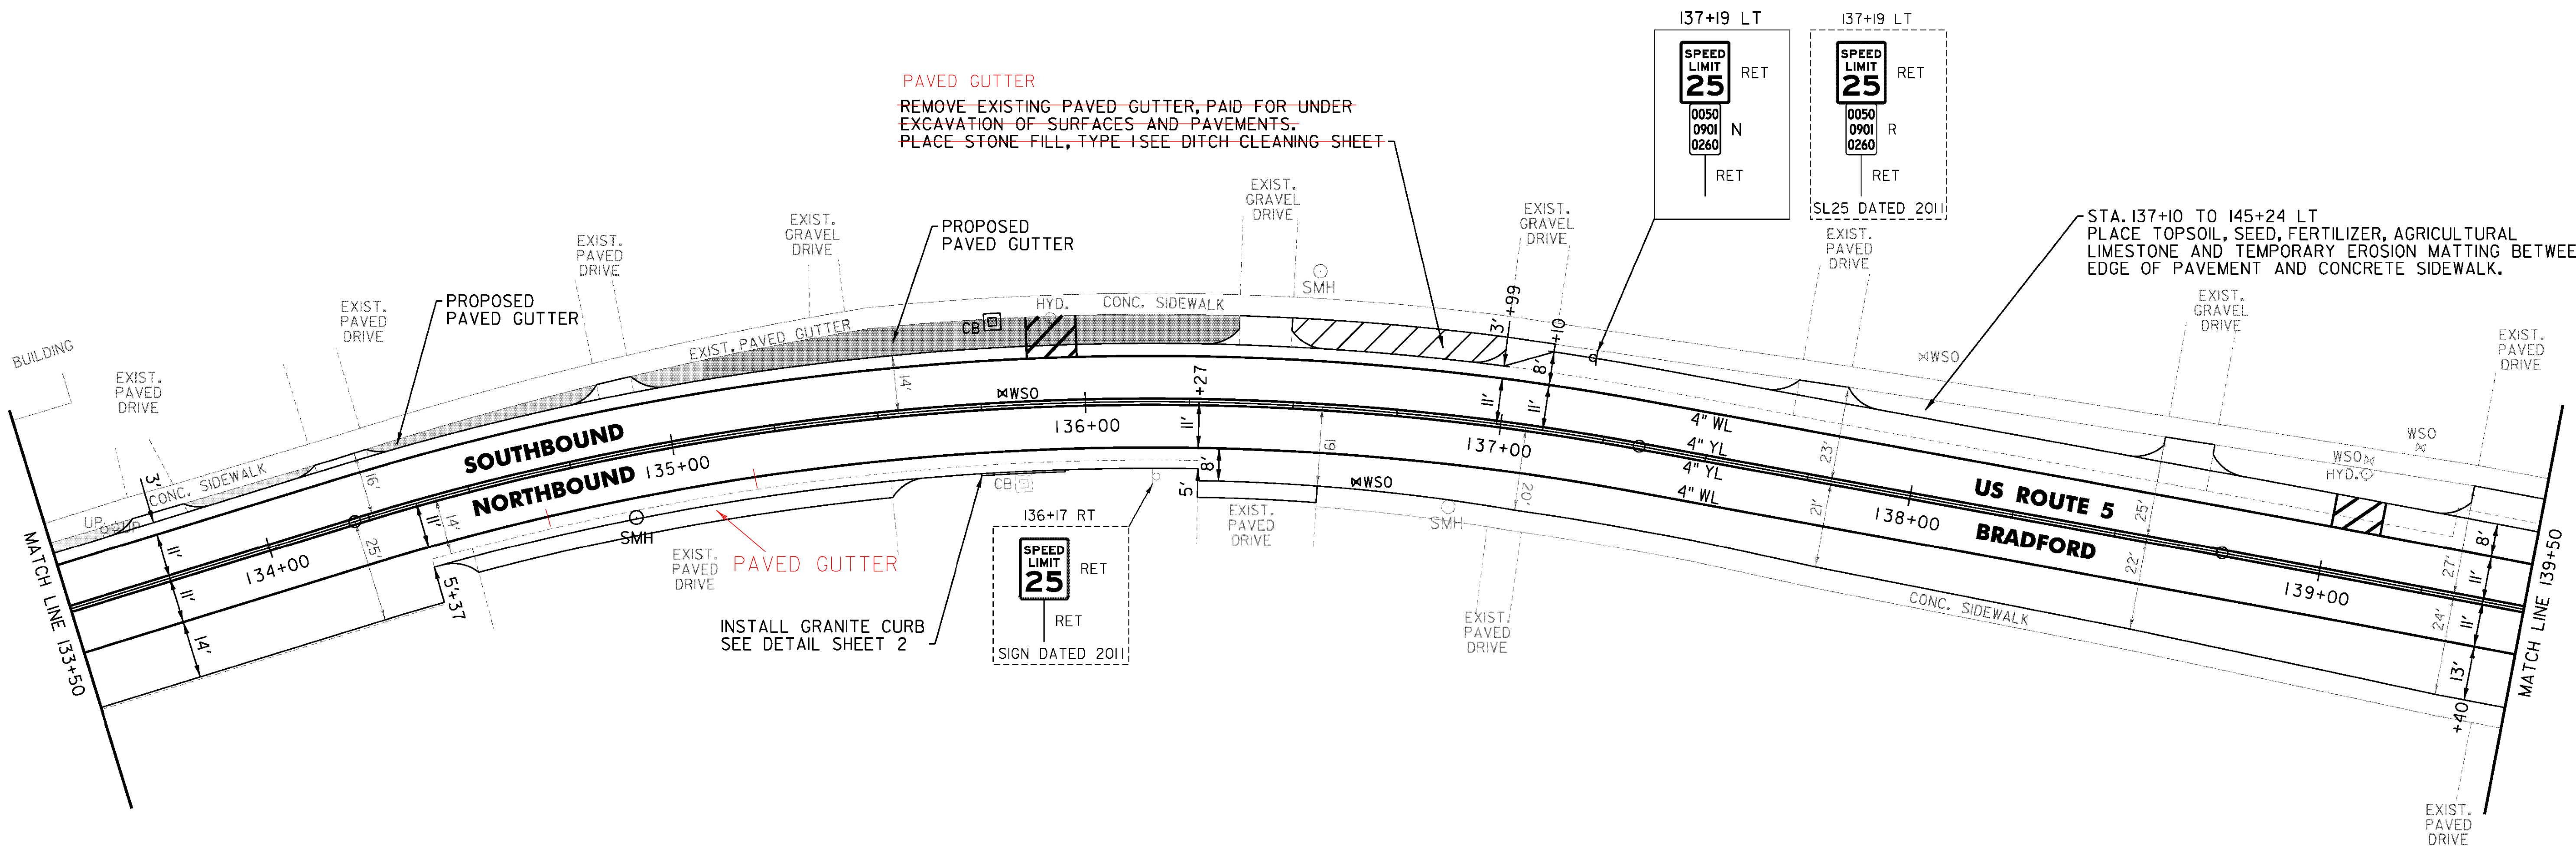

PROJECT NAME:	BRADFORD-RYEGATE
PROJECT NUMBER:	STP 2929(I)
FILE NAME:	z10c264bdr.dgn
PROJECT LEADER:	P. SHEDD
DESIGNED BY:	N. LEMAY
US 5 PLAN SHEET 10	
PLOT DATE:	2/4/2016
DRAWN BY:	W. GORDON
CHECKED BY:	P. SHEDD
SHEET	68 OF 239

NOT TO SCALE

CLD 14-0278