


TEMPORARY 4 INCH WHITE LINE, PAINT  
 DURABLE 4 INCH WHITE LINE (OPTION ITEM)  
 151+50 TO 152+28 SOLID LT  
 151+50 TO 154+44 SOLID RT  
 151+62 SOLID RT (NO PARKING)  
 151+74 SOLID RT (NO PARKING)  
 152+28 TO 152+67 SOLID LT (TH 69)  
 152+71 TO 152+79 SOLID LT (TH 69)  
 153+08 TO 153+11 SOLID LT (TH 69)  
 153+14 TO 153+55 SOLID LT (TH 69)  
 153+55 TO 157+50 SOLID LT  
 154+44 TO 154+99 SOLID RT (TH 66)  
 155+34 TO 155+60 SOLID RT (TH 66)  
 155+60 TO 157+50 SOLID RT  
 157+00 TO 157+50 DOTTED RT (LANE LINE)

TEMPORARY 4 INCH YELLOW LINE, PAINT  
 DURABLE 4 INCH YELLOW LINE (OPTION ITEM)  
 151+50 TO 152+72 SOLID LT & RT  
 152+93 DOUBLE SOLID LT (TH 69)  
 153+12 TO 154+85 SOLID LT & RT  
 155+11 TO 155+15 DOUBLE SOLID RT (TH 66)  
 155+15 RT DOUBLE SOLID RT (TH 66)  
 155+25 TO 157+50 SOLID LT & RT  
 155+25 TO 157+50 DOUBLE SOLID RT  
 TEMPORARY 8 INCH WHITE LINE, PAINT  
 DURABLE 8 INCH WHITE LINE (OPTION ITEM)  
 151+62 TO 151+74 SOLID RT (NO PARKING)  
 DURABLE 8 INCH YELLOW LINE (OPTION ITEM)  
 155+35 TO 157+50 RT (DIAGONALS)

TEMPORARY 24 INCH STOP BAR, PAINT  
 DURABLE 24 INCH STOP BAR (OPTION ITEM)  
 152+75 TO 152+93 LT (TH 69)  
 155+12 TO 155+44 RT (TH 66)  
 TEMPORARY LETTER OR SYMBOL, PAINT  
 DURABLE LETTER OR SYMBOL (OPTION ITEM)  
 152+85 LT \*STOP\* (TH 69)  
 155+25 RT \*STOP\* (TH 66)  
 TEMPORARY CROSSWALK MARKING, PAINT  
 DURABLE CROSSWALK MARKING (OPTION ITEM)  
 152+68 TO 153+16 LT  
 REHAB. DROP INLETS, CATCH BASINS,  
 OR MANHOLES, CLASS I, CLASS II  
 151+78 LT  
 152+66 LT  
 153+18 LT  
 154+58 LT  
 155+71 LT  
 156+50 RT  
 156+96 LT

STEEL BEAM GUARDRAIL, GALVANIZED  
 155+80 TO 156+17.5 RT  
 ANCHOR FOR STEEL BEAM RAIL  
 1 (SEE STANDARD G-1d)  
 REMOVAL AND DISPOSAL OF GUARDRAIL  
 155+80 TO 156+17.5 RT  
 DELINEATOR WITH STEEL POST  
 155+80 RT  
 BITUMINOUS CONCRETE  
 GUTTERS AND TRAFFIC ISLANDS  
 153+08 TO 153+19 LT (TH 69)  
 PORTLAND CEMENT  
 CONCRETE SIDEWALK, 5 INCH  
 152+55 TO 152+68 LT (RAMP TYPE 1)  
 153+12 TO 153+24 LT (RAMP TYPE 6)  
 DETECTABLE WARNING SURFACE (DWS)  
 152+66 LT  
 153+16 LT  
 REMOVING SIGNS  
 AS SHOWN - 11  
 ERECTING SALVAGED SIGNS  
 AS SHOWN - 2

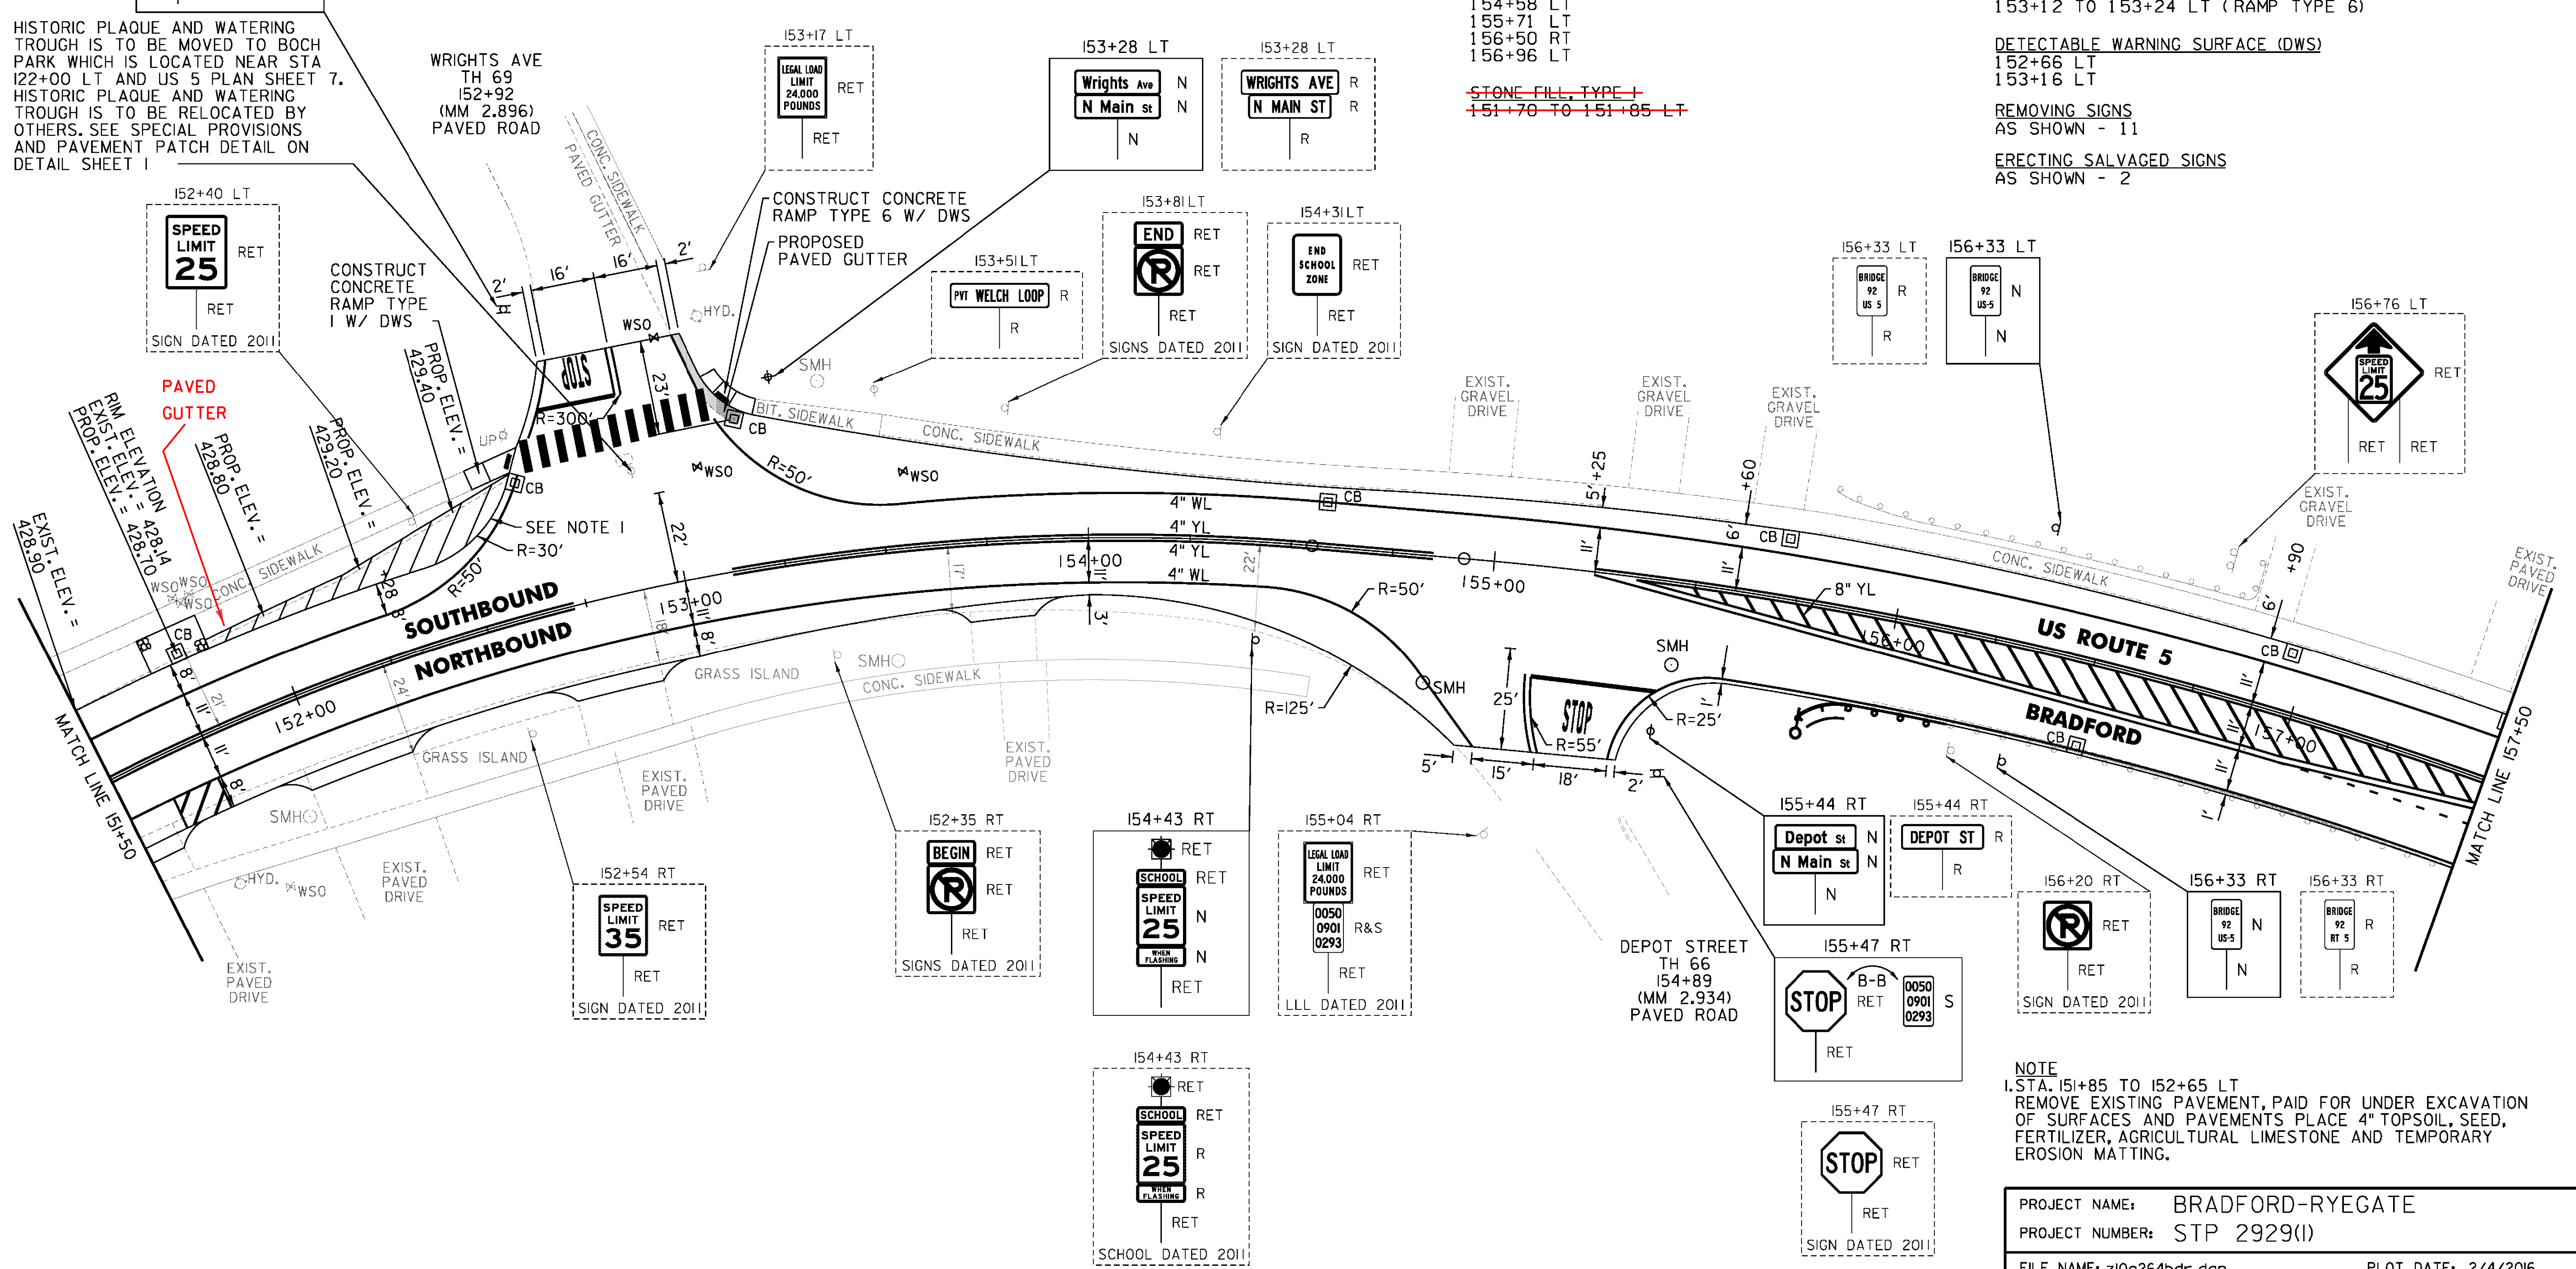

HISTORIC PLAQUE AND WATERING TROUGH IS TO BE MOVED TO BOCH PARK WHICH IS LOCATED NEAR STA 122+00 LT AND US 5 PLAN SHEET 7. HISTORIC PLAQUE AND WATERING TROUGH IS TO BE RELOCATED BY OTHERS. SEE SPECIAL PROVISIONS AND PAVEMENT PATCH DETAIL ON DETAIL SHEET 1

~~STONE FILL, TYPE 1~~  
~~151+70 TO 151+85 LT~~

NOTE  
 I. STA. 151+85 TO 152+65 LT  
 REMOVE EXISTING PAVEMENT, PAID FOR UNDER EXCAVATION OF SURFACES AND PAVEMENTS PLACE 4" TOPSOIL, SEED, FERTILIZER, AGRICULTURAL LIMESTONE AND TEMPORARY EROSION MATTING.

PROJECT NAME:	BRADFORD-RYEGATE	PLOT DATE:	2/4/2016
PROJECT NUMBER:	STP 2929(1)	DRAWN BY:	W. GORDON
FILE NAME:	z10c264bdr.dgn	DESIGNED BY:	N. LEMAY
		CHECKED BY:	P. SHEDD
		US 5 PLAN SHEET 13	SHEET 71 OF 239

NOT TO SCALE