

TEMPORARY 4 INCH WHITE LINE, PAINT
 DURABLE 4 INCH WHITE LINE (OPTION ITEM)
 204+50 TO 205+46 SOLID LT
 204+50 TO 210+50 SOLID RT
 205+46 TO 205+75 SOLID LT (TH 56)
 205+98 TO 206+22 SOLID LT (TH 56)
 206+22 TO 210+50 SOLID LT


TEMPORARY 4 INCH YELLOW LINE, PAINT
 DURABLE 4 INCH YELLOW LINE (OPTION ITEM)
 204+50 TO 205+66 SOLID LT & RT
 205+86 TO 205+87 DOUBLE SOLID LT (TH 56)
 206+06 TO 210+50 SOLID LT & RT

TEMPORARY 24 INCH STOP BAR, PAINT
 DURABLE 24 INCH STOP BAR (OPTION ITEM)
 205+66 TO 205+85 LT (TH 56)

TEMPORARY LETTER OR SYMBOL, PAINT
 DURABLE LETTER OR SYMBOL (OPTION ITEM)
 205+79 LT * STOP* (TH 56)

REMOVING SIGNS
 AS SHOWN - 1

THINNING AND TRIMMING FOR SIGNS
 206+07 LT

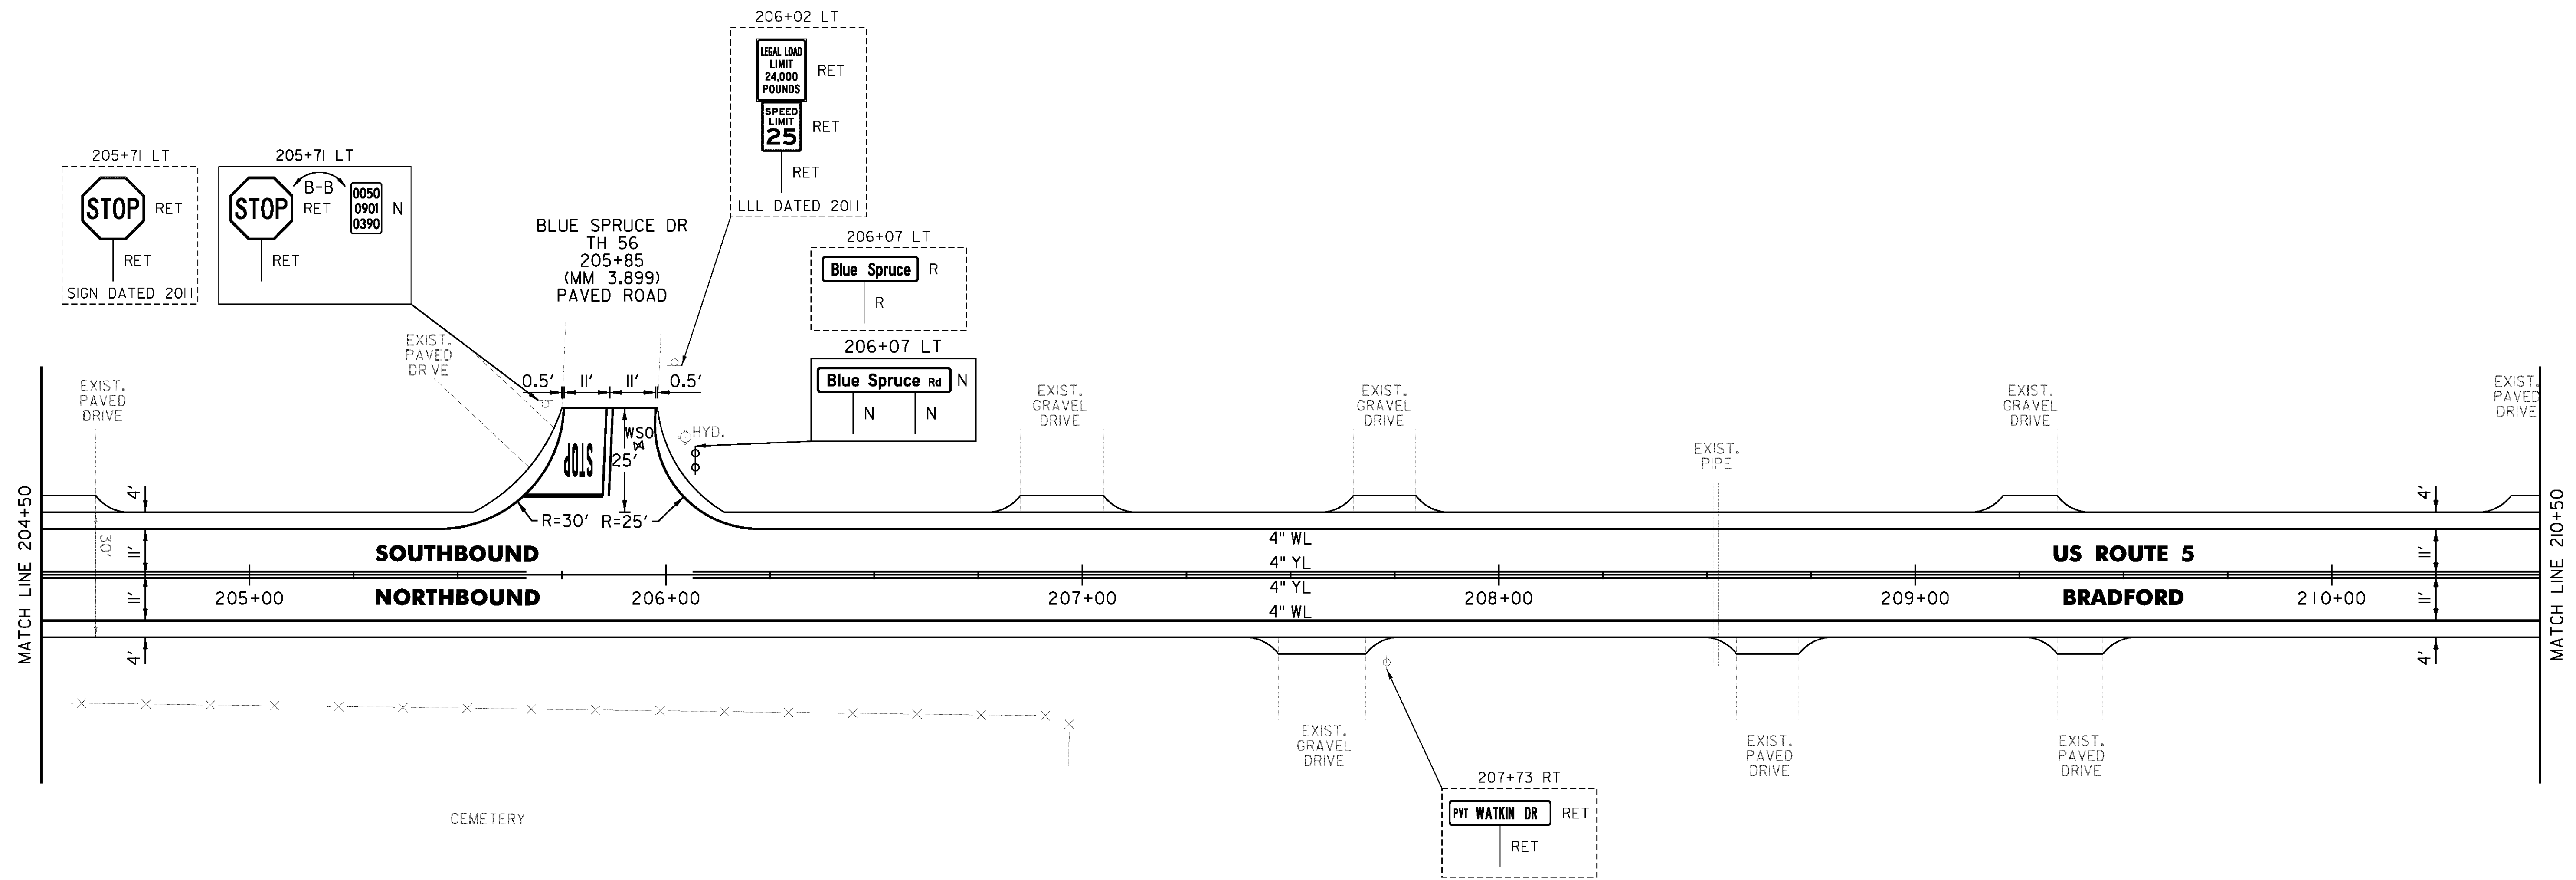

NOT TO SCALE

PROJECT NAME: BRADFORD-RYEGATE	PLOT DATE: 2/4/2016
PROJECT NUMBER: STP 2929(I)	DRAWN BY: W. GORDON
FILE NAME: z10c264bdr.dgn	CHECKED BY: P. SHEDD
PROJECT LEADER: P. SHEDD	SHEET 80 OF 239
DESIGNED BY: N. LEMAY	
US 5 PLAN SHEET 22	