

TEMPORARY 4 INCH WHITE LINE, PAINT
 DURABLE 4 INCH WHITE LINE (OPTION ITEM)
 246+50 TO 252+50 SOLID LT & RT

TEMPORARY 4 INCH YELLOW LINE, PAINT
 DURABLE 4 INCH YELLOW LINE, EPOXY PAINT OR
 DURABLE 4 INCH YELLOW LINE, POLYUREA (OPTION ITEM)
 246+50 TO 252+40 SOLID LT & RT
 252+40 TO 252+50 SOLID LT, DASHED RT

STEEL BEAM GUARDRAIL, GALVANIZED
 246+50 TO 247+90 LT
 249+91.5 TO 250+28.5 RT
 250+70 TO 251+07.5 RT

ANCHOR FOR STEEL BEAM RAIL
 3' (SEE STANDARD G-1d)


REMOVAL AND DISPOSAL OF GUARDRAIL
 246+50 TO 247+89 LT
 249+91.5 TO 250+28.5 RT
 250+70 TO 251+07.5 RT

DELINEATOR WITH STEEL POST
 247+90 LT
 250+28.5 RT
 250+70 RT

REMOVE AND RESET GUARDRAIL
 246+50 TO 249+91.5 RT
 251+07.5 TO 252+50 RT

MILLED RUMBLE STRIPS
 246+50 TO 252+50 CL

REMOVING SIGNS
 AS SHOWN - 2

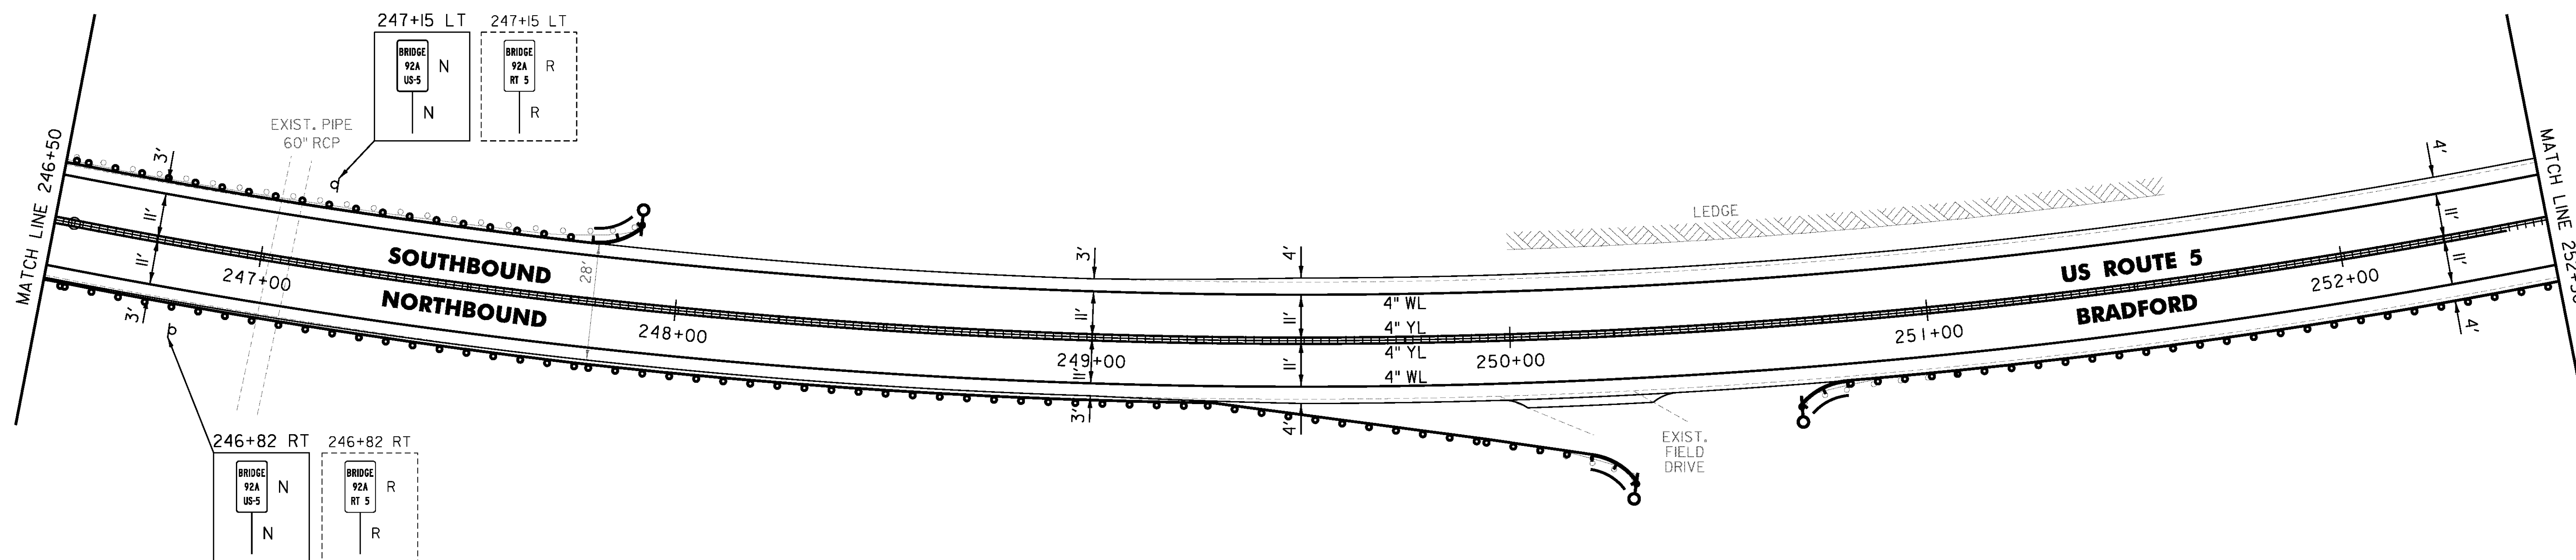

CLD 14-0278

NOT TO SCALE

PROJECT NAME: BRADFORD-RYEGATE	
PROJECT NUMBER: STP 2929(I)	
FILE NAME: z10c264bdr.dgn	PLOT DATE: 2/4/2016
PROJECT LEADER: P. SHEDD	DRAWN BY: W. GORDON
DESIGNED BY: N. LEMAY	CHECKED BY: P. SHEDD
US 5 PLAN SHEET 29	SHEET 87 OF 239