

TEMPORARY 4 INCH WHITE LINE, PAINT
 DURABLE 4 INCH WHITE LINE (OPTION ITEM)
 252+50 TO 258+50 SOLID LT & RT

TEMPORARY 4 INCH YELLOW LINE, PAINT
 DURABLE 4 INCH YELLOW LINE, EPOXY PAINT OR
 DURABLE 4 INCH YELLOW LINE, POLYUREA (OPTION ITEM)
 252+50 TO 258+50 SOLID LT, DASHED RT

STEEL BEAM GUARDRAIL, GALVANIZED
 253+07 TO 253+44.5 LT
 258+02.5 LT (12.5')
 258+20 TO 258+50 RT

ANCHOR FOR STEEL BEAM RAIL
 1' (SEE STANDARD G-1d)

REMOVAL AND DISPOSAL OF GUARDRAIL
 253+07 TO 253+44.5 LT
 257+94.5 TO 258+00 LT
 258+20 TO 258+50 RT


DELINEATOR WITH STEEL POST
 253+07 LT
 257+94.5 LT

SPECIAL PROVISION (STEEL BEAM
 GUARDRAIL GALVANIZED) (8 FEET RADIUS)
 257+94.5 LT

REMOVE AND RESET GUARDRAIL
 252+50 TO 258+20 RT
 253+44.5 TO 257+94.5 LT

MILLED RUMBLE STRIPS
 252+50 TO 258+50 CL

REMOVING SIGNS
 AS SHOWN - 1

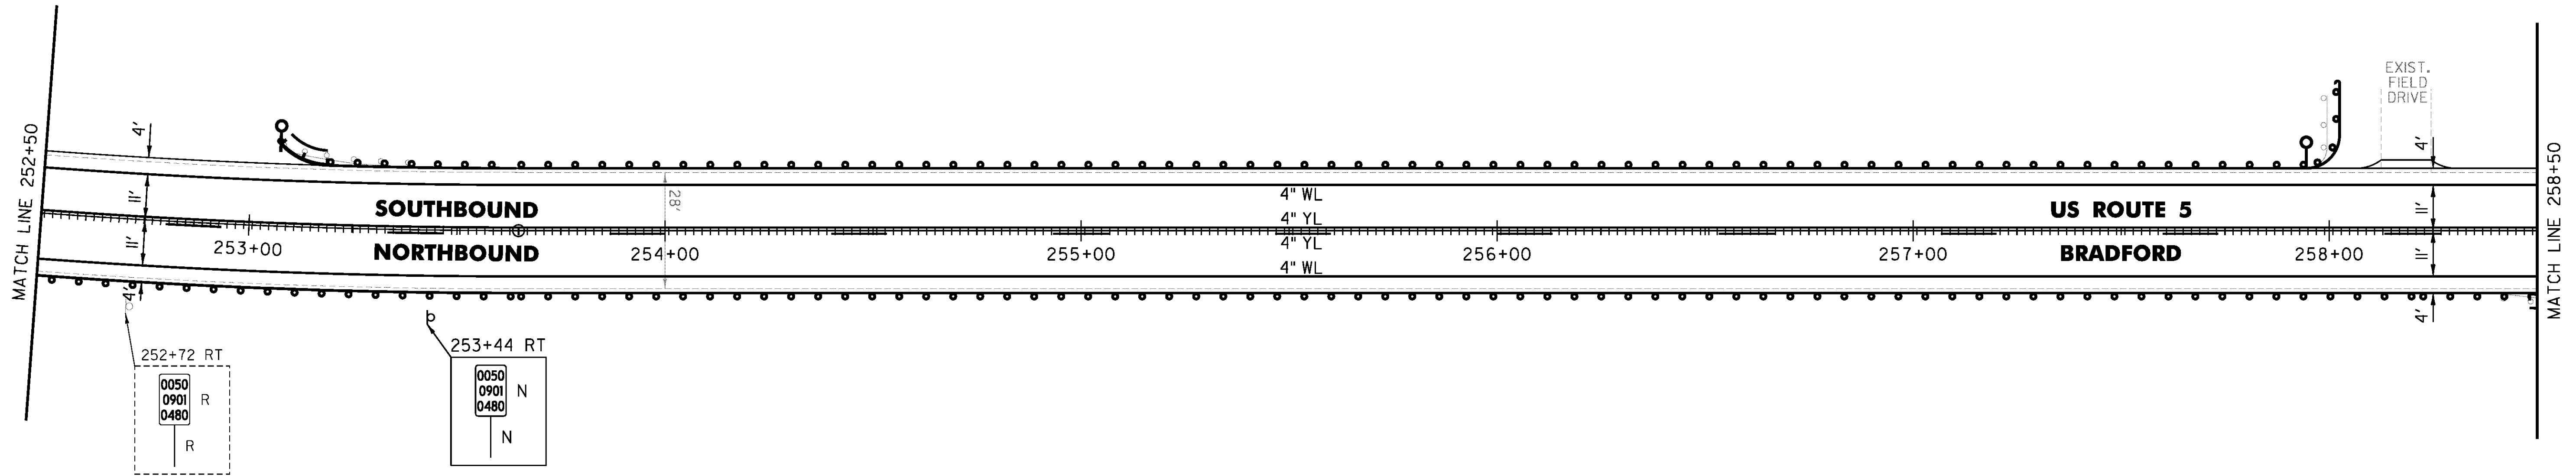

NOT TO SCALE

PROJECT NAME: BRADFORD-RYEGATE	PLOT DATE: 2/4/2016
PROJECT NUMBER: STP 2929(I)	DRAWN BY: W. GORDON
FILE NAME: z10c264bdr.dgn	CHECKED BY: P. SHEDD
PROJECT LEADER: P. SHEDD	SHEET 88 OF 239
DESIGNED BY: N. LEMAY	
US 5 PLAN SHEET 30	