

TEMPORARY 4 INCH WHITE LINE, PAINT
 DURABLE 4 INCH WHITE LINE (OPTION ITEM)
 258+50 TO 264+50 SOLID LT & RT

TEMPORARY 4 INCH YELLOW LINE, PAINT
 DURABLE 4 INCH YELLOW LINE, EPOXY PAINT OR
 DURABLE 4 INCH YELLOW LINE, POLYUREA (OPTION ITEM)
 258+50 TO 260+30 SOLID LT, DASHED RT
 260+30 TO 264+50 DASHED CL

STEEL BEAM GUARDRAIL, GALVANIZED
 258+50 TO 258+57.5 RT
 263+04.5 TO 263+42 LT
 263+70.5 TO 264+08 RT

ANCHOR FOR STEEL BEAM RAIL
 3' (SEE STANDARD G-1d)


REMOVAL AND DISPOSAL OF GUARDRAIL
 258+50 TO 258+57.5 RT
 263+04.5 TO 263+42 LT
 263+70.5 TO 264+08 RT

DELINEATOR WITH STEEL POST
 258+57.5 RT
 263+04.5 LT
 263+70.5 RT

REMOVE AND RESET GUARDRAIL
 263+42 TO 264+50 LT
 264+08 TO 264+50 RT

MILLED RUMBLE STRIPS
 258+50 TO 264+50 CL

REMOVING SIGNS
 AS SHOWN - 1

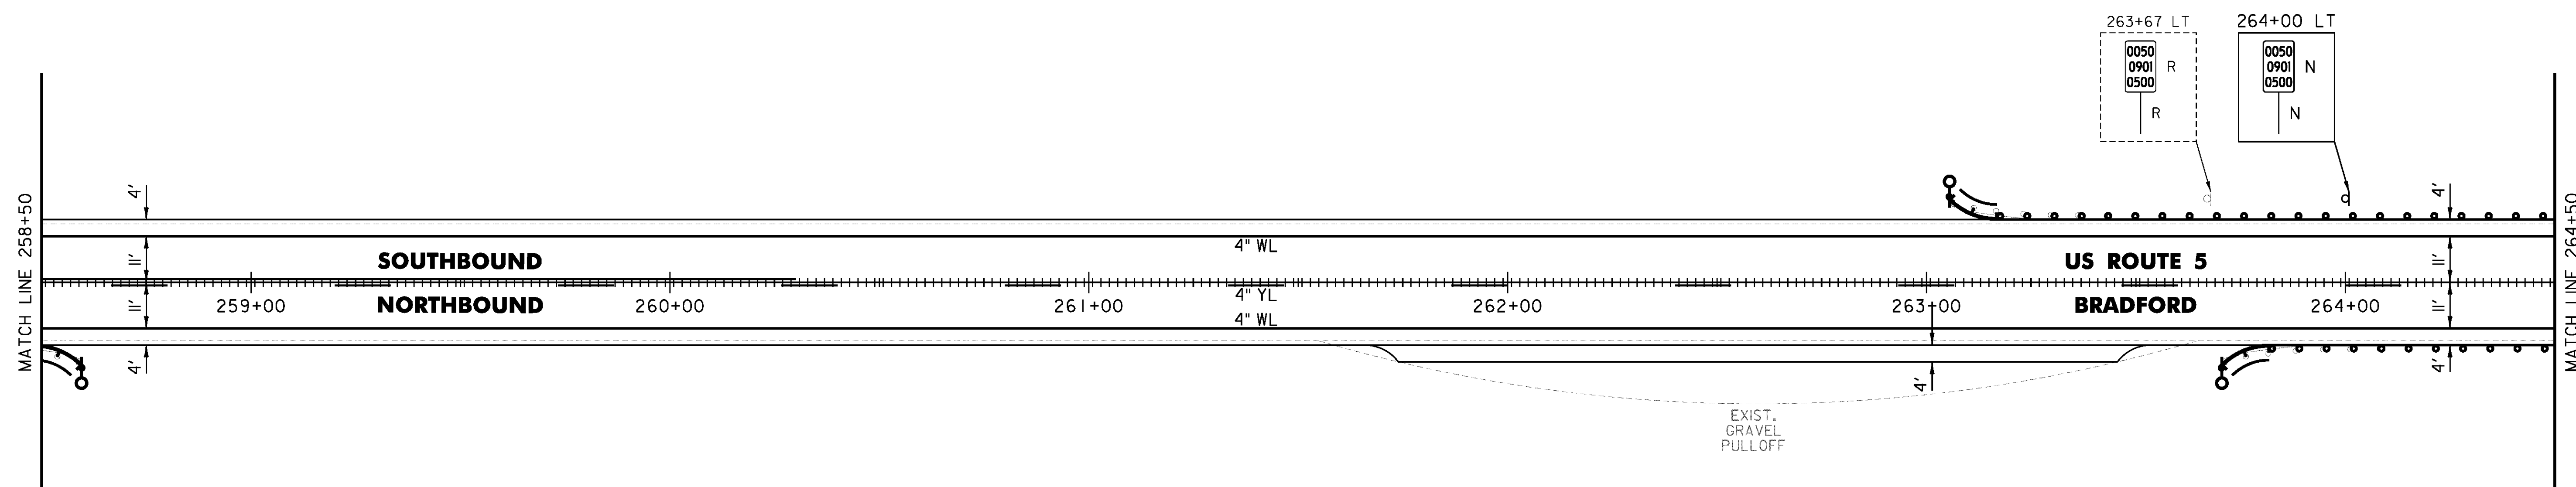

CLD 14-0278

NOT TO SCALE

PROJECT NAME: BRADFORD-RYEGATE	PLOT DATE: 2/4/2016
PROJECT NUMBER: STP 2929(I)	DRAWN BY: W. GORDON
FILE NAME: z10c264bdr.dgn	CHECKED BY: P. SHEDD
PROJECT LEADER: P. SHEDD	SHEET 89 OF 239
DESIGNED BY: N. LEMAY	
US 5 PLAN SHEET 31	