

TEMPORARY 4 INCH WHITE LINE, PAINT
 DURABLE 4 INCH WHITE LINE (OPTION ITEM)
 275+50 TO 276+39 SOLID LT
 275+50 TO 281+50 SOLID RT
 276+39 TO 276+69 SOLID LT (TH 17)
 276+91 TO 277+17 SOLID LT (TH 17)
 277+17 TO 281+50 SOLID LT

TEMPORARY 4 INCH YELLOW LINE, PAINT
 275+50 TO 276+58 DASHED LT, SOLID RT
 276+78 TO 276+81 DOUBLE SOLID LT (TH 17)
 276+98 TO 281+50 SOLID LT & RT

DURABLE 4 INCH YELLOW LINE (OPTION ITEM)
 276+78 TO 276+81 DOUBLE SOLID LT (TH 17)

DURABLE 4 INCH YELLOW LINE, EPOXY PAINT OR
 DURABLE 4 INCH YELLOW LINE, POLYUREA (OPTION ITEM)
 275+50 TO 276+58 DASHED LT, SOLID RT
 276+98 TO 281+50 SOLID LT & RT

TEMPORARY 24 INCH STOP BAR, PAINT
 DURABLE 24 INCH STOP BAR (OPTION ITEM)
 276+55 TO 276+77 LT (TH 17)

TEMPORARY LETTER OR SYMBOL, PAINT
 DURABLE LETTER OR SYMBOL (OPTION ITEM)
 276+71 LT 'STOP' (TH 17)

STEEL BEAM GUARDRAIL, GALVANIZED

275+92 TO 276+29.5 LT
 277+20.5 TO 277+58 LT
 277+33 TO 277+83 RT
 278+85.5 TO 279+10.5 RT

GUARDRAIL APPROACH SECTION,
 GALV HD STEEL BEAM
 277+58 TO 277+83 RT
 278+60.5 TO 278+85.5 RT

ANCHOR FOR STEEL BEAM RAIL
 2 (SEE STANDARD G-1d)

REMOVAL AND DISPOSAL OF GUARDRAIL

275+92 TO 276+29.5 LT
 277+20.5 TO 277+58 LT
 277+33 TO 277+83 RT
 278+60.5 TO 279+10.5 RT

DELINEATOR WITH STEEL POST

276+29.5 LT
 277+20.5 LT
 278+95 LT

REMOVE AND RESET GUARDRAIL


275+50 TO 275+92 LT
 275+50 TO 277+33 RT
 279+10.5 TO 281+50 RT

MILLED RUMBLE STRIPS

275+50 TO 276+58 CL
 276+98 TO 281+50 CL

REMOVING SIGNS

AS SHOWN - 4

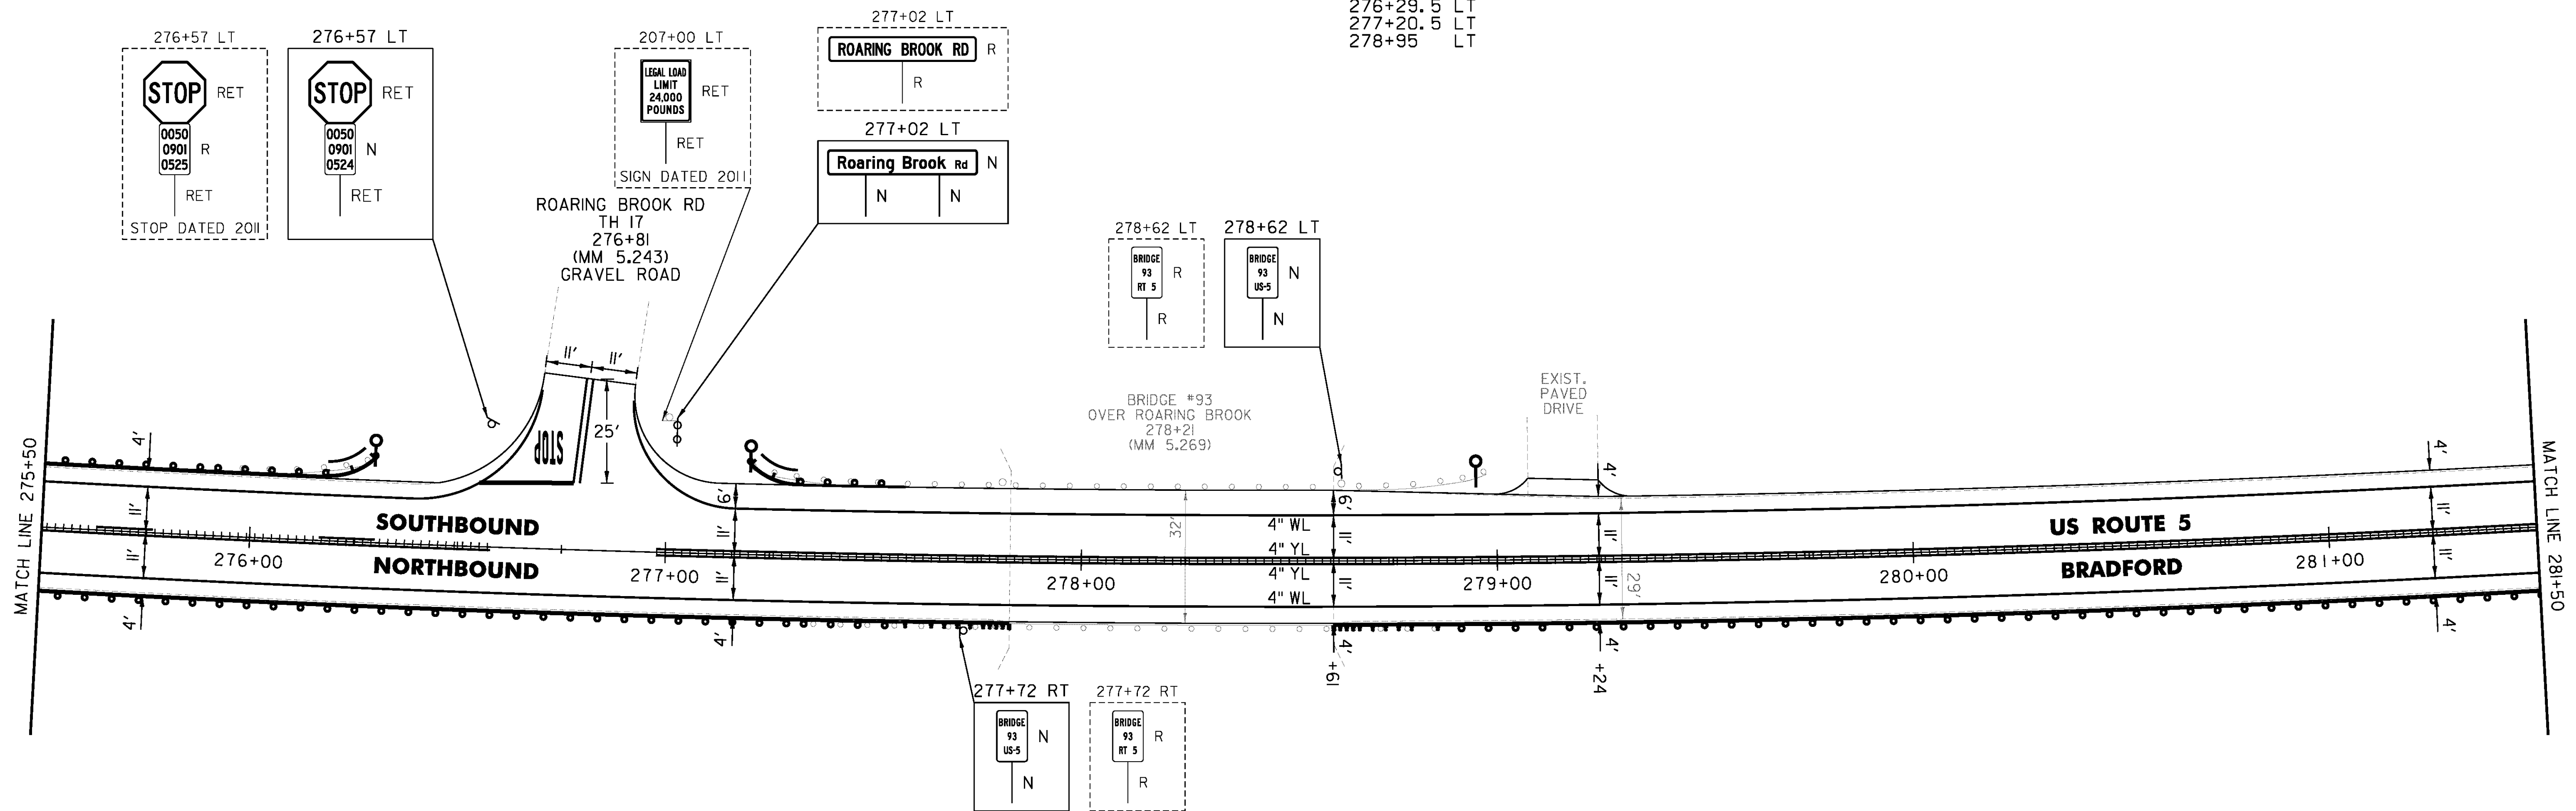

GLD 14-0278

NOT TO SCALE

PROJECT NAME: BRADFORD-RYEGATE	PLOT DATE: 2/4/2016
PROJECT NUMBER: STP 2929(I)	DRAWN BY: W. GORDON
FILE NAME: z10c264bdr.dgn	CHECKED BY: P. SHEDD
PROJECT LEADER: P. SHEDD	SHEET 92 OF 239
DESIGNED BY: N. LEMAY	
US 5 PLAN SHEET 34	