

TEMPORARY 4 INCH WHITE LINE, PAINT
 DURABLE 4 INCH WHITE LINE (OPTION ITEM)
 281+50 TO 287+50 SOLID LT & RT

TEMPORARY 4 INCH YELLOW LINE, PAINT
 DURABLE 4 INCH YELLOW LINE, EPOXY PAINT OR
 DURABLE 4 INCH YELLOW LINE, POLYUREA (OPTION ITEM)
 281+50 TO 283+50 SOLID LT & RT
 283+50 TO 287+50 SOLID LT, DASHED RT

STEEL BEAM GUARDRAIL, GALVANIZED
 282+32.5 TO 282+70 LT

ANCHOR FOR STEEL BEAM RAIL
 1' (SEE STANDARD G-1d)


REMOVAL AND DISPOSAL OF GUARDRAIL
 282+32.5 TO 282+70 LT

DELINEATOR WITH STEEL POST
 282+32.5 LT

REMOVE AND RESET GUARDRAIL
 281+50 TO 287+50 RT
 282+70 TO 287+50 LT

MILLED RUMBLE STRIPS
 281+50 TO 287+50 CL

REMOVING SIGNS
 AS SHOWN - 3

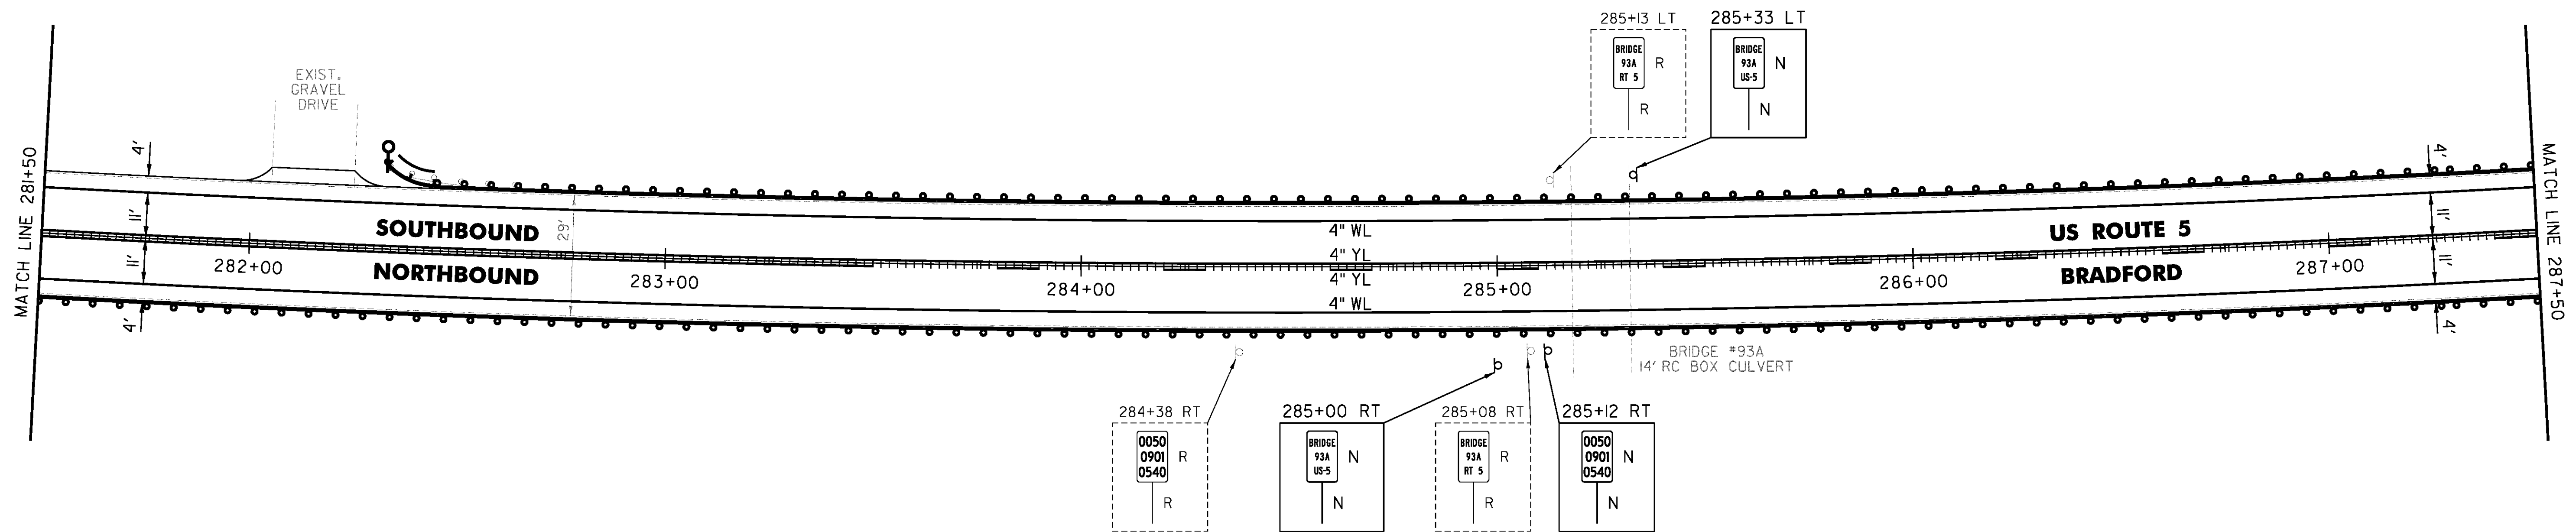

NOT TO SCALE

| | |
|--------------------------------|----------------------|
| PROJECT NAME: BRADFORD-RYEGATE | |
| PROJECT NUMBER: STP 2929(I) | |
| FILE NAME: z10c264bdr.dgn | PLOT DATE: 2/4/2016 |
| PROJECT LEADER: P. SHEDD | DRAWN BY: W. GORDON |
| DESIGNED BY: N. LEMAY | CHECKED BY: P. SHEDD |
| US 5 PLAN SHEET 35 | SHEET 93 OF 239 |