

TEMPORARY 4 INCH WHITE LINE, PAINT
 DURABLE 4 INCH WHITE LINE (OPTION ITEM)
 293+50 TO 295+04 SOLID LT
 293+50 TO 299+50 SOLID RT
 295+84 TO 299+50 SOLID LT

TEMPORARY 4 INCH YELLOW LINE, PAINT
 DURABLE 4 INCH YELLOW LINE, EPOXY PAINT OR
 DURABLE 4 INCH YELLOW LINE, POLYUREA (OPTION ITEM)
 293+50 TO 295+24 DASHED LT, SOLID RT
 295+64 TO 299+50 SOLID LT & RT

STEEL BEAM GUARDRAIL, GALVANIZED
 294+57.5 TO 294+95 LT
 294+85.5 TO 295+23 RT


ANCHOR FOR STEEL BEAM RAIL
 2' (SEE STANDARD G-1d)
 REMOVAL AND DISPOSAL OF GUARDRAIL
 294+57.5 TO 294+95 LT
 294+85.5 TO 295+23 RT

DELINEATOR WITH STEEL POST
 294+95 LT
 295+23 RT

REMOVE AND RESET GUARDRAIL
 293+50 TO 294+85.5 RT
 293+50 TO 294+57.5 LT

MILLED RUMBLE STRIPS
 293+50 TO 295+24 CL
 295+64 TO 299+50 CL

GRUBBING MATERIAL (6")
 STONE FILL, TYPE I
 294+00 TO 294+30 LT

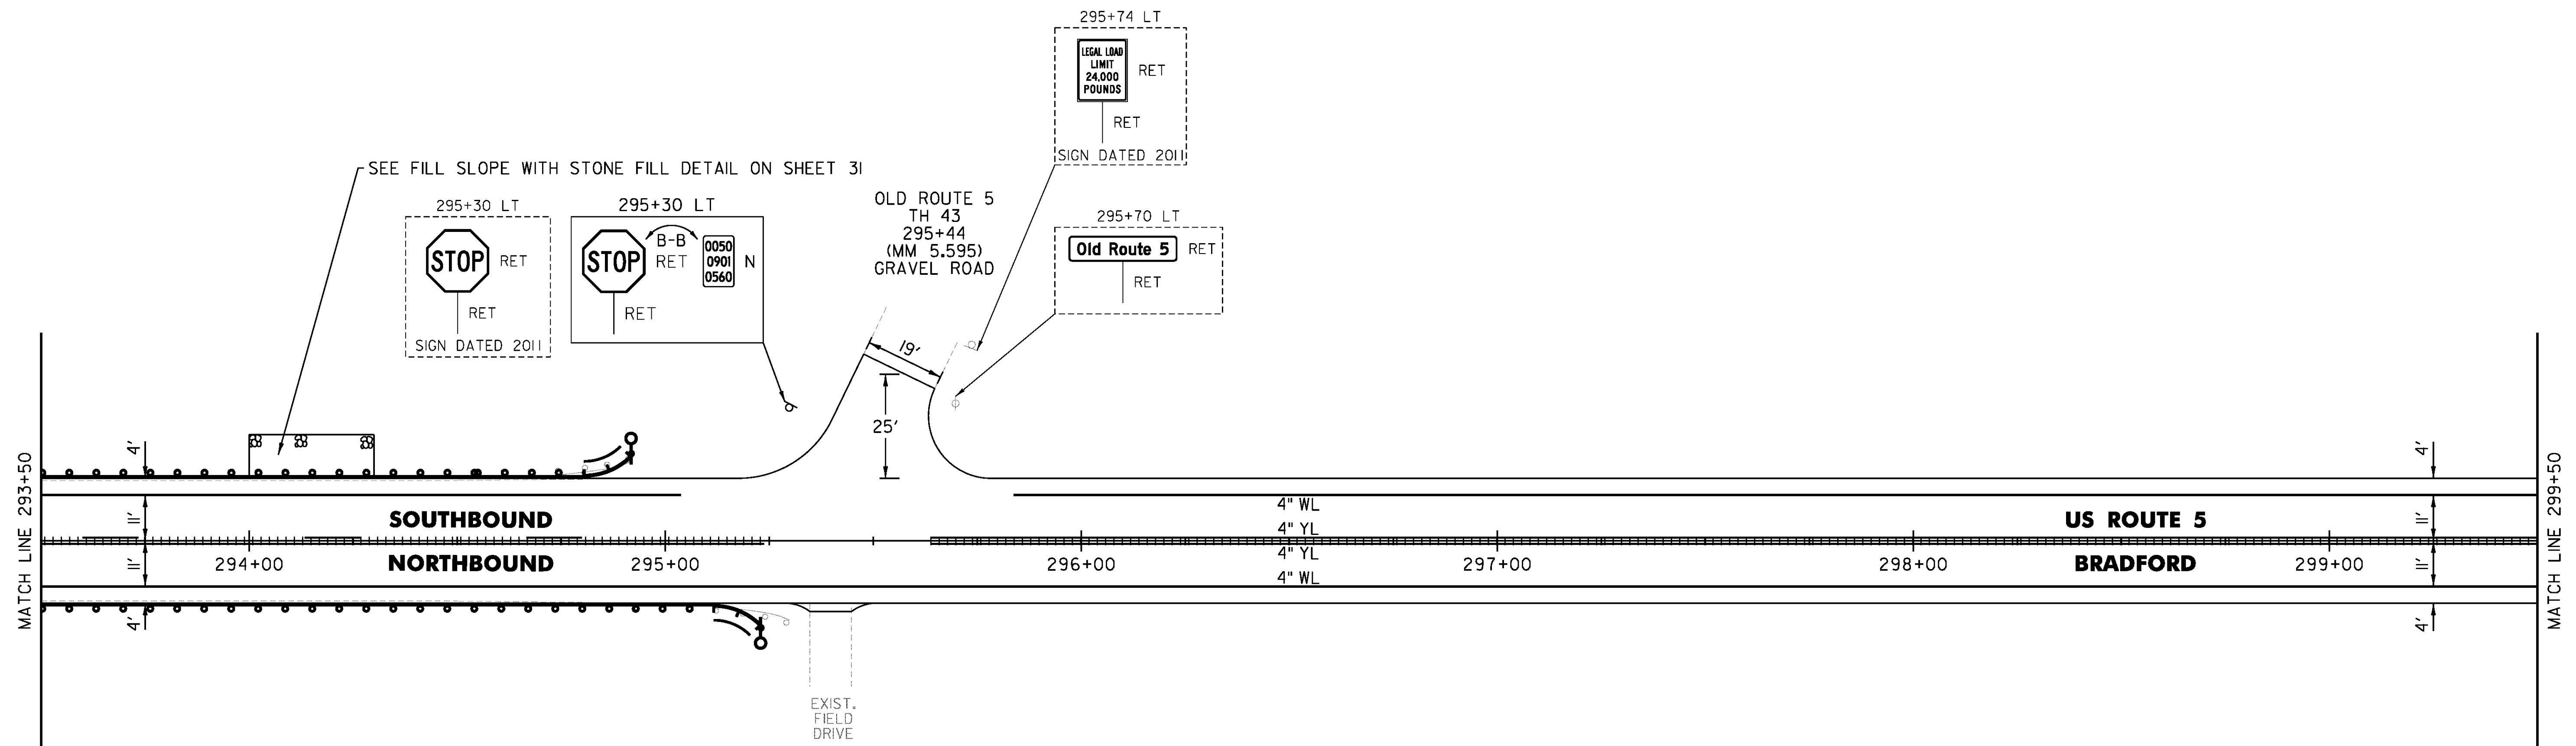

CLD 14-0278

NOT TO SCALE

PROJECT NAME: BRADFORD-RYEGATE	
PROJECT NUMBER: STP 2929(I)	
FILE NAME: z10c264bdr.dgn	PLOT DATE: 2/4/2016
PROJECT LEADER: P. SHEDD	DRAWN BY: W. GORDON
DESIGNED BY: N. LEMAY	CHECKED BY: P. SHEDD
US 5 PLAN SHEET 37	SHEET 95 OF 239