

TEMPORARY 4 INCH WHITE LINE, PAINT
 DURABLE 4 INCH WHITE LINE (OPTION ITEM)
 299+50 TO 303+67 SOLID LT
 299+50 TO 305+50 SOLID RT
 304+47 TO 305+50 SOLID LT

TEMPORARY 4 INCH YELLOW LINE, PAINT
 299+50 TO 303+87 SOLID LT & RT
 304+27 TO 305+50 SOLID LT & RT

DURABLE 4 INCH YELLOW LINE (OPTION ITEM)
 303+50 TO 303+87 SOLID LT & RT
 304+27 TO 305+50 SOLID LT & RT

DURABLE 4 INCH YELLOW LINE, EPOXY PAINT OR
 DURABLE 4 INCH YELLOW LINE, POLYUREA (OPTION ITEM)
 299+50 TO 303+50 SOLID LT & RT

STEEL BEAM GUARDRAIL, GALVANIZED
 303+63.5 TO 304+01 RT

ANCHOR FOR STEEL BEAM RAIL
 1' (SEE STANDARD G-1d)

REMOVAL AND DISPOSAL OF GUARDRAIL
 303+63.5 TO 304+01 RT


DELINEATOR WITH STEEL POST
 303+63.5 RT

REMOVE AND RESET GUARDRAIL
 304+01 TO 305+50 RT

MILLED RUMBLE STRIPS
 299+50 TO 303+50 CL

REMOVING SIGNS
 AS SHOWN - 3

ERECTING SALVAGED SIGNS
 AS SHOWN - 1

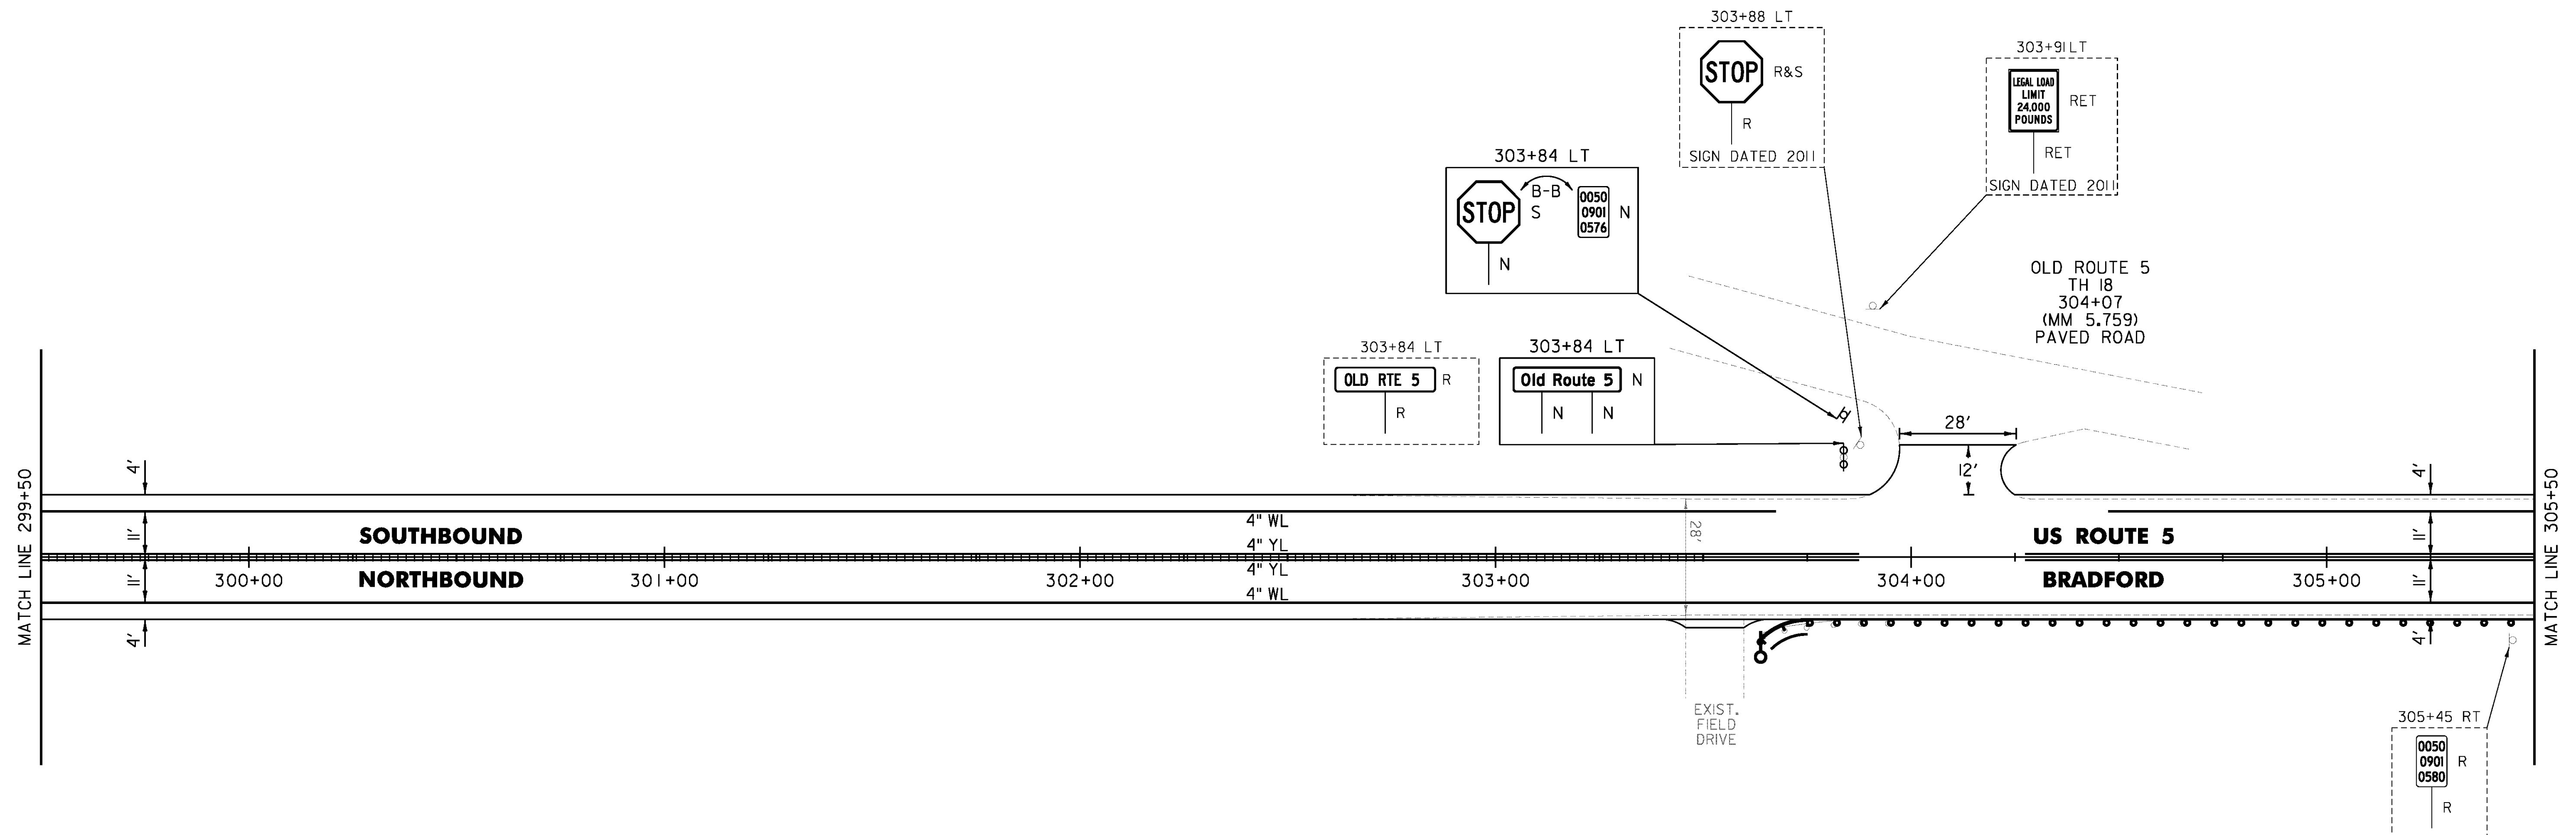

NOT TO SCALE

| | |
|--------------------------------|----------------------|
| PROJECT NAME: BRADFORD-RYEGATE | |
| PROJECT NUMBER: STP 2929(I) | |
| FILE NAME: z10c264bdr.dgn | PLOT DATE: 2/4/2016 |
| PROJECT LEADER: P. SHEDD | DRAWN BY: W. GORDON |
| DESIGNED BY: N. LEMAY | CHECKED BY: P. SHEDD |
| US 5 PLAN SHEET 38 | SHEET 96 OF 239 |