


TEMPORARY 4 INCH WHITE LINE, PAINT
 DURABLE 4 INCH WHITE LINE (OPTION ITEM)
 N 20+50 TO N 26+50 SOLID LT & RT

MILLED RUMBLE STRIPS
 N 20+50 TO N 26+50 CL

REMOVING SIGNS
 AS SHOWN - 2

TEMPORARY 4 INCH YELLOW LINE, PAINT
 DURABLE 4 INCH YELLOW LINE, EPOXY PAINT OR
 DURABLE 4 INCH YELLOW LINE, POLYUREA (OPTION ITEM)
 N 20+50 TO N 21+40 DASHED CL
 N 21+40 TO N 26+50 DASHED LT, SOLID RT

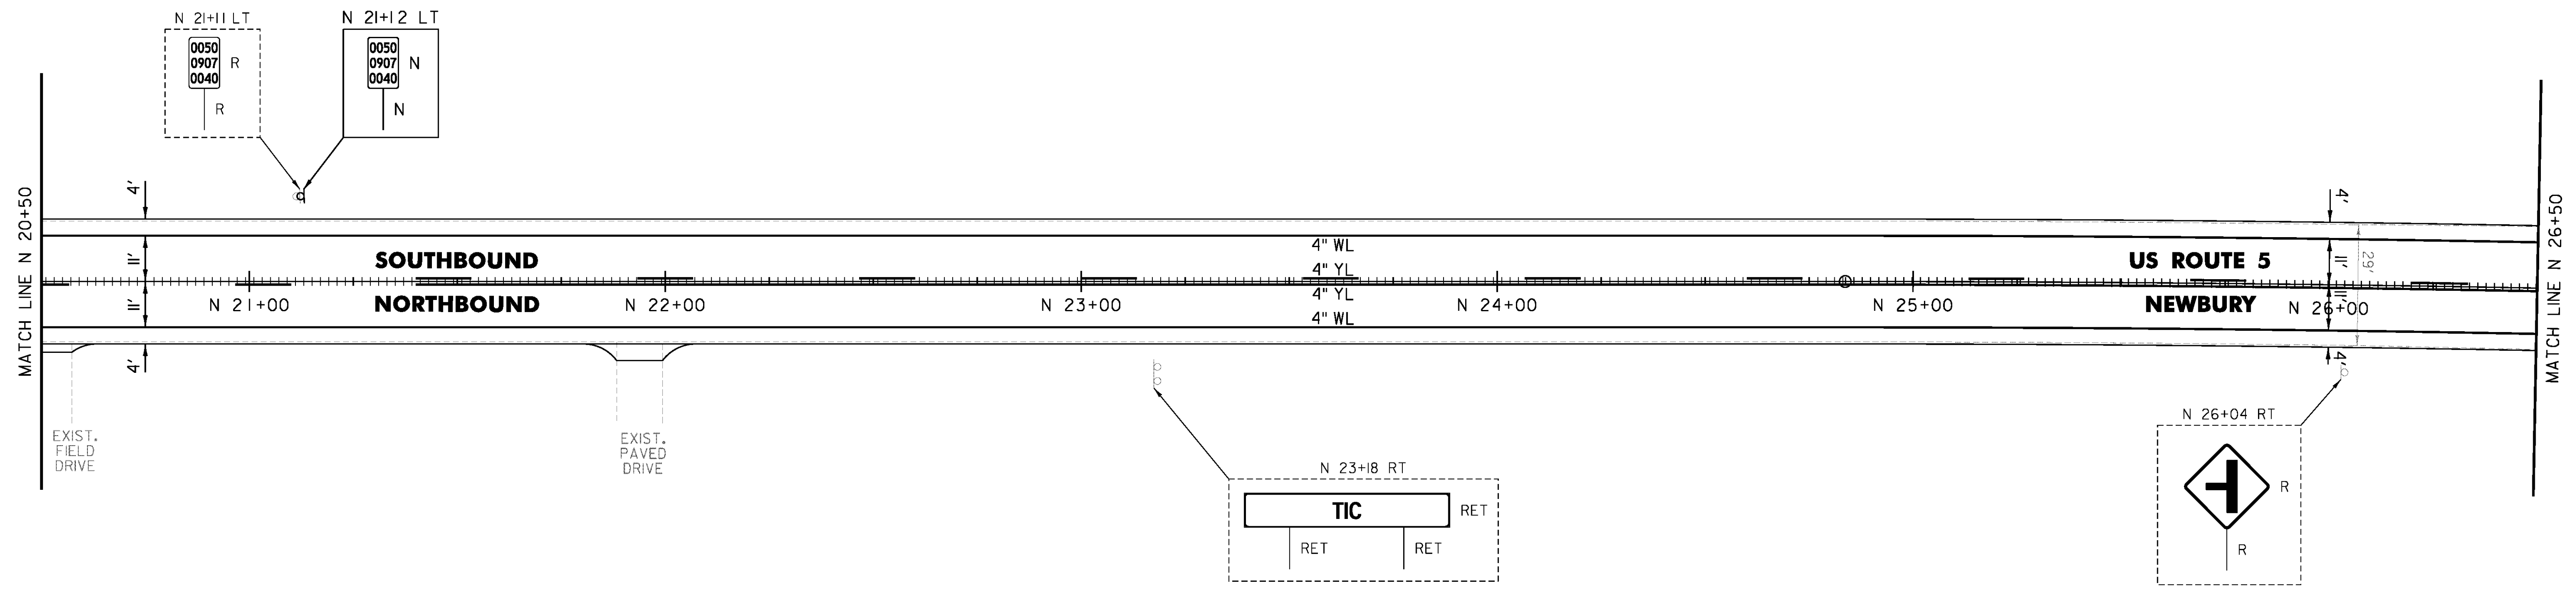

CLD 14-0278

NOT TO SCALE

PROJECT NAME: BRADFORD-RYEGATE	PLOT DATE: 2/4/2016
PROJECT NUMBER: STP 2929(I)	DRAWN BY: W. GORDON
FILE NAME: z10c264bdr.dgn	CHECKED BY: P. SHEDD
DESIGNED BY: N. LEMAY	SHEET 101 OF 239
US 5 PLAN SHEET 43	