

TEMPORARY 4 INCH WHITE LINE, PAINT
 DURABLE 4 INCH WHITE LINE (OPTION ITEM)
 N 26+50 TO N 32+50 SOLID LT & RT

TEMPORARY 4 INCH YELLOW LINE, PAINT
 N 26+50 TO N 29+00 DASHED LT, SOLID RT
 N 29+00 TO N 32+50 SOLID LT & RT

DURABLE 4 INCH YELLOW LINE (OPTION ITEM)
 N 28+25 TO N 29+00 DASHED LT, SOLID RT
 N 29+00 TO N 32+50 SOLID LT & RT

DURABLE 4 INCH YELLOW LINE, EPOXY PAINT OR
 DURABLE 4 INCH YELLOW LINE, POLYUREA (OPTION ITEM)
 N 26+50 TO N 28+25 DASHED LT, SOLID RT

REHAB. DROP INLETS, CATCH BASINS,
 OR MANHOLES, CLASS I, CLASS II
 N 29+45 RT

STEEL BEAM GUARDRAIL, GALVANIZED
 N 27+83.5 TO N 27+95 RT
 N 29+20 TO N 29+57.5 RT

ANCHOR FOR STEEL BEAM RAIL
 2 (SEE STANDARD G-1d)


REMOVAL AND DISPOSAL OF GUARDRAIL
 N 27+89 TO N 27+95 RT
 N 29+19.5 TO N 29+57 RT

DELINEATOR WITH STEEL POST
 N 27+83.5 RT
 N 29+57.5 RT

REMOVE AND RESET GUARDRAIL
 N 27+94.5 TO N 29+19.5 RT

MILLED RUMBLE STRIPS
 N 26+50 TO N 28+25 CL

REMOVING SIGNS
 AS SHOWN - 1

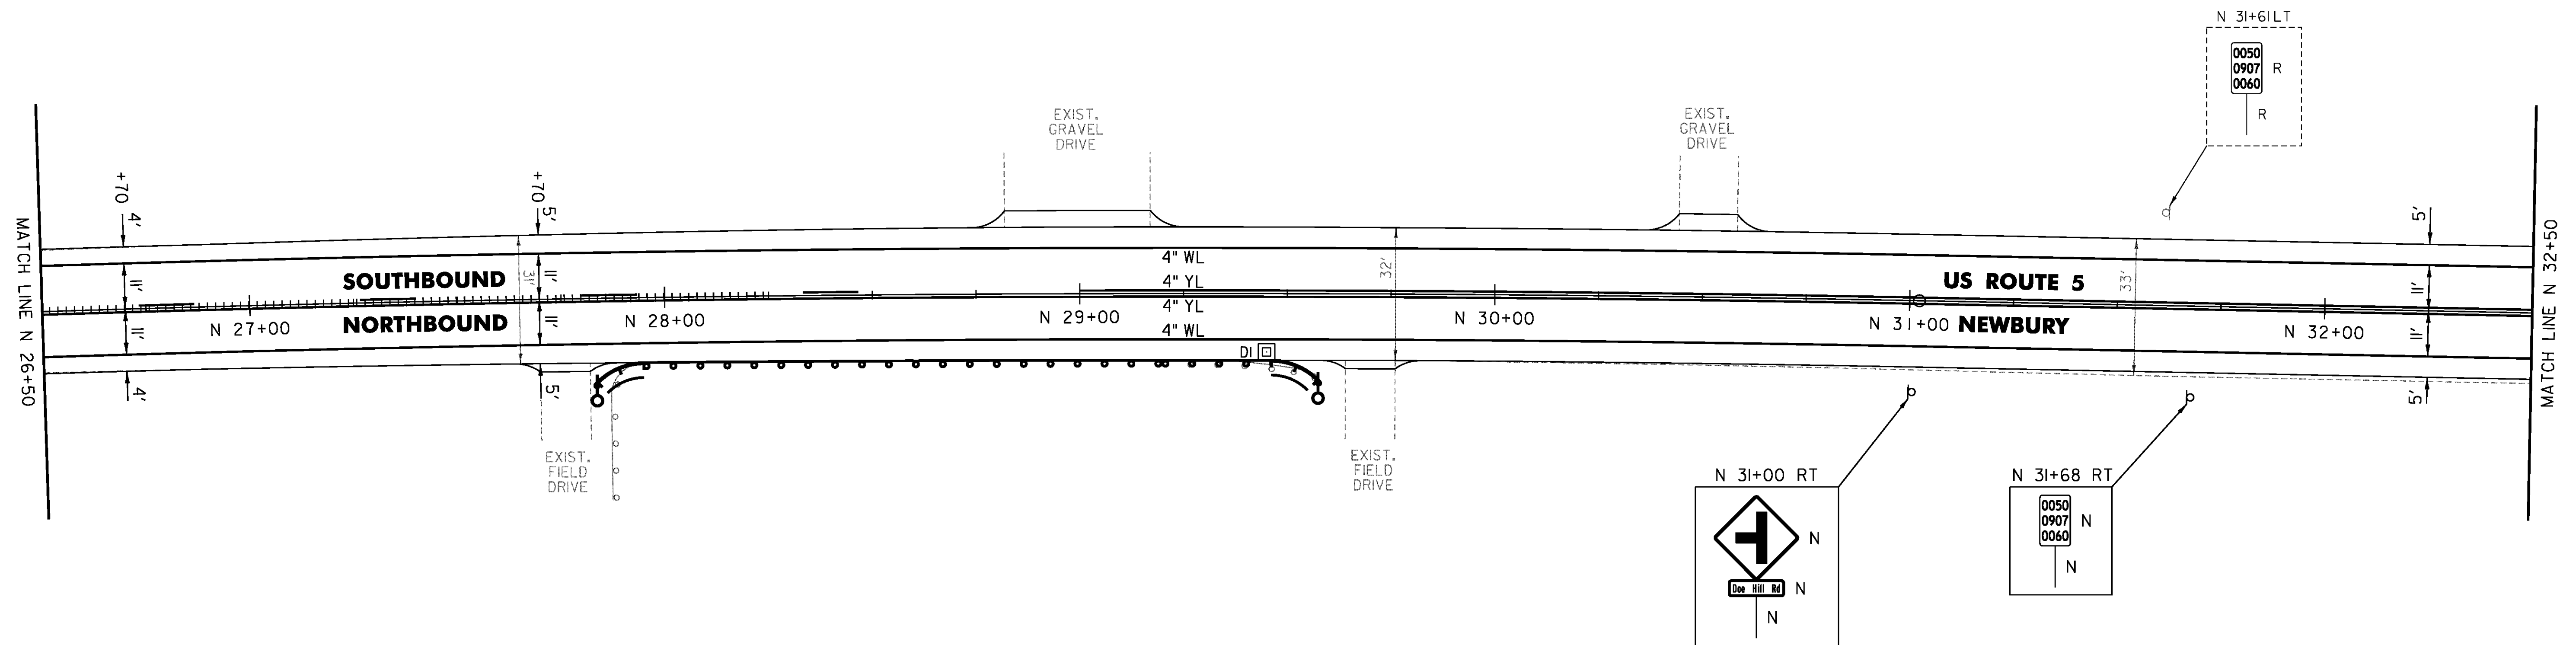

NOT TO SCALE

PROJECT NAME: BRADFORD-RYEGATE	PLOT DATE: 2/4/2016
PROJECT NUMBER: STP 2929(I)	DRAWN BY: W. GORDON
FILE NAME: z10c264bdr.dgn	CHECKED BY: P. SHEDD
PROJECT LEADER: P. SHEDD	SHEET 102 OF 239
DESIGNED BY: N. LEMAY	
US 5 PLAN SHEET 44	