

TEMPORARY 4 INCH WHITE LINE, PAINT
 DURABLE 4 INCH WHITE LINE (OPTION ITEM)
 N 32+50 TO N 34+97 SOLID LT
 N 32+50 TO N 38+50 SOLID RT
 N 34+97 TO N 35+53 SOLID LT (TH 84)
 N 35+93 TO N 36+18 SOLID LT (TH 84)
 N 36+18 TO N 38+50 SOLID LT

TEMPORARY 4 INCH YELLOW LINE, PAINT
 N 32+50 TO N 35+50 SOLID LT & RT
 N 35+70 TO N 35+73 DOUBLE SOLID LT (TH 84)
 N 35+90 TO N 38+50 SOLID LT & RT

DURABLE 4 INCH YELLOW LINE (OPTION ITEM)
 N 32+50 TO N 35+50 SOLID LT & RT
 N 35+70 TO N 35+73 DOUBLE SOLID LT (TH 84)
 N 35+90 TO N 37+00 SOLID LT & RT

DURABLE 4 INCH YELLOW LINE, EPOXY PAINT OR
 DURABLE 4 INCH YELLOW LINE, POLYUREA (OPTION ITEM)
 N 37+00 TO N 38+50 SOLID LT & RT

TEMPORARY 24 INCH STOP BAR, PAINT
 DURABLE 24 INCH STOP BAR (OPTION ITEM)
 N 35+27 TO N 35+69 LT (TH 84)

TEMPORARY LETTER OR SYMBOL, PAINT
 DURABLE LETTER OR SYMBOL (OPTION ITEM)
 N 35+59 LT "STOP" (TH 84)

REHAB. DROP INLETS, CATCH BASINS,
 OR MANHOLES, CLASS I, CLASS II
 N 36+54 RT

GRUBBING MATERIAL (6")
~~STONE FILL, TYPE I~~
 N 34+95 TO N 35+75 RT

BITUMINOUS CONCRETE
 GUTTERS AND TRAFFIC ISLANDS
 N 36+02 TO N 36+42 LT

STEEL BEAM GUARDRAIL, GALVANIZED
 N 33+45.5 TO N 33+83 LT
 N 34+17 TO N 34+54.5 RT
 N 35+38 TO N 35+71 LT
 N 36+75 RT (12.5)

ANCHOR FOR STEEL BEAM RAIL
 3 (SEE STANDARD G-1d)

REMOVE AND RESET GUARDRAIL
 N 34+54.5 TO N 36+67 RT


REMOVAL AND DISPOSAL OF GUARDRAIL
 N 33+45.5 TO N 33+83 LT
 N 34+17 TO N 34+54.5 RT
 N 35+38 TO N 35+71 LT
 N 36+67 TO N 36+74 RT

DELINEATOR WITH STEEL POST
 N 33+45.5 LT
 N 34+17 RT
 N 35+71 LT
 N 36+67 RT

SPECIAL PROVISION (STEEL BEAM
 GUARDRAIL GALVANIZED) (8 FEET RADIUS)
 N 36+67 RT

MILLED RUMBLE STRIPS
 N 37+00 TO N 38+50 CL

REMOVING SIGNS
 AS SHOWN - 5

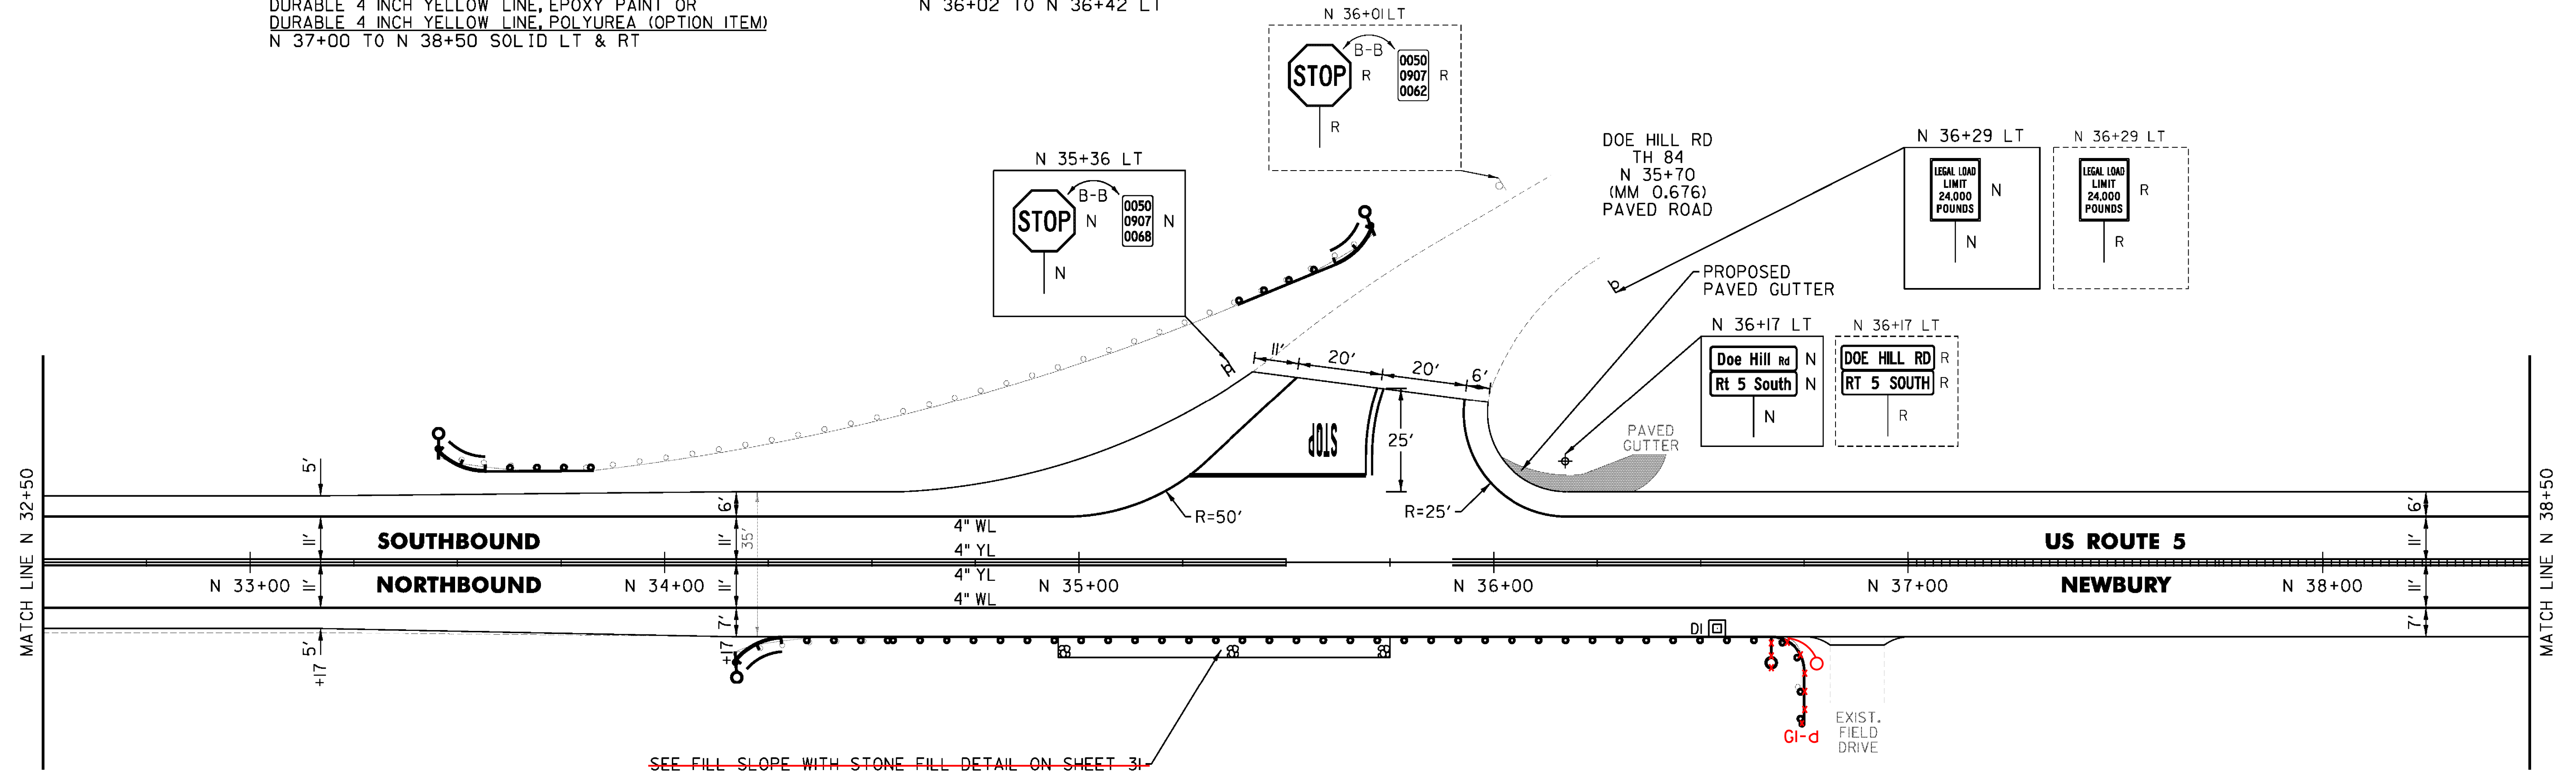

SEE FILL SLOPE WITH STONE FILL DETAIL ON SHEET 31

NOT TO SCALE

PROJECT NAME:	BRADFORD-RYEGATE	PLOT DATE:	2/4/2016
PROJECT NUMBER:	STP 2929(I)	DRAWN BY:	W. GORDON
FILE NAME:	z10c264bdr.dgn	CHECKED BY:	P. SHEDD
DESIGNED BY:	N. LEMAY	SHEET	103 OF 239
US 5 PLAN SHEET	45		

CLD 14-0278