

TEMPORARY 4 INCH WHITE LINE, PAINT
 DURABLE 4 INCH WHITE LINE (OPTION ITEM)
 N 56+50 TO N 62+50 SOLID LT
 N 56+50 TO N 58+13 SOLID RT
 N 58+93 TO N 62+50 SOLID RT

TEMPORARY 4 INCH YELLOW LINE, PAINT
 DURABLE 4 INCH YELLOW LINE, EPOXY PAINT OR
 DURABLE 4 INCH YELLOW LINE, POLYUREA (OPTION ITEM)
 N 56+50 TO N 58+33 SOLID LT & RT
 N 58+73 TO N 62+50 SOLID LT & RT

STEEL BEAM GUARDRAIL, GALVANIZED
 N 56+50 TO N 57+07 LT
 N 56+50 TO N 57+23 RT


ANCHOR FOR STEEL BEAM RAIL
 2 (SEE STANDARD G-1d)

REMOVAL AND DISPOSAL OF GUARDRAIL
 N 56+50 TO N 57+07 LT
 N 56+50 TO N 57+62 RT

DELINEATOR WITH STEEL POST
 N 57+07 LT
 N 57+22.5 RT

MILLED RUMBLE STRIPS
 N 56+50 TO N 58+33 CL
 N 58+73 TO N 62+50 CL

REMOVING SIGNS
 AS SHOWN - 4

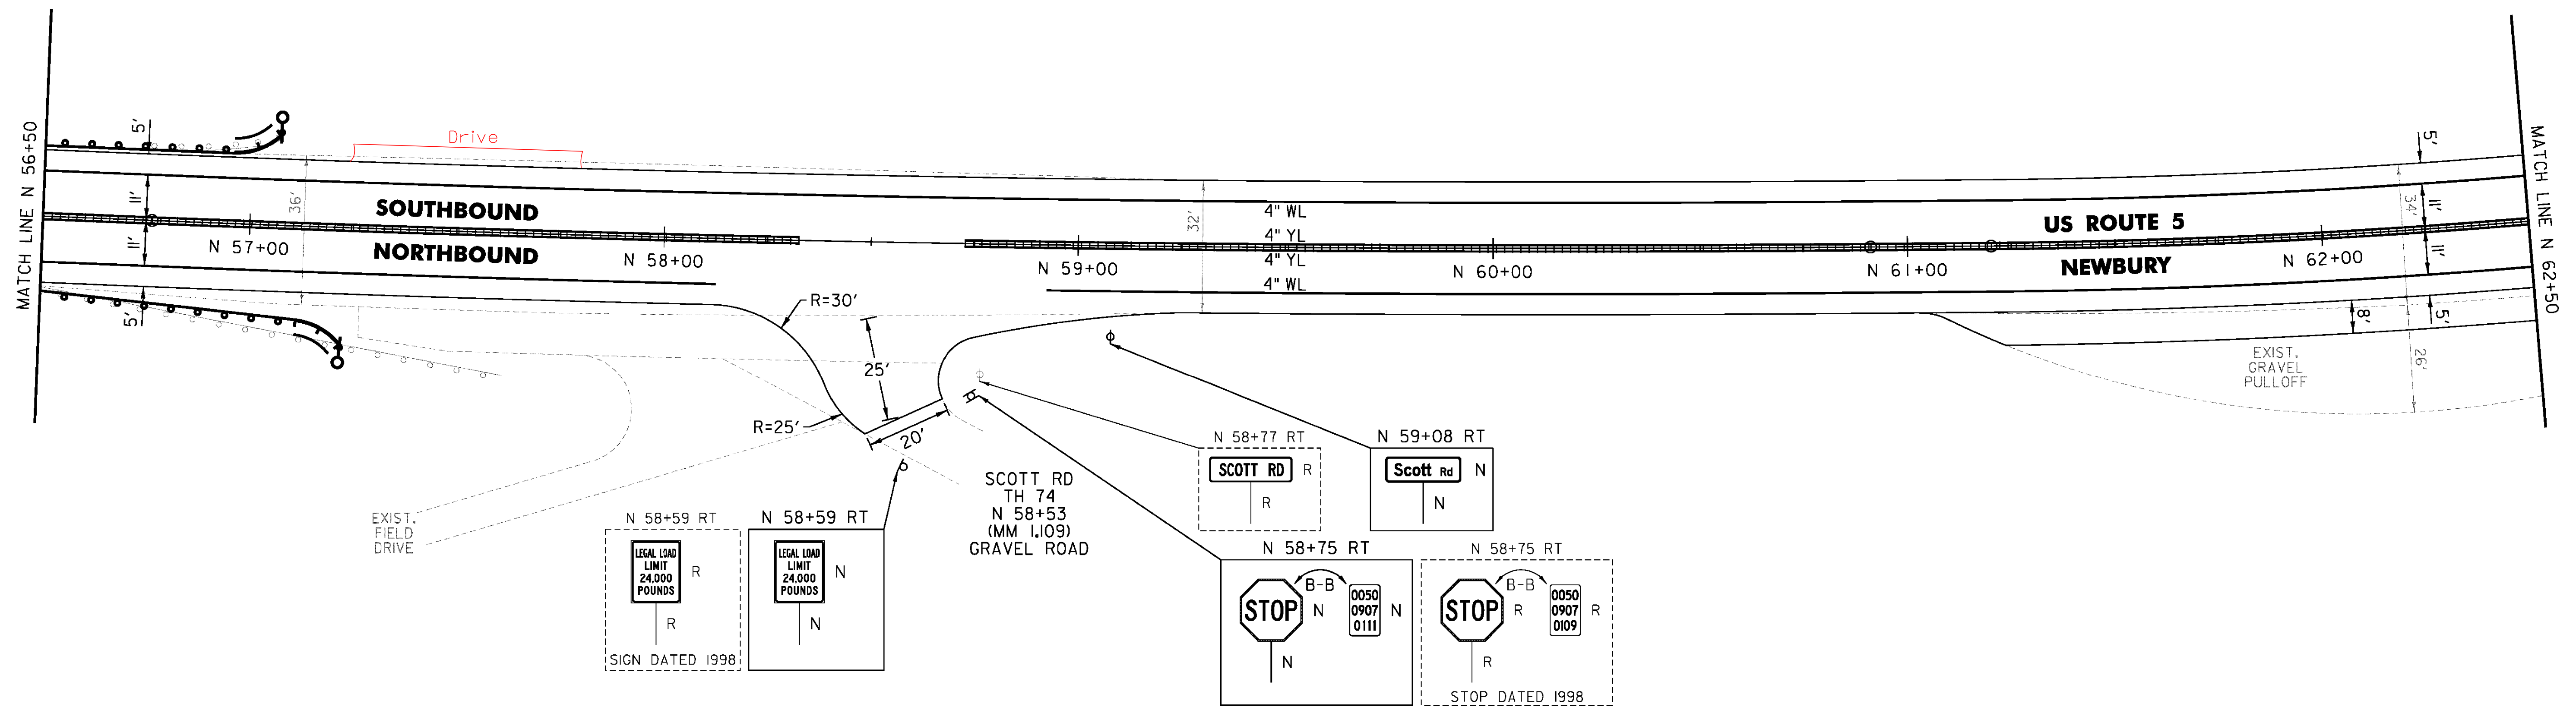

CLD 14-0278

NOT TO SCALE

PROJECT NAME:	BRADFORD-RYEGATE
PROJECT NUMBER:	STP 2929(I)
FILE NAME:	z10c264bdr.dgn
PROJECT LEADER:	P. SHEDD
DESIGNED BY:	N. LEMAY
US 5 PLAN SHEET 49	
PLOT DATE:	2/4/2016
DRAWN BY:	W. GORDON
CHECKED BY:	P. SHEDD
SHEET	107 OF 239