

TEMPORARY 4 INCH WHITE LINE, PAINT
 DURABLE 4 INCH WHITE LINE (OPTION ITEM)
 N 62+50 TO N 68+50 SOLID LT
 N 62+50 TO N 66+23 SOLID RT
 N 67+02 TO N 68+50 SOLID RT

TEMPORARY 4 INCH YELLOW LINE, PAINT
 N 62+50 TO N 66+43 SOLID LT & RT
 N 66+83 TO N 68+50 SOLID LT & RT

DURABLE 4 INCH YELLOW LINE (OPTION ITEM)
 N 63+50 TO N 66+43 SOLID LT & RT

DURABLE 4 INCH YELLOW LINE, EPOXY PAINT OR
 DURABLE 4 INCH YELLOW LINE, POLYUREA (OPTION ITEM)
 N 62+50 TO N 63+50 SOLID LT & RT
 N 66+83 TO N 68+50 SOLID LT & RT

STEEL BEAM GUARDRAIL, GALVANIZED
 N 63+48.5 TO N 63+86 RT
 N 66+45 TO N 66+51 RT
 N 66+47.5 TO N 67+72.5 LT
 N 66+71 TO N 66+72 RT
 N 68+02 TO N 68+39.5 RT

ANCHOR FOR STEEL BEAM RAIL
 6 (SEE STANDARD G-1d)

REMOVAL AND DISPOSAL OF GUARDRAIL
 N 63+48.5 TO N 63+86 RT
 N 66+36 TO N 66+50 RT
 N 66+56 TO N 67+70 LT
 N 66+70 TO N 67+02 RT
 N 68+02 TO N 68+39.5 RT

DELINEATOR WITH STEEL POST
 N 63+48.5 RT
 N 66+45 RT
 N 66+47.5 LT
 N 66+69 RT
 N 67+72.5 LT
 N 68+39.5 RT


REMOVE AND RESET GUARDRAIL
 N 63+86 TO N 66+36 RT
 N 67+02 TO N 68+02 RT

SPECIAL PROVISION (STEEL BEAM
 GUARDRAIL GALVANIZED) (16 FEET RADIUS)
 N 66+36 RT

SPECIAL PROVISION (STEEL BEAM
 GUARDRAIL GALVANIZED) (35 FEET RADIUS)
 N 67+02 RT

MILLED RUMBLE STRIPS
 N 62+50 TO N 63+50 CL
 N 66+83 TO N 68+50 CL

REMOVING SIGNS
 AS SHOWN - 6

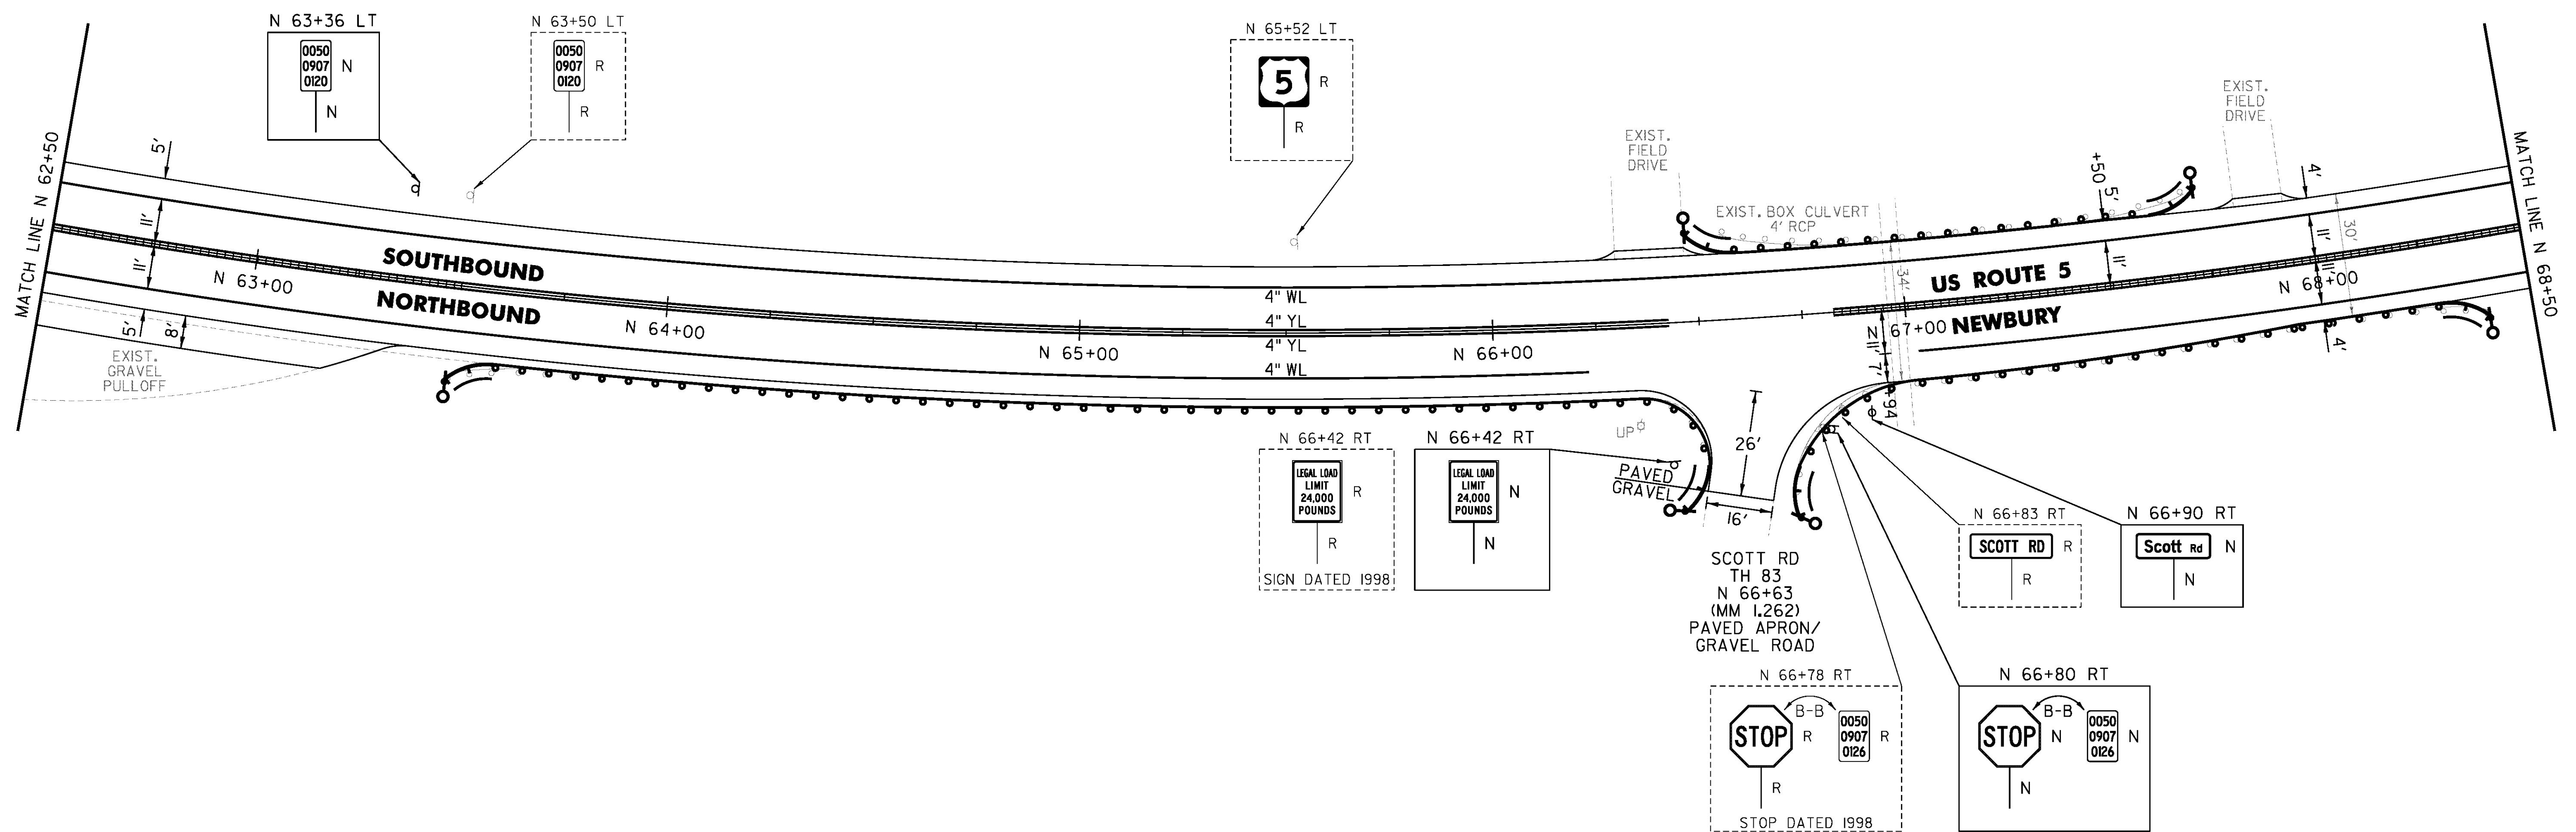

NOT TO SCALE

PROJECT NAME: BRADFORD-RYEGATE

PROJECT NUMBER: STP 2929(I)

FILE NAME: z10c264bdr.dgn
 PROJECT LEADER: P. SHEDD
 DESIGNED BY: N. LEMAY
 US 5 PLAN SHEET 50

PLOT DATE: 2/4/2016
 DRAWN BY: W. GORDON
 CHECKED BY: P. SHEDD
 SHEET 108 OF 239