

TEMPORARY 4 INCH WHITE LINE, PAINT  
 DURABLE 4 INCH WHITE LINE (OPTION ITEM)  
 N 80+50 TO N 86+50 SOLID LT & RT


TEMPORARY 4 INCH YELLOW LINE, PAINT  
 DURABLE 4 INCH YELLOW LINE (OPTION ITEM)  
 N 80+50 TO N 86+50 SOLID LT & RT

STEEL BEAM GUARDRAIL, GALVANIZED  
 N 80+50 TO N 86+50 RT

REMOVAL AND DISPOSAL OF GUARDRAIL  
 N 80+50 TO N 86+50 RT

REMOVE AND RESET GUARDRAIL  
 N 80+87.5 TO N 84+49.5 LT

DELINEATOR WITH STEEL POST  
 N 80+87.5 LT  
 N 84+49.5 LT

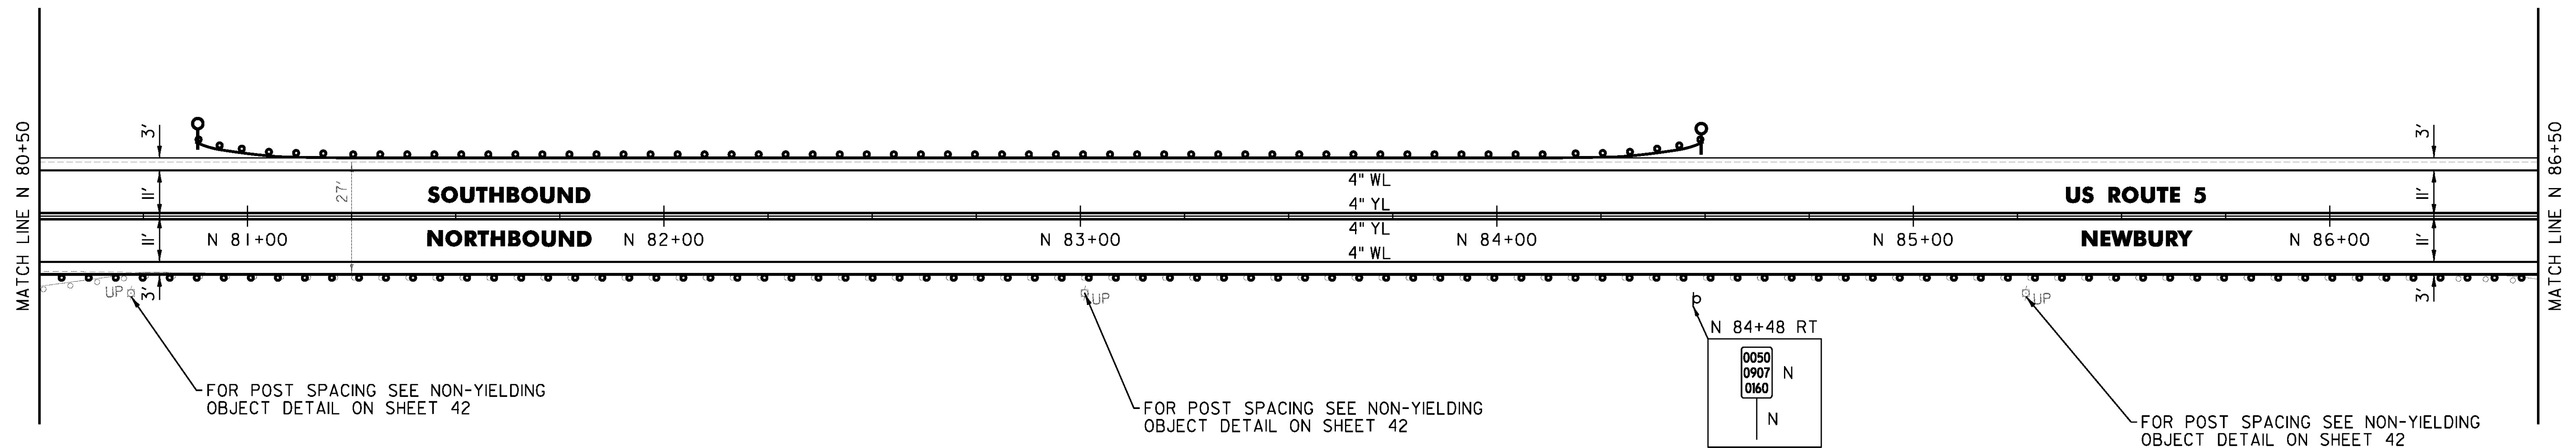

NOT TO SCALE

PROJECT NAME: BRADFORD-RYEGATE	PLOT DATE: 2/4/2016
PROJECT NUMBER: STP 2929(I)	DRAWN BY: W. GORDON
FILE NAME: z10c264bdr.dgn	CHECKED BY: P. SHEDD
PROJECT LEADER: P. SHEDD	SHEET III OF 239
DESIGNED BY: N. LEMAY	
US 5 PLAN SHEET 53	