

TEMPORARY 4 INCH WHITE LINE, PAINT  
 DURABLE 4 INCH WHITE LINE (OPTION ITEM)  
 N 110+50 TO N 116+50 SOLID LT & RT

TEMPORARY 4 INCH YELLOW LINE, PAINT  
 DURABLE 4 INCH YELLOW LINE (OPTION ITEM)  
 N 110+50 TO N 116+50 SOLID LT & RT

STEEL BEAM GUARDRAIL, GALVANIZED  
 N 116+03 TO N 116+15.5 RT

STEEL BEAM GUARDRAIL,  
 GALVANIZED W/8 FEET POSTS  
 N 116+15.5 TO N 116+50 RT


ANCHOR FOR STEEL BEAM RAIL  
 I (SEE STANDARD G-1d)

REMOVAL AND DISPOSAL OF GUARDRAIL  
 N 116+03 TO N 116+50 RT

DELINEATOR WITH STEEL POST  
 N 116+03 RT

GRUBBING MATERIAL (6")  
 STONE FILL, TYPE I  
 N 116+20 TO N 116+50 RT

REMOVING SIGNS  
 AS SHOWN - 1

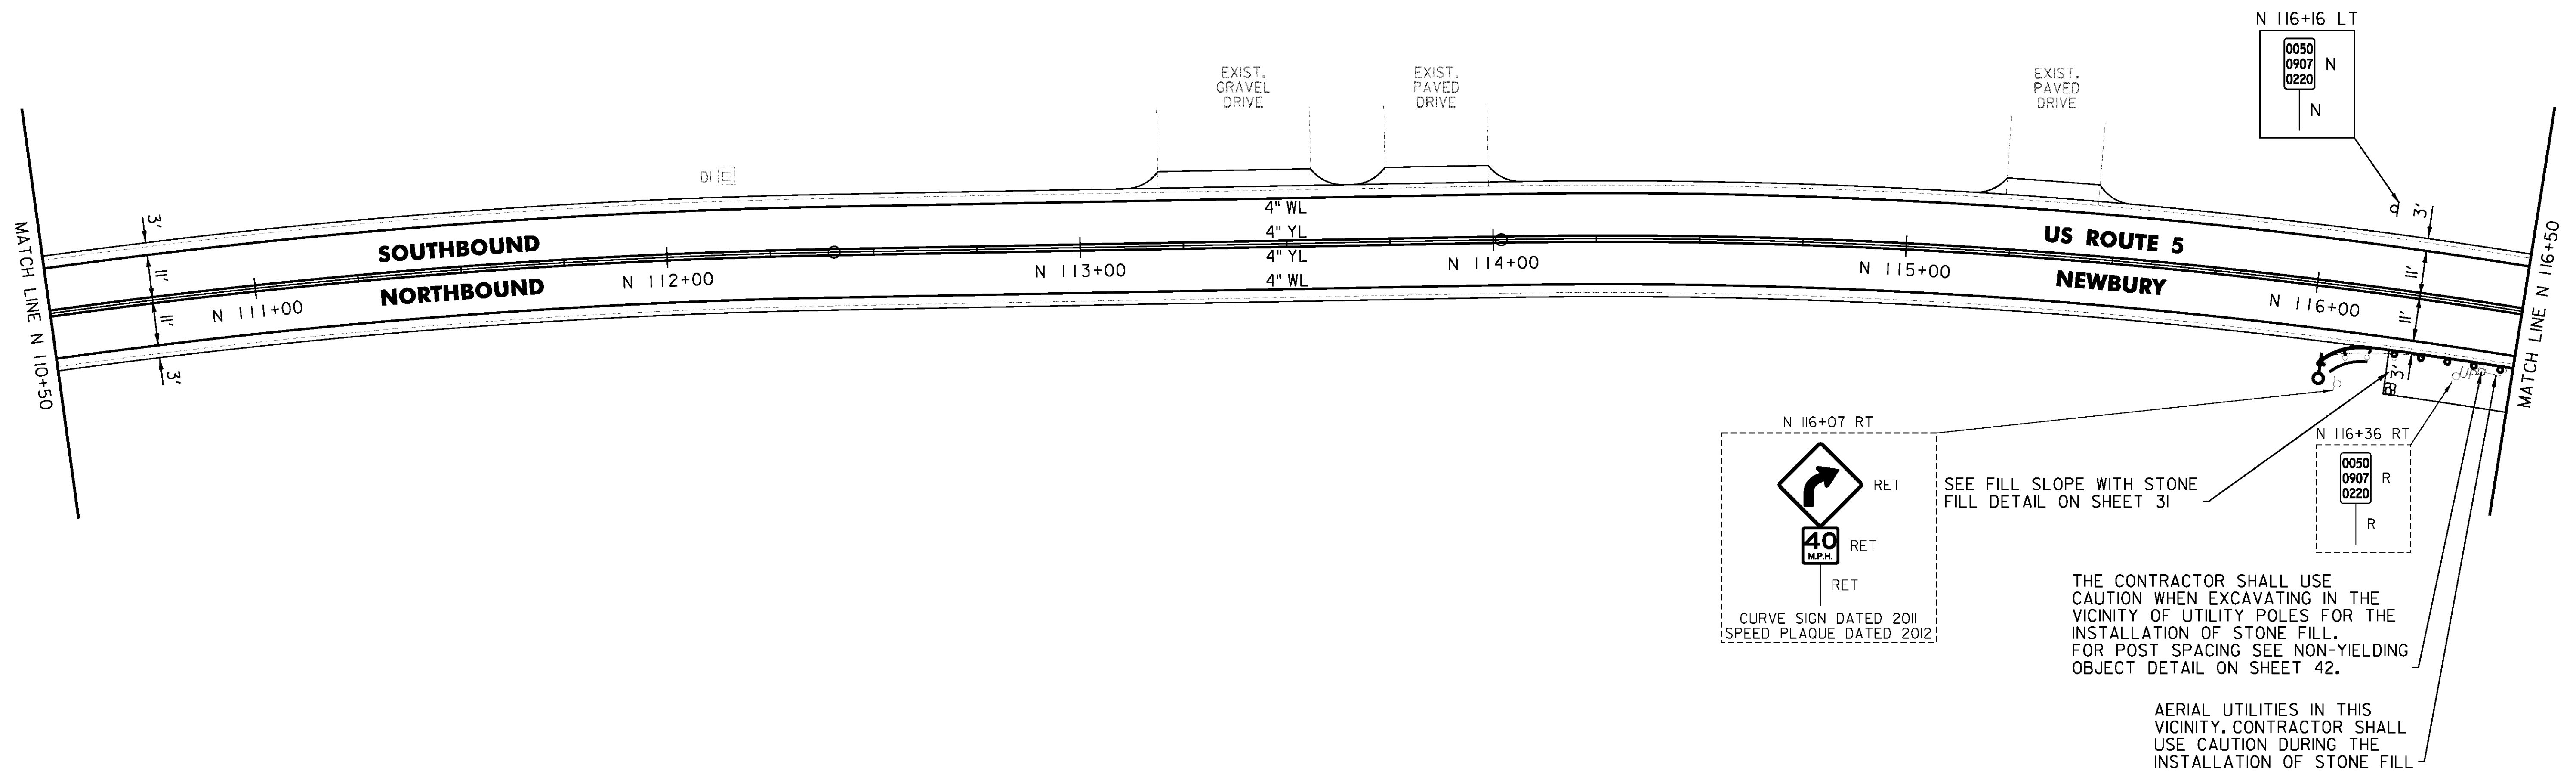

NOT TO SCALE

|                                |                      |
|--------------------------------|----------------------|
| PROJECT NAME: BRADFORD-RYEGATE | PLOT DATE: 2/4/2016  |
| PROJECT NUMBER: STP 2929(I)    | DRAWN BY: W. GORDON  |
| FILE NAME: z10c264bdr.dgn      | CHECKED BY: P. SHEDD |
| PROJECT LEADER: P. SHEDD       | SHEET 116 OF 239     |
| DESIGNED BY: N. LEMAY          |                      |
| US 5 PLAN SHEET 58             |                      |