


TEMPORARY 4 INCH WHITE LINE, PAINT
DURABLE 4 INCH WHITE LINE (OPTION ITEM)
N 134+50 TO N 140+50 SOLID LT & RT

TEMPORARY 4 INCH YELLOW LINE, PAINT
DURABLE 4 INCH YELLOW LINE (OPTION ITEM)
N 134+50 TO N 140+50 SOLID LT & RT

REMOVING SIGNS
AS SHOWN - 1

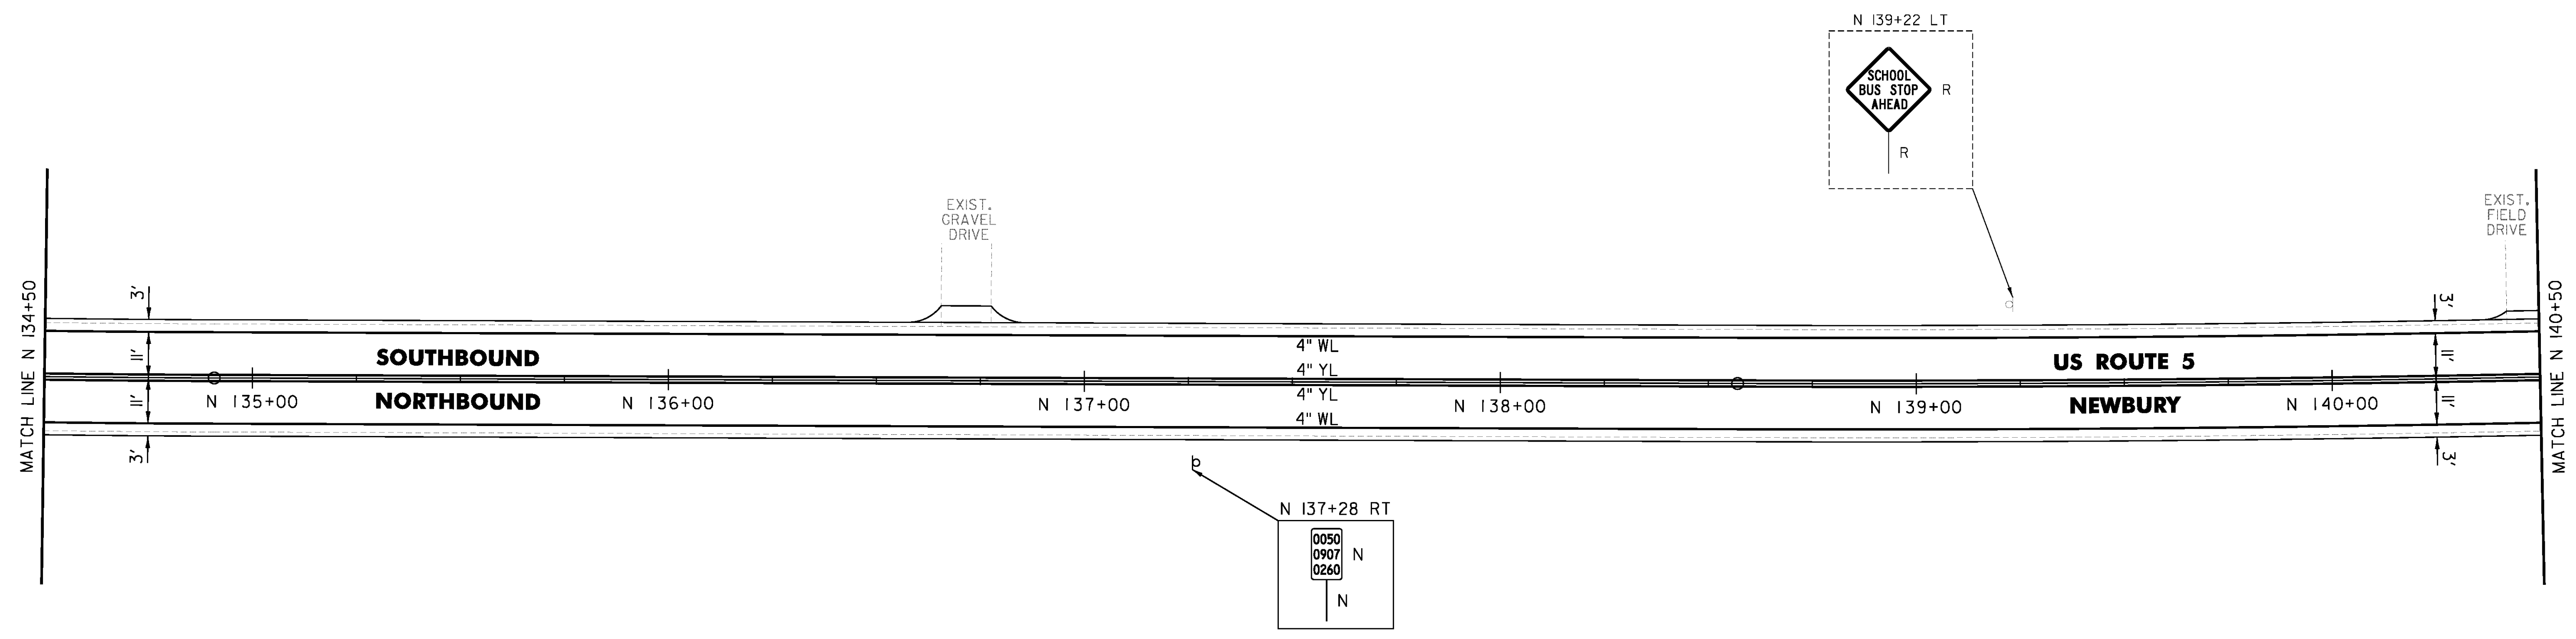

NOT TO SCALE

PROJECT NAME: BRADFORD-RYEGATE	FILE NAME: z10c264bdr.dgn	PLOT DATE: 2/4/2016
PROJECT NUMBER: STP 2929(I)	PROJECT LEADER: P. SHEDD	DRAWN BY: W. GORDON
	DESIGNED BY: N. LEMAY	CHECKED BY: P. SHEDD
	US 5 PLAN SHEET 62	SHEET 120 OF 239

CLD 14-0278