


TEMPORARY 4 INCH WHITE LINE, PAINT
 DURABLE 4 INCH WHITE LINE (OPTION ITEM)
 N 167+50 TO N 172+50 SOLID LT
 N 167+50 TO N 169+74 SOLID RT
 N 169+74 TO N 170+12 SOLID RT (NSH)
 N 170+33 TO N 170+66 SOLID RT (NSH)
 N 170+66 TO N 172+50 SOLID RT
 NEWBURY STATE HIGHWAY
 0+44 TO 1+50 SOLID LT
 0+49 TO 1+50 SOLID RT

TEMPORARY 4 INCH YELLOW LINE, PAINT
 DURABLE 4 INCH YELLOW LINE (OPTION ITEM)
 N 167+50 TO N 170+04 SOLID LT & RT
 N 170+44 TO N 172+50 SOLID LT & RT
 NEWBURY STATE HIGHWAY
 0+32 TO 1+50 SOLID LT & RT

TEMPORARY 24 INCH STOP BAR, PAINT
 DURABLE 24 INCH STOP BAR (OPTION ITEM)
 NEWBURY STATE HIGHWAY
 0+32 LT
 TEMPORARY LETTER OR SYMBOL, PAINT
 DURABLE LETTER OR SYMBOL (OPTION ITEM)
 NEWBURY STATE HIGHWAY
 0+40 LT "STOP"

STEEL BEAM GUARDRAIL, GALVANIZED
 NEWBURY STATE HIGHWAY
 0+55 TO 1+05 RT
 1+50 RT
 ANCHOR FOR STEEL BEAM RAIL
 1 (SEE STANDARD G-1d)
 REMOVAL AND DISPOSAL OF GUARDRAIL
 NEWBURY STATE HIGHWAY
 0+80 TO 1+05 RT
 1+50 RT
 DELINEATOR WITH STEEL POST
 0+55 RT

~~REMOVE AND RESET GUARDRAIL
 NEWBURY STATE HIGHWAY
 1+05 TO 1+50 RT~~
 REMOVING SIGNS
 AS SHOWN - 5
 ERECTING SALVAGED SIGNS
 AS SHOWN - 1

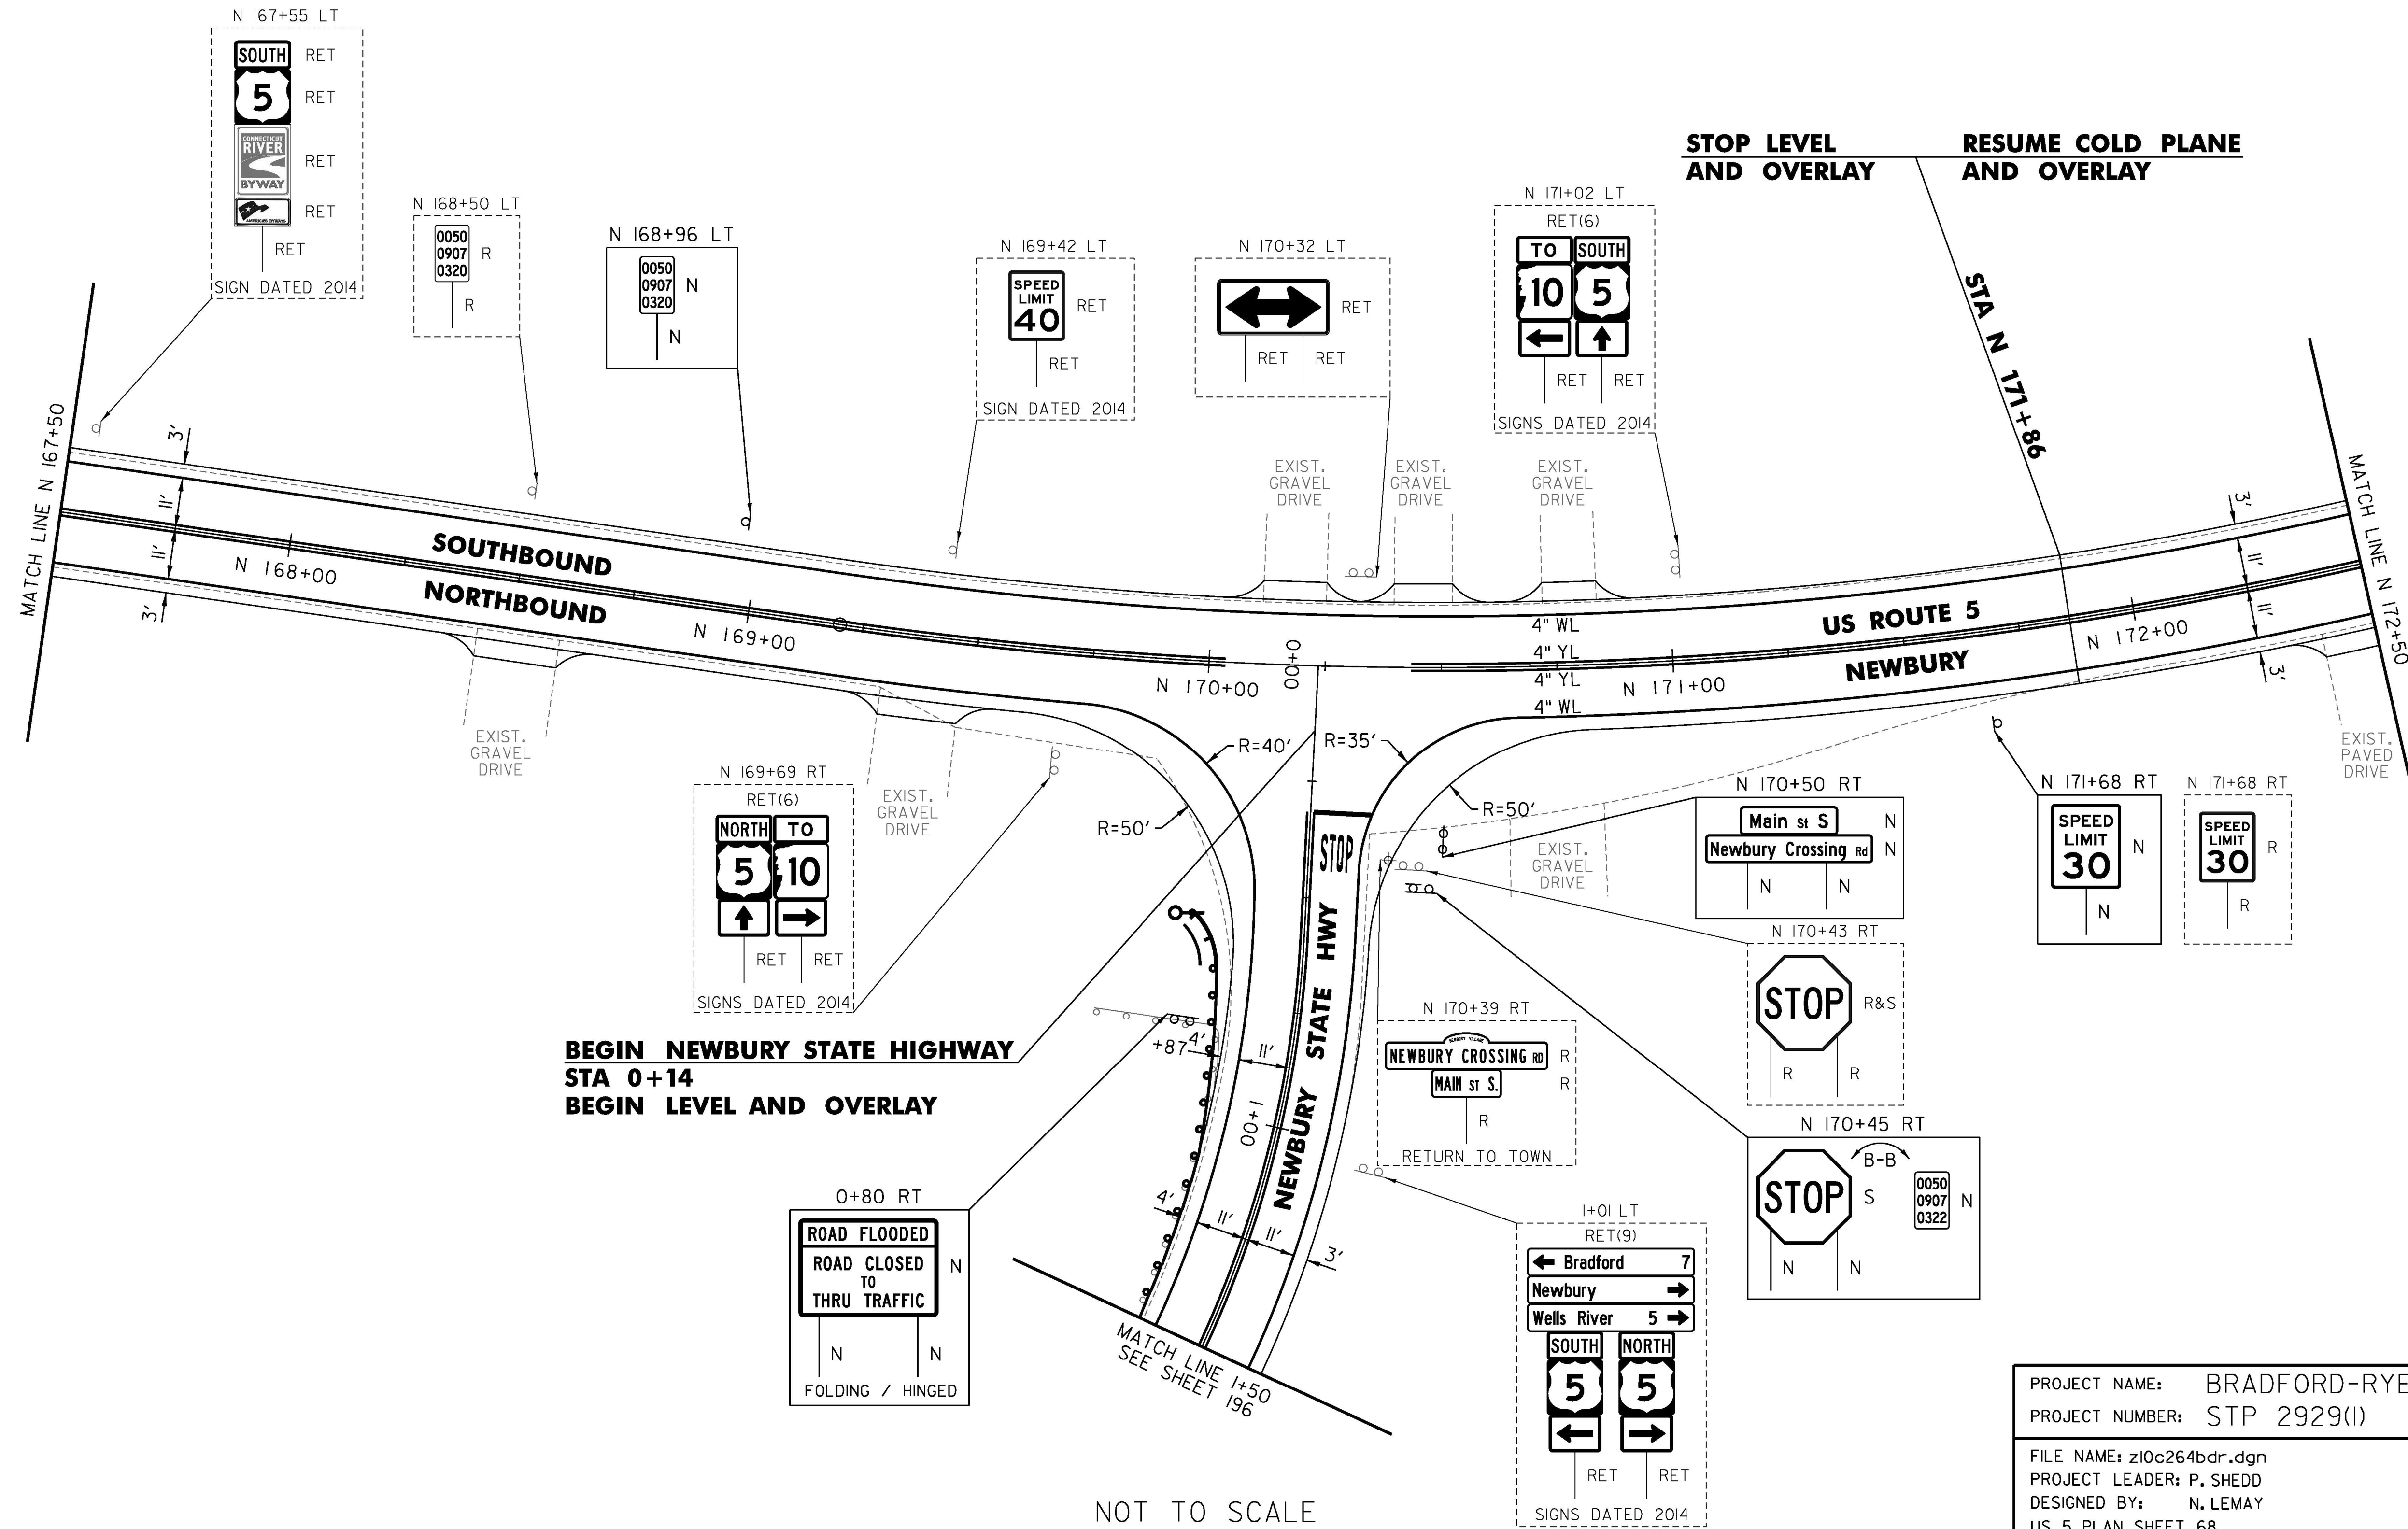

**BEGIN NEWBURY STATE HIGHWAY
 STA 0+14
 BEGIN LEVEL AND OVERLAY**

STOP LEVEL AND OVERLAY **RESUME COLD PLANE AND OVERLAY**

0+80 RT
**ROAD FLOODED
 ROAD CLOSED
 TO THRU TRAFFIC**
 N N
 FOLDING / HINGED

NOT TO SCALE

PROJECT NAME:	BRADFORD-RYEGATE
PROJECT NUMBER:	STP 2929(1)
FILE NAME:	z10c264bdr.dgn
PROJECT LEADER:	P. SHEDD
DESIGNED BY:	N. LEMAY
US 5 PLAN SHEET 68	
PLOT DATE:	2/4/2016
DRAWN BY:	W. GORDON
CHECKED BY:	P. SHEDD
SHEET	126 OF 239