

TEMPORARY 4 INCH WHITE LINE, PAINT  
 DURABLE 4 INCH WHITE LINE (OPTION ITEM)  
 N 172+50 TO N 178+50 SOLID LT & RT  
 N 175+14 SOLID LT (NO PARKING)  
 N 175+26 SOLID LT (NO PARKING)


TEMPORARY 4 INCH YELLOW LINE, PAINT  
 DURABLE 4 INCH YELLOW LINE (OPTION ITEM)  
 N 172+50 TO N 178+50 SOLID LT & RT

TEMPORARY 8 INCH WHITE LINE, PAINT  
 DURABLE 8 INCH WHITE LINE (OPTION ITEM)  
 N 175+14 TO N 175+26 SOLID LT (NO PARKING)

REMOVING SIGNS  
 AS SHOWN - 4

ERECTING SALVAGED SIGNS  
 AS SHOWN - 4

THINNING AND TRIMMING FOR SIGNS  
 N 173+74 LT  
 N 177+92 LT

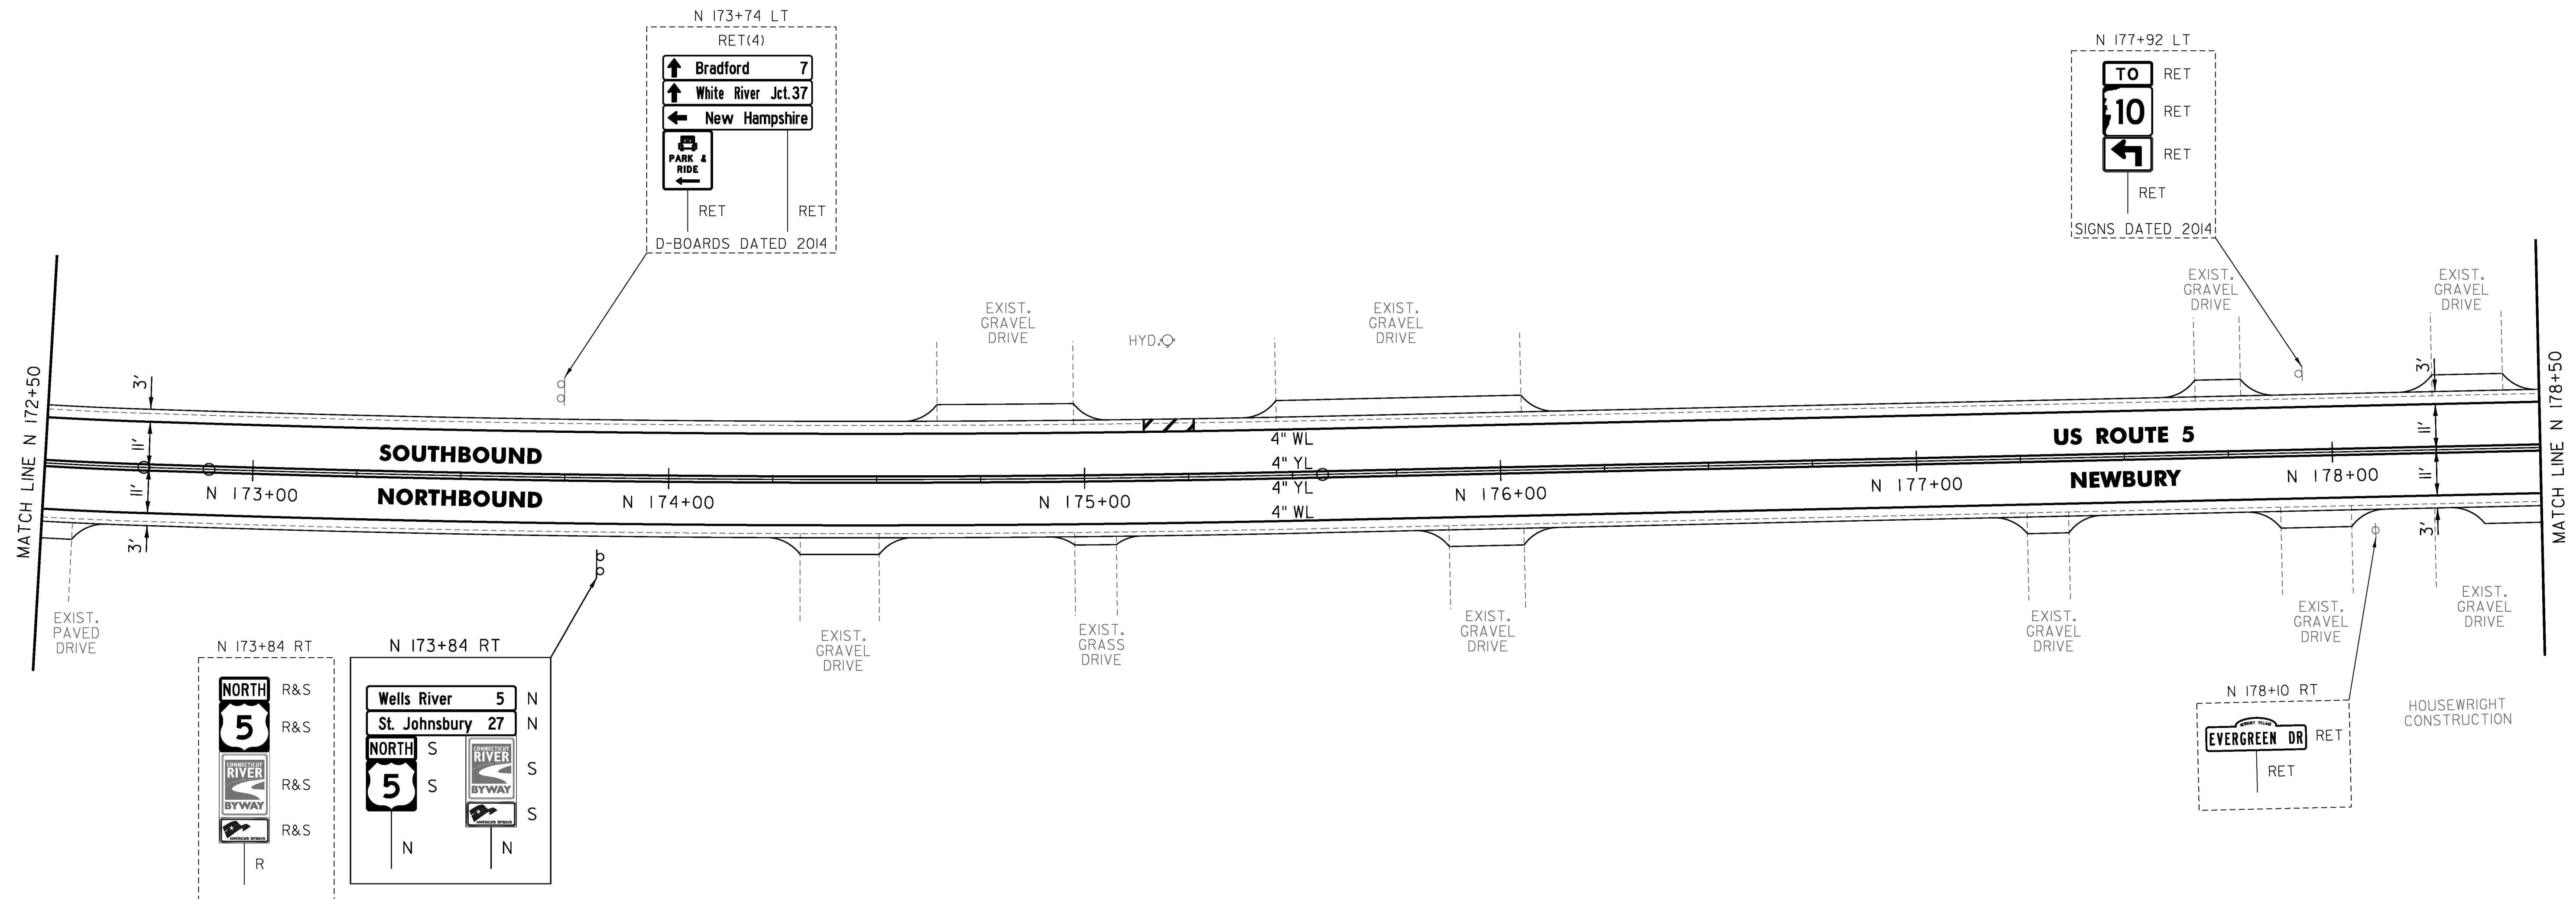

CLD 14-0278

NOT TO SCALE

PROJECT NAME:	BRADFORD-RYEGATE
PROJECT NUMBER:	STP 2929(I)
FILE NAME:	z10c264bdr.dgn
PROJECT LEADER:	P. SHEDD
DESIGNED BY:	N. LEMAY
US 5 PLAN SHEET 69	
PLOT DATE:	2/4/2016
DRAWN BY:	W. GORDON
CHECKED BY:	P. SHEDD
SHEET	127 OF 239