

TEMPORARY 4 INCH WHITE LINE, PAINT  
 DURABLE 4 INCH WHITE LINE (OPTION ITEM)  
 N 190+50 TO N 192+18 SOLID LT  
 N 190+50 TO N 192+18 SOLID RT  
 N 190+69 SOLID LT (NO PARKING)  
 N 190+81 SOLID LT (NO PARKING)  
 N 192+26 TO N 192+89 SOLID LT  
 N 192+26 TO N 196+50 SOLID RT  
 N 193+48 TO N 193+77 SOLID LT  
 N 194+36 TO N 196+50 SOLID RT

TEMPORARY 4 INCH YELLOW LINE, PAINT  
 DURABLE 4 INCH YELLOW LINE (OPTION ITEM)  
 N 190+50 TO N 192+18 SOLID LT & RT  
 N 192+26 TO N 193+08 SOLID LT & RT  
 N 193+48 TO N 193+77 SOLID LT & RT  
 N 194+17 TO N 196+50 SOLID LT & RT

TEMPORARY 8 INCH WHITE LINE, PAINT  
 DURABLE 8 INCH WHITE LINE (OPTION ITEM)  
 N 190+69 TO N 190+81 SOLID LT (NO PARKING)

TEMPORARY CROSSWALK MARKING, PAINT  
 DURABLE CROSSWALK MARKING (OPTION ITEM)  
 N 192+22 LT TO RT


CLEANING CULV. PIPE, IN-PLACE  
 (0 TO 24 IN., INCL.)  
 N 191+11 TO N 191+30 RT  
 REHAB. DROP INLETS, CATCH BASINS,  
 OR MANHOLES, CLASS I, CLASS II  
 N 195+80 RT

PORTLAND CEMENT  
 CONCRETE SIDEWALK, 5 INCH  
 N 192+19 TO N 192+24 LT (RAMP TYPE 2)  
 N 192+19 TO N 192+24 RT (RAMP TYPE 2)

DETECTABLE WARNING SURFACE (DWS)  
 N 192+22 LT  
 N 192+22 RT

REMOVING SIGNS  
 AS SHOWN - 10

THINNING AND TRIMMING FOR SIGNS  
 N 193+00 RT

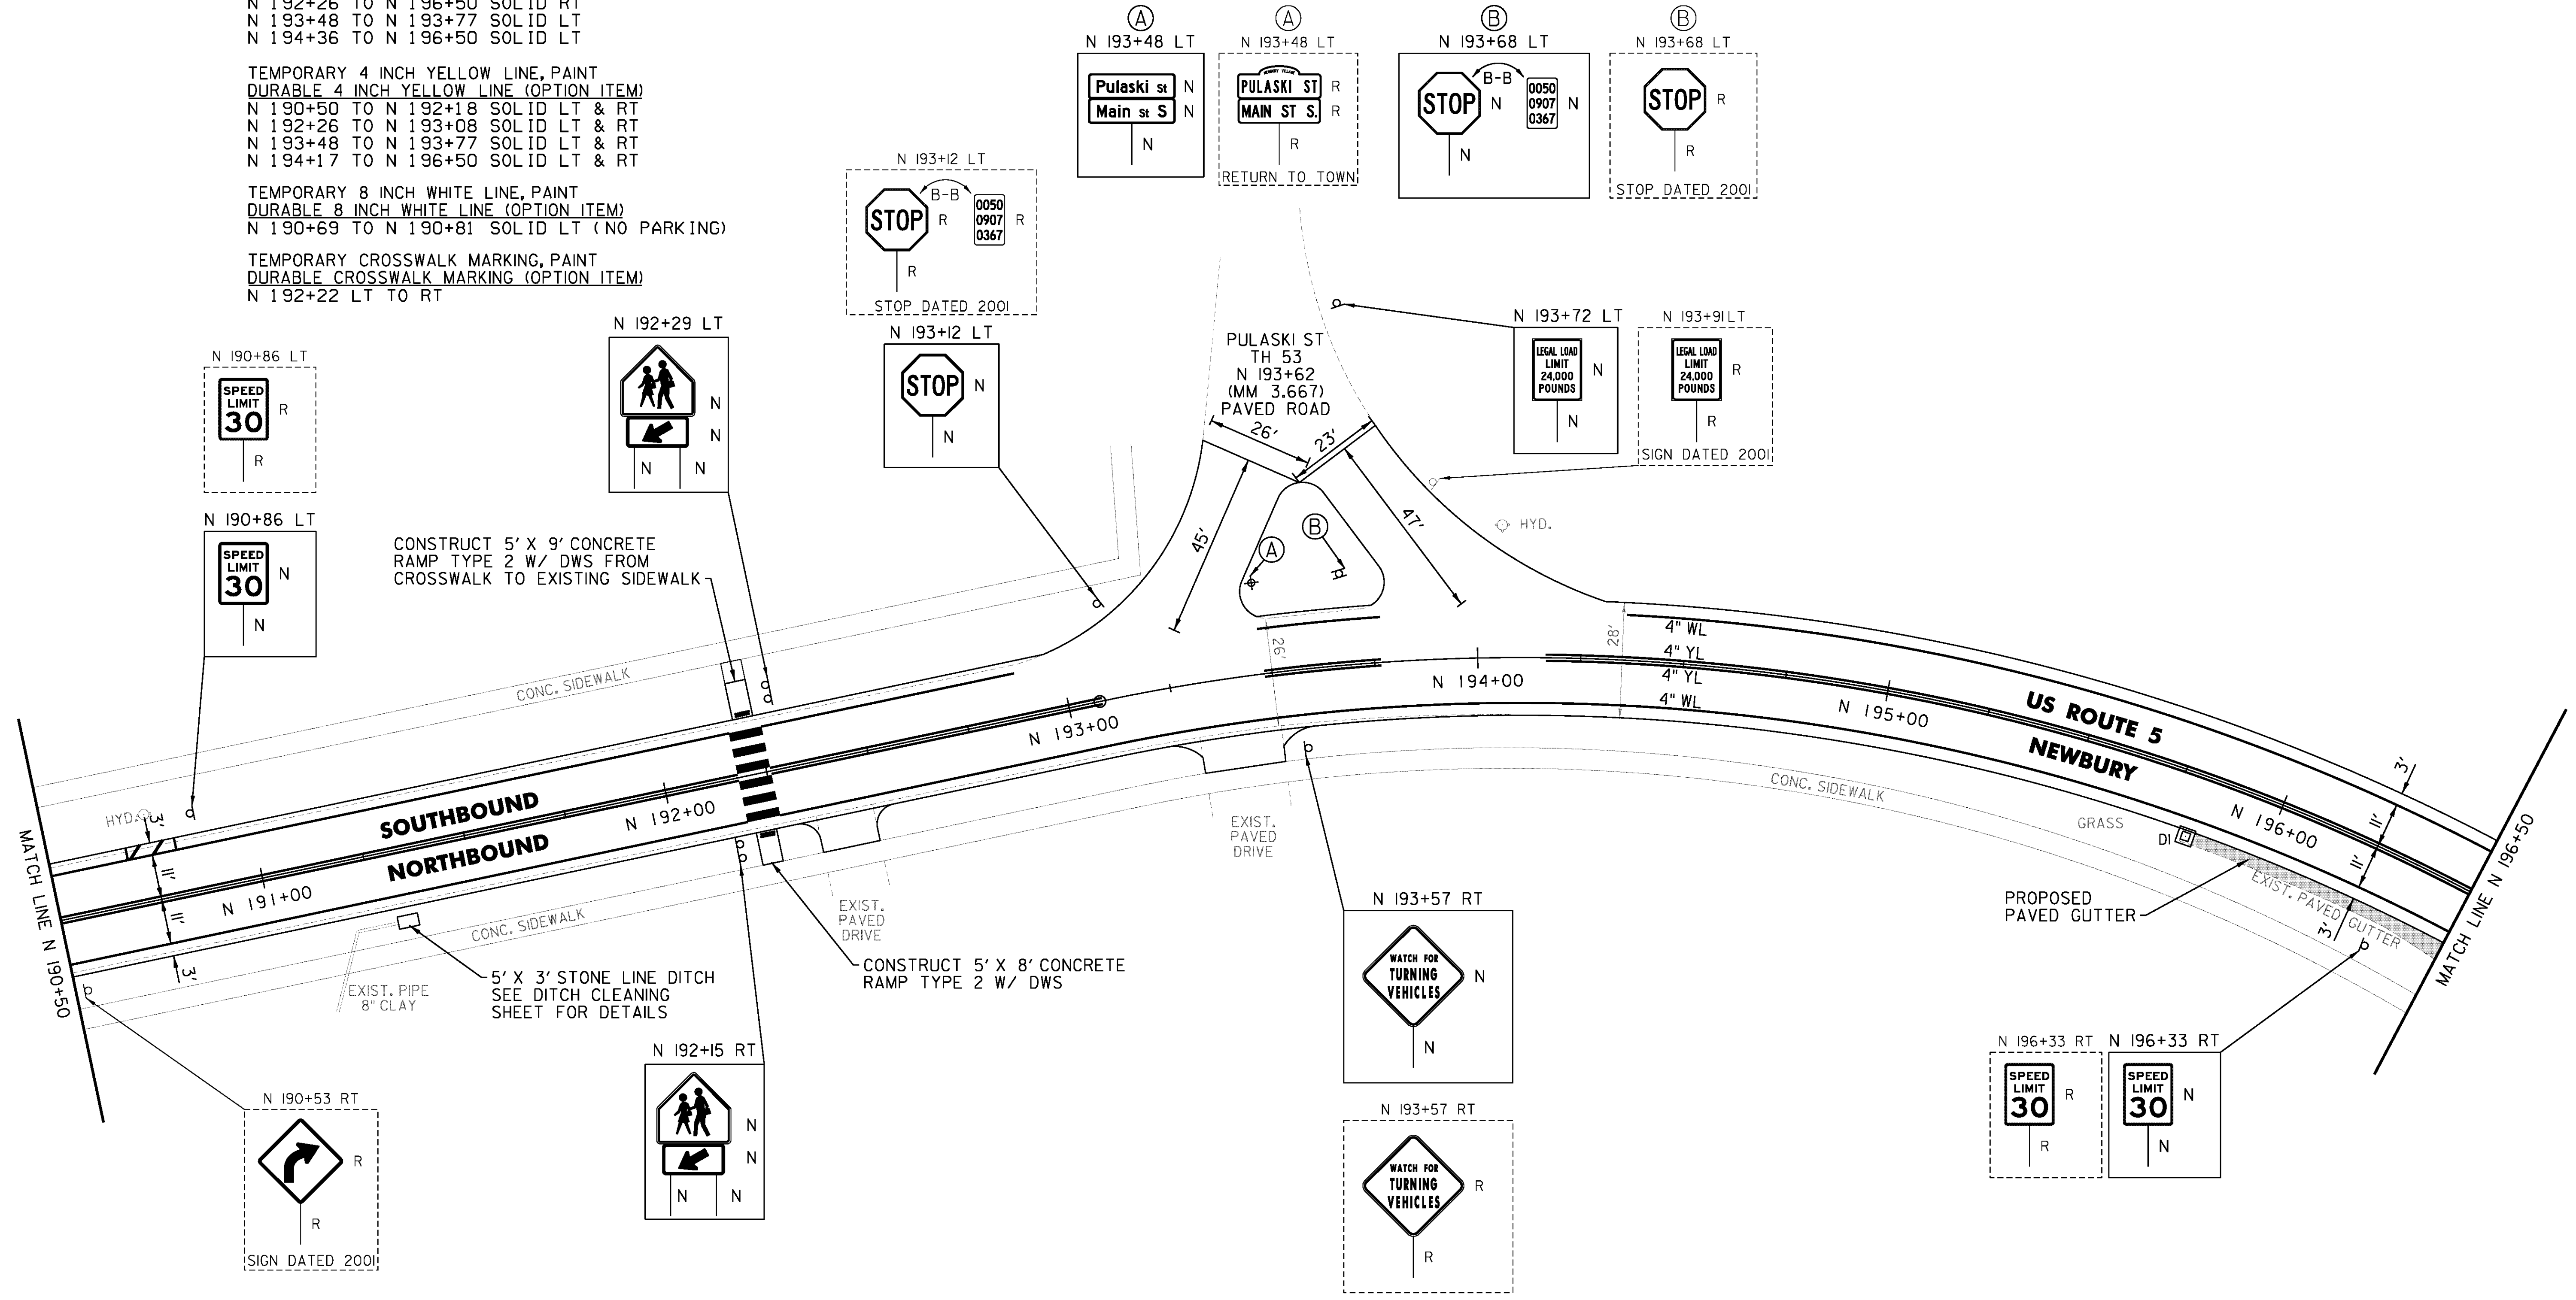

NOT TO SCALE

PROJECT NAME:	BRADFORD-RYEGATE
PROJECT NUMBER:	STP 2929(I)
FILE NAME:	z10c264bdr.dgn
PROJECT LEADER:	P. SHEDD
DESIGNED BY:	N. LEMAY
US 5 PLAN SHEET 72	
PLOT DATE:	2/4/2016
DRAWN BY:	W. GORDON
CHECKED BY:	P. SHEDD
SHEET	130 OF 239

GLD 14-0278