

TEMPORARY 4 INCH WHITE LINE, PAINT
 DURABLE 4 INCH WHITE LINE (OPTION ITEM)
 N 196+50 TO N 196+82 SOLID LT
 N 196+50 TO N 201+50 SOLID RT
 N 196+82 TO N 197+48 SOLID LT (TH 4)
 N 197+49 TO N 197+60 SOLID LT (TH 4)
 N 197+49 TO N 198+13 SOLID LT
 N 198+13 TO N 198+15 SOLID LT (TH 4)
 N 198+36 TO N 198+71 SOLID LT (TH 4)
 N 198+71 TO N 201+50 SOLID LT
 N 201+35 SOLID LT (NO PARKING)
 N 201+47 SOLID LT (NO PARKING)

TEMPORARY 4 INCH YELLOW LINE, PAINT
 DURABLE 4 INCH YELLOW LINE (OPTION ITEM)
 N 196+50 TO N 197+05 SOLID LT & RT
 N 197+35 TO N 197+54 DOUBLE SOLID LT (TH 4)
 N 197+45 TO N 198+15 SOLID LT & RT
 N 198+26 TO N 198+34 DOUBLE SOLID LT (TH 4)
 N 198+55 TO N 201+50 SOLID LT & RT

TEMPORARY 8 INCH WHITE LINE, PAINT
 DURABLE 8 INCH WHITE LINE (OPTION ITEM)
 N 201+35 TO N 201+47 SOLID LT (NO PARKING)


TEMPORARY 24 INCH STOP BAR, PAINT
 DURABLE 24 INCH STOP BAR (OPTION ITEM)
 N 197+14 TO N 197+33 LT (TH 4)
 N 198+22 TO N 198+33 LT (TH 4)

TEMPORARY LETTER OR SYMBOL, PAINT
 DURABLE LETTER OR SYMBOL (OPTION ITEM)
 N 197+34 LT "STOP" (TH 4)
 N 198+24 LT "STOP" (TH 4)

PAINTED CURB
 N 197+53 TO N 198+20 LT

REHAB. DROP INLETS, CATCH BASINS,
 OR MANHOLES, CLASS I, CLASS II
 N 197+59 LT
 N 200+03 RT

REMOVING SIGNS
 AS SHOWN - 10

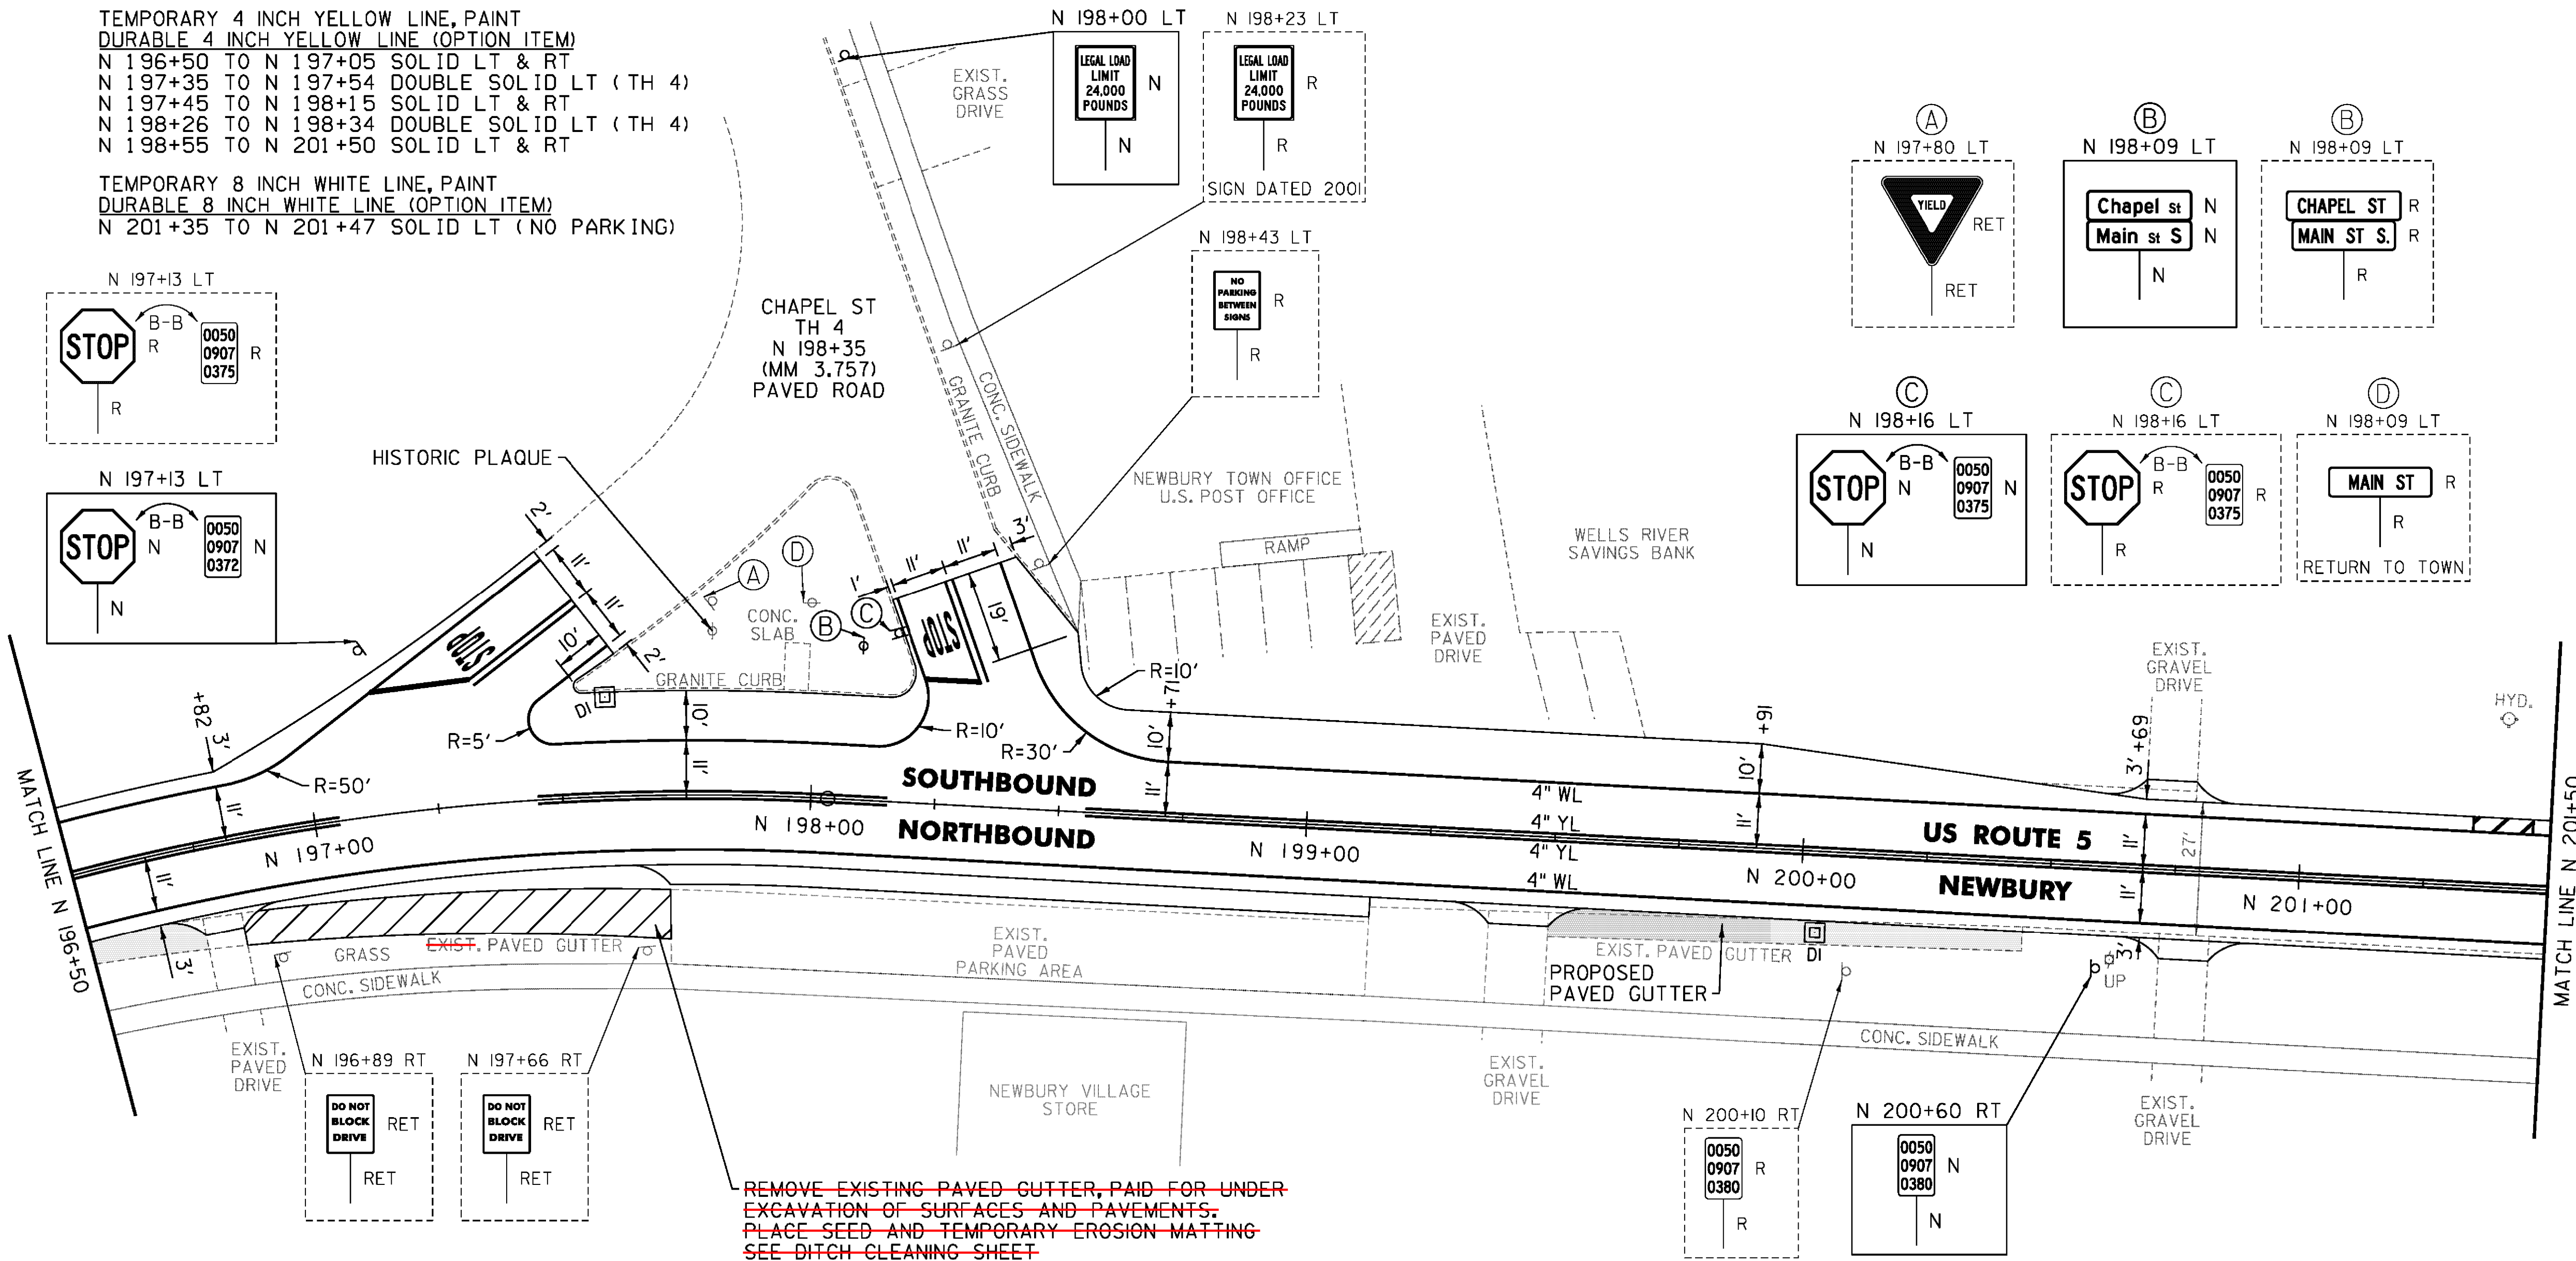

REMOVE EXISTING PAVED GUTTER, PAID FOR UNDER EXCAVATION OF SURFACES AND PAYEMENTS. PLACE SEED AND TEMPORARY EROSION MATTING. SEE DITCH CLEANING SHEET.

NOT TO SCALE

PROJECT NAME:	BRADFORD-RYEGATE
PROJECT NUMBER:	STP 2929(I)
FILE NAME:	z10c264bdr.dgn
PROJECT LEADER:	P. SHEDD
DESIGNED BY:	N. LEMAY
US 5 PLAN SHEET 73	
PLOT DATE:	2/4/2016
DRAWN BY:	W. GORDON
CHECKED BY:	P. SHEDD
SHEET	131 OF 239