

TEMPORARY 4 INCH WHITE LINE, PAINT
 DURABLE 4 INCH WHITE LINE (OPTION ITEM)
 N 247+50 TO N 253+50 SOLID LT & RT

TEMPORARY 4 INCH YELLOW LINE, PAINT
 DURABLE 4 INCH YELLOW LINE (OPTION ITEM)
 N 247+50 TO N 253+50 SOLID LT & RT


STEEL BEAM GUARDRAIL, GALVANIZED
 N 247+58 TO N 250+83 RT

ANCHOR FOR STEEL BEAM RAIL
 2' (SEE STANDARD G-1d)

REMOVAL AND DISPOSAL OF GUARDRAIL
 N 248+08 TO N 250+83 RT

DELINEATOR WITH STEEL POST
 N 248+07 RT
 N 250+83 RT

REMOVING SIGNS
 AS SHOWN - 3

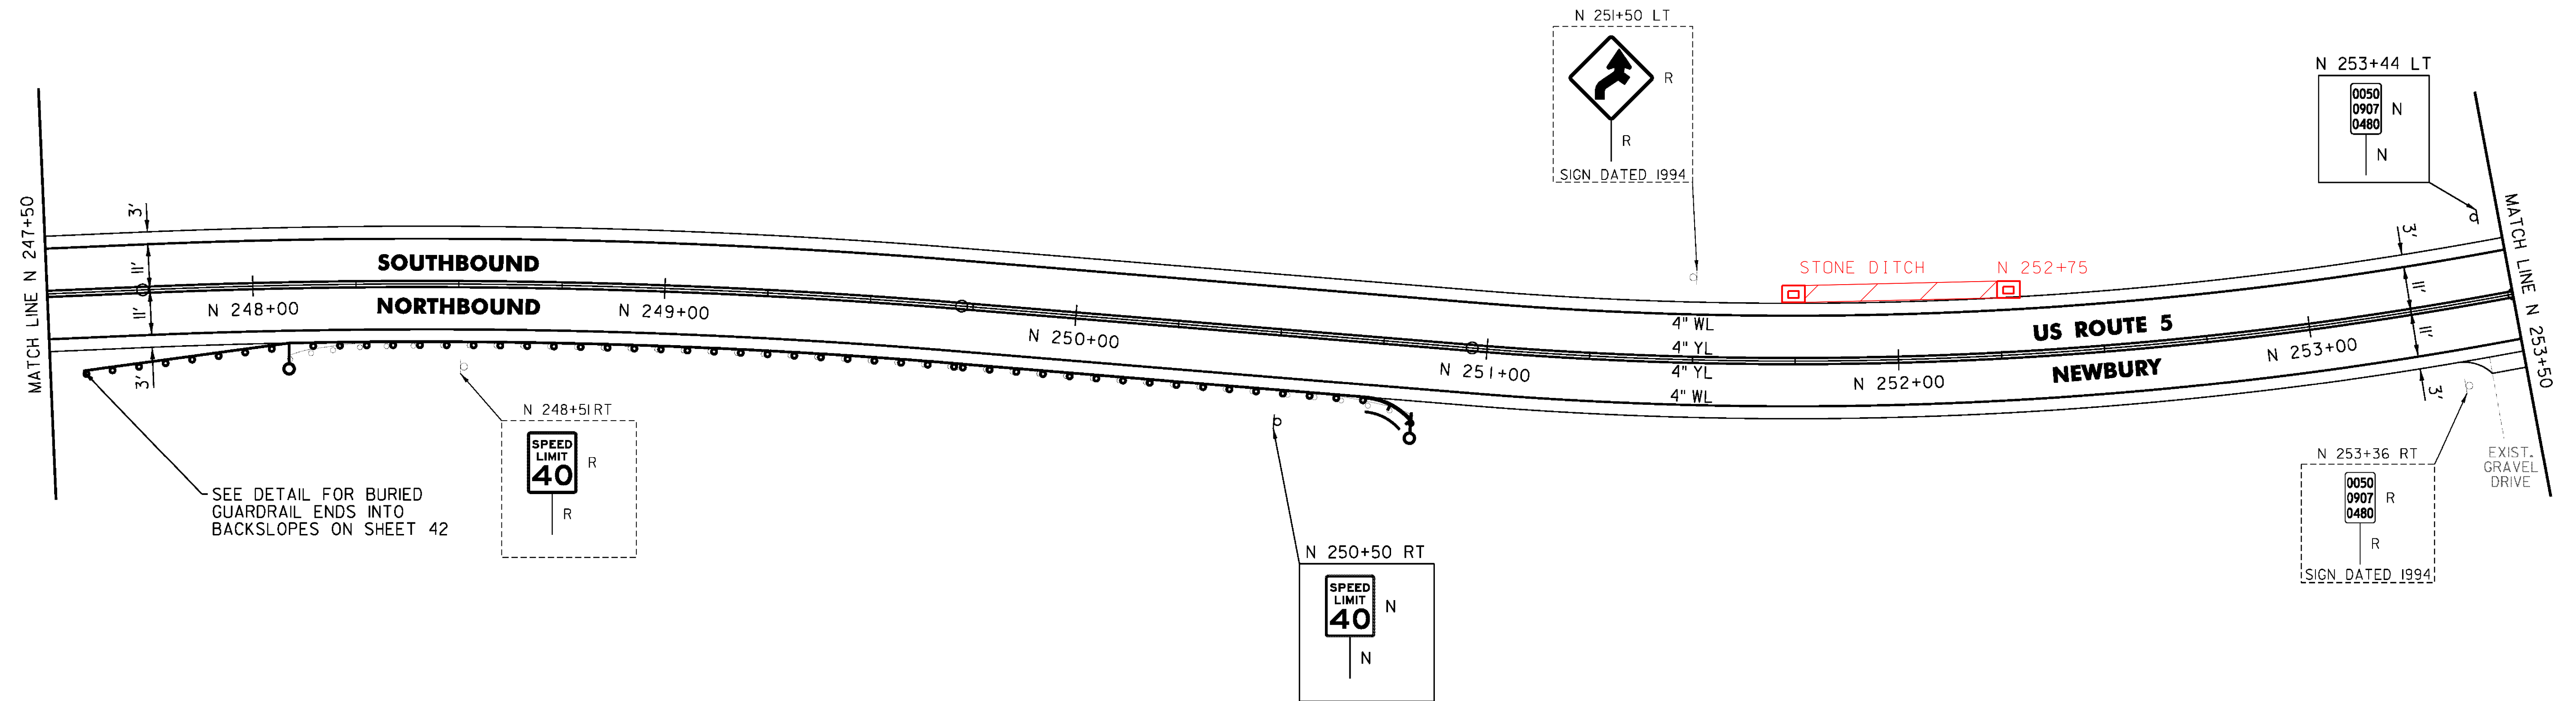

SEE DETAIL FOR BURIED
 GUARDRAIL ENDS INTO
 BACKSLOPES ON SHEET 42

NOT TO SCALE

PROJECT NAME:	BRADFORD-RYEGATE
PROJECT NUMBER:	STP 2929(I)
FILE NAME:	z10c264bdr.dgn
PROJECT LEADER:	P. SHEDD
DESIGNED BY:	N. LEMAY
US 5 PLAN SHEET 82	
PLOT DATE:	2/4/2016
DRAWN BY:	W. GORDON
CHECKED BY:	P. SHEDD
SHEET	140 OF 239