


TEMPORARY 4 INCH WHITE LINE, PAINT
 DURABLE 4 INCH WHITE LINE (OPTION ITEM)
 N 259+50 TO N 265+50 SOLID LT & RT
 N 261+03 SOLID LT (NO PARKING)
 N 261+15 SOLID LT (NO PARKING)

REMOVING SIGNS
 AS SHOWN - 3

TEMPORARY 4 INCH YELLOW LINE, PAINT
 DURABLE 4 INCH YELLOW LINE (OPTION ITEM)
 N 259+50 TO N 265+50 SOLID LT & RT

TEMPORARY 8 INCH WHITE LINE, PAINT
 DURABLE 8 INCH WHITE LINE (OPTION ITEM)
 N 261+03 TO N 261+15 SOLID LT (NO PARKING)

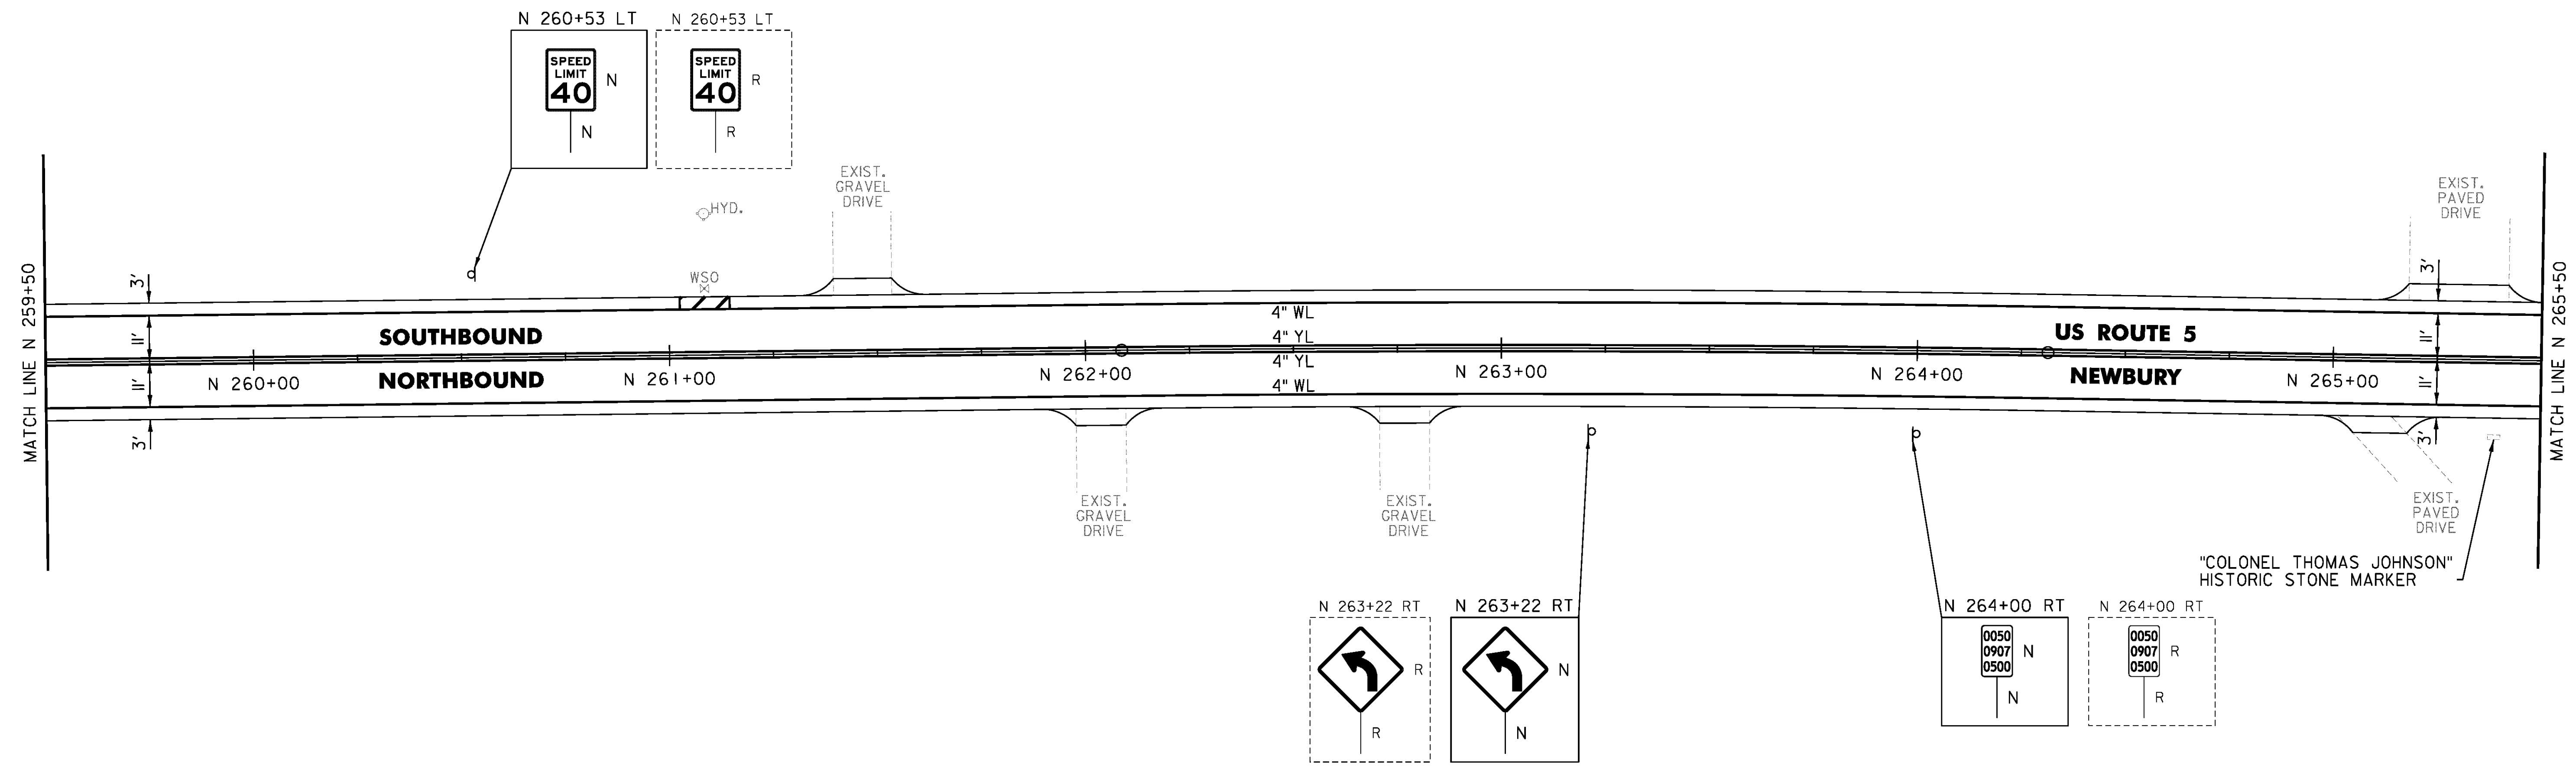

CLD 14-0278

NOT TO SCALE

| | |
|--------------------------------|----------------------|
| PROJECT NAME: BRADFORD-RYEGATE | |
| PROJECT NUMBER: STP 2929(I) | |
| FILE NAME: z10c264bdr.dgn | PLOT DATE: 2/4/2016 |
| PROJECT LEADER: P. SHEDD | DRAWN BY: W. GORDON |
| DESIGNED BY: N. LEMAY | CHECKED BY: P. SHEDD |
| US 5 PLAN SHEET 84 | SHEET 142 OF 239 |