

TEMPORARY 4 INCH WHITE LINE, PAINT  
 DURABLE 4 INCH WHITE LINE (OPTION ITEM)  
 N 301+50 TO N 307+50 SOLID LT & RT

TEMPORARY 4 INCH YELLOW LINE, PAINT  
 DURABLE 4 INCH YELLOW LINE, EPOXY PAINT OR  
 DURABLE 4 INCH YELLOW LINE, POLYUREA (OPTION ITEM)  
 N 301+50 TO N 307+50 DASHED LT, SOLID RT

STEEL BEAM GUARDRAIL, GALVANIZED  
 N 304+61.5 TO N 307+50 RT  
 N 306+20 TO N 307+50 LT


ANCHOR FOR STEEL BEAM RAIL  
 2 (SEE STANDARD G-1d)

REMOVAL AND DISPOSAL OF GUARDRAIL  
 N 304+64 TO N 307+50 RT  
 N 306+18 TO N 307+50 LT

DELINEATOR WITH STEEL POST  
 N 304+61.5 RT  
 N 306+20 LT

MILLED RUMBLE STRIPS  
 N 301+50 TO N 307+50 CL

REMOVING SIGNS  
 AS SHOWN - 1

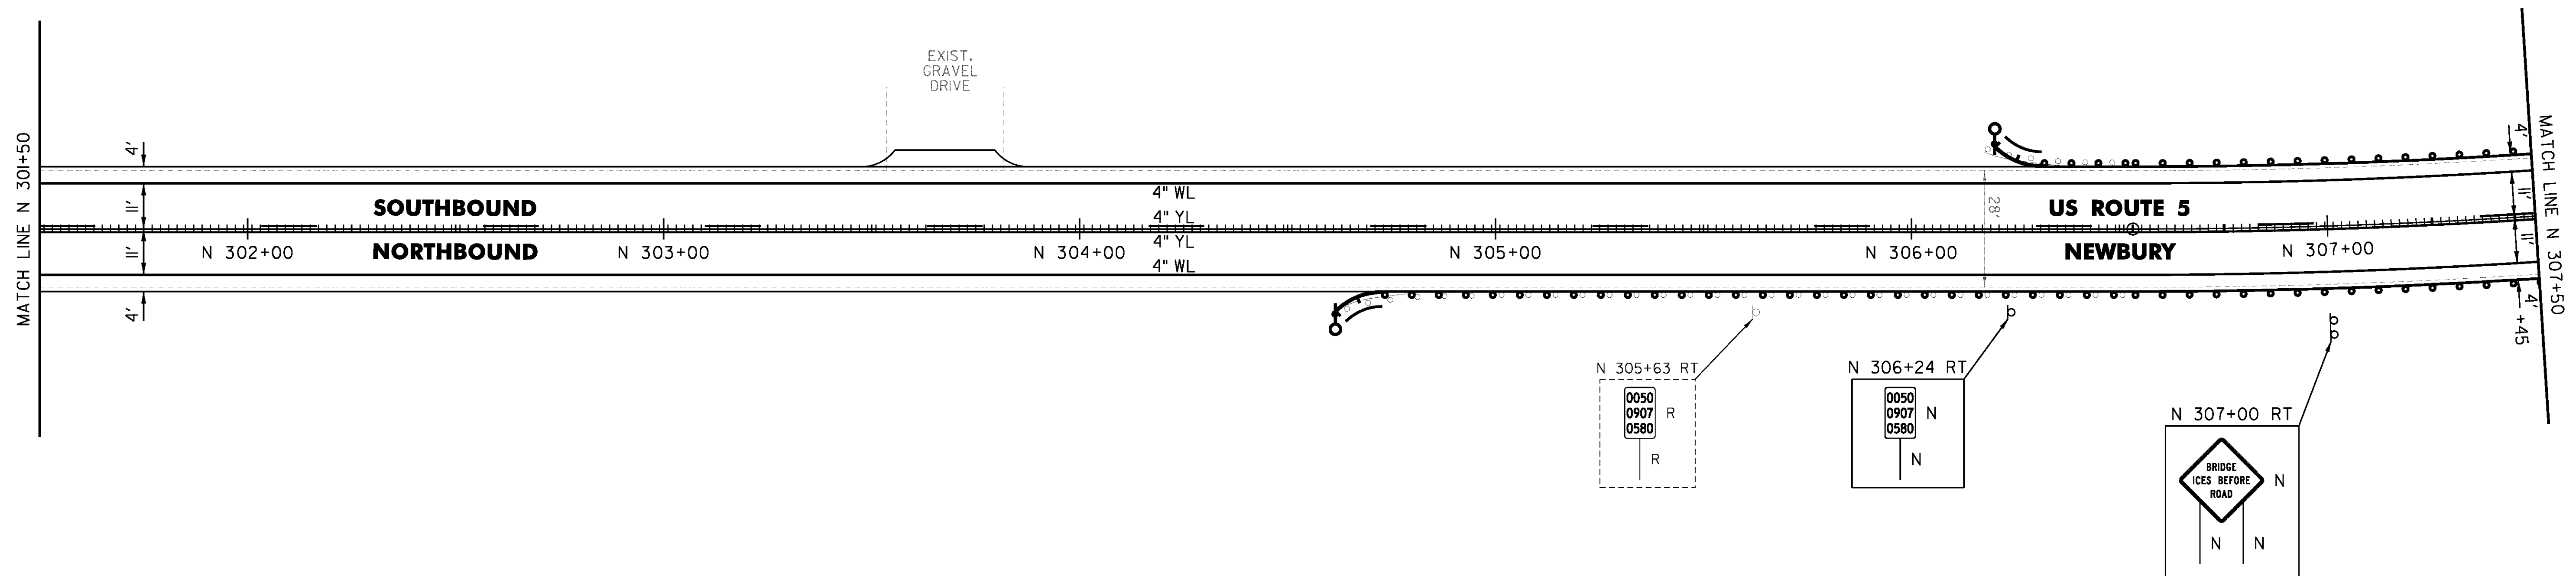

CLD 14-0278

NOT TO SCALE

PROJECT NAME: BRADFORD-RYEGATE	PLOT DATE: 2/4/2016
PROJECT NUMBER: STP 2929(I)	DRAWN BY: W. GORDON
FILE NAME: z10c264bdr.dgn	CHECKED BY: P. SHEDD
PROJECT LEADER: P. SHEDD	SHEET 149 OF 239
DESIGNED BY: N. LEMAY	
US 5 PLAN SHEET 9I	