

TEMPORARY 4 INCH WHITE LINE, PAINT
 DURABLE 4 INCH WHITE LINE (OPTION ITEM)
 N 325+50 TO N 331+50 SOLID LT & RT

TEMPORARY 4 INCH YELLOW LINE, PAINT
 DURABLE 4 INCH YELLOW LINE, EPOXY PAINT OR
 DURABLE 4 INCH YELLOW LINE, POLYUREA (OPTION ITEM)
 N 325+50 TO N 327+65 SOLID LT & RT
 N 327+65 TO N 331+50 SOLID LT, DASHED RT

STEEL BEAM GUARDRAIL, GALVANIZED
 N 326+53.5 TO N 326+91 RT
 N 329+25 TO N 329+62.5 RT
 N 331+33 TO N 331+50 LT

ANCHOR FOR STEEL BEAM RAIL
 3 (SEE STANDARD G-1d)


REMOVAL AND DISPOSAL OF GUARDRAIL
 N 326+53.5 TO N 326+91 RT
 N 329+25 TO N 329+62.5 RT
 N 331+33 TO N 331+50 LT

DELINEATOR WITH STEEL POST
 N 326+91 RT
 N 329+25 RT
 N 331+33 LT

REMOVE AND RESET GUARDRAIL
 N 325+50 TO N 326+53.5 RT
 N 329+62.5 TO N 331+50 RT

MILLED RUMBLE STRIPS
 N 325+50 TO N 331+50 CL

REMOVING SIGNS
 AS SHOWN - 1

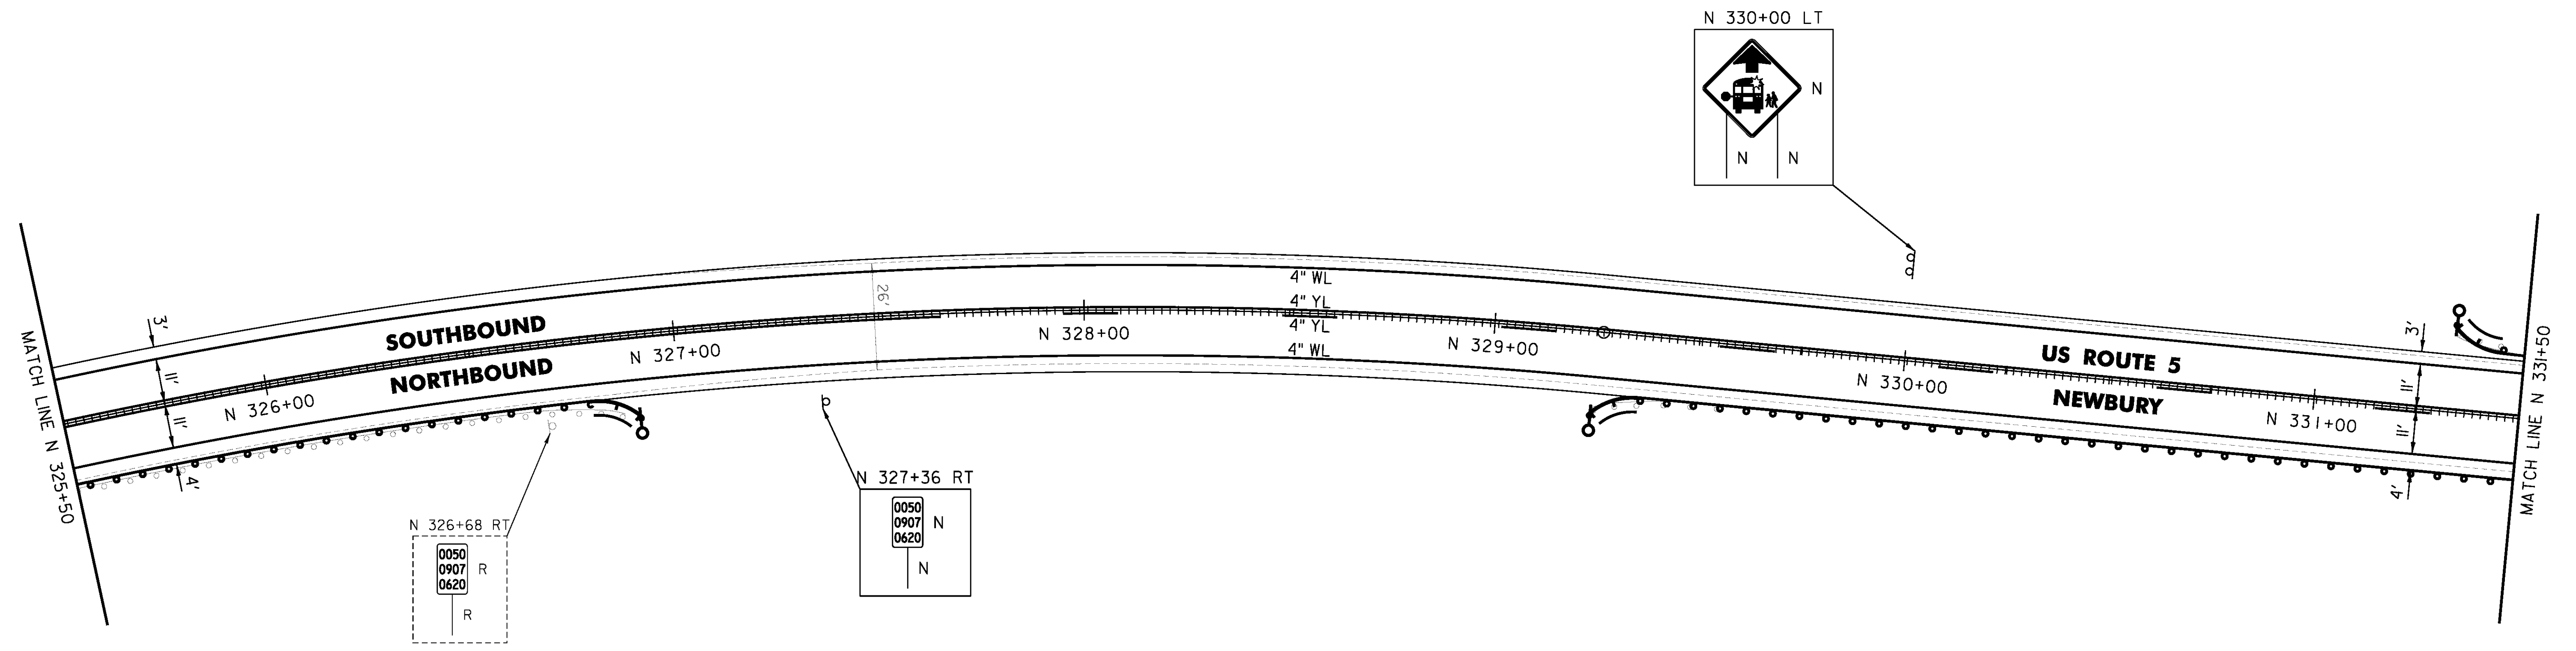

CLD 14-0278

NOT TO SCALE

PROJECT NAME: BRADFORD-RYEGATE	
PROJECT NUMBER: STP 2929(I)	
FILE NAME: z10c264bdr.dgn	PLOT DATE: 2/4/2016
PROJECT LEADER: P. SHEDD	DRAWN BY: W. GORDON
DESIGNED BY: N. LEMAY	CHECKED BY: P. SHEDD
US 5 PLAN SHEET 95	SHEET 153 OF 239