

TEMPORARY 4 INCH WHITE LINE, PAINT
 DURABLE 4 INCH WHITE LINE (OPTION ITEM)
 N 343+50 TO N 349+50 SOLID LT & RT

TEMPORARY 4 INCH YELLOW LINE, PAINT
 DURABLE 4 INCH YELLOW LINE, EPOXY PAINT OR
 DURABLE 4 INCH YELLOW LINE, POLYUREA (OPTION ITEM)
 N 343+50 TO N 349+50 SOLID LT & RT

STEEL BEAM GUARDRAIL, GALVANIZED
 N 344+80.5 TO N 345+18 LT
 N 346+85.5 TO N 347+23 LT

ANCHOR FOR STEEL BEAM RAIL
 2' (SEE STANDARD G-1d)



REMOVAL AND DISPOSAL OF GUARDRAIL
 N 344+80.5 TO N 345+18 LT
 N 346+85.5 TO N 347+23 LT

DELINEATOR WITH STEEL POST
 N 344+80.5 LT
 N 347+23 LT

MILLED RUMBLE STRIPS
 N 343+50 TO N 349+50 CL

REMOVE AND RESET GUARDRAIL
 N 343+50 TO N 349+50 RT
 N 345+18 TO N 346+85.5 LT

REMOVING SIGNS
 AS SHOWN - 1

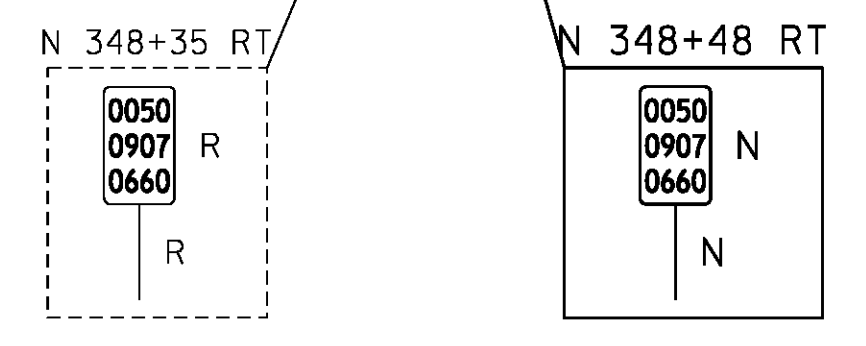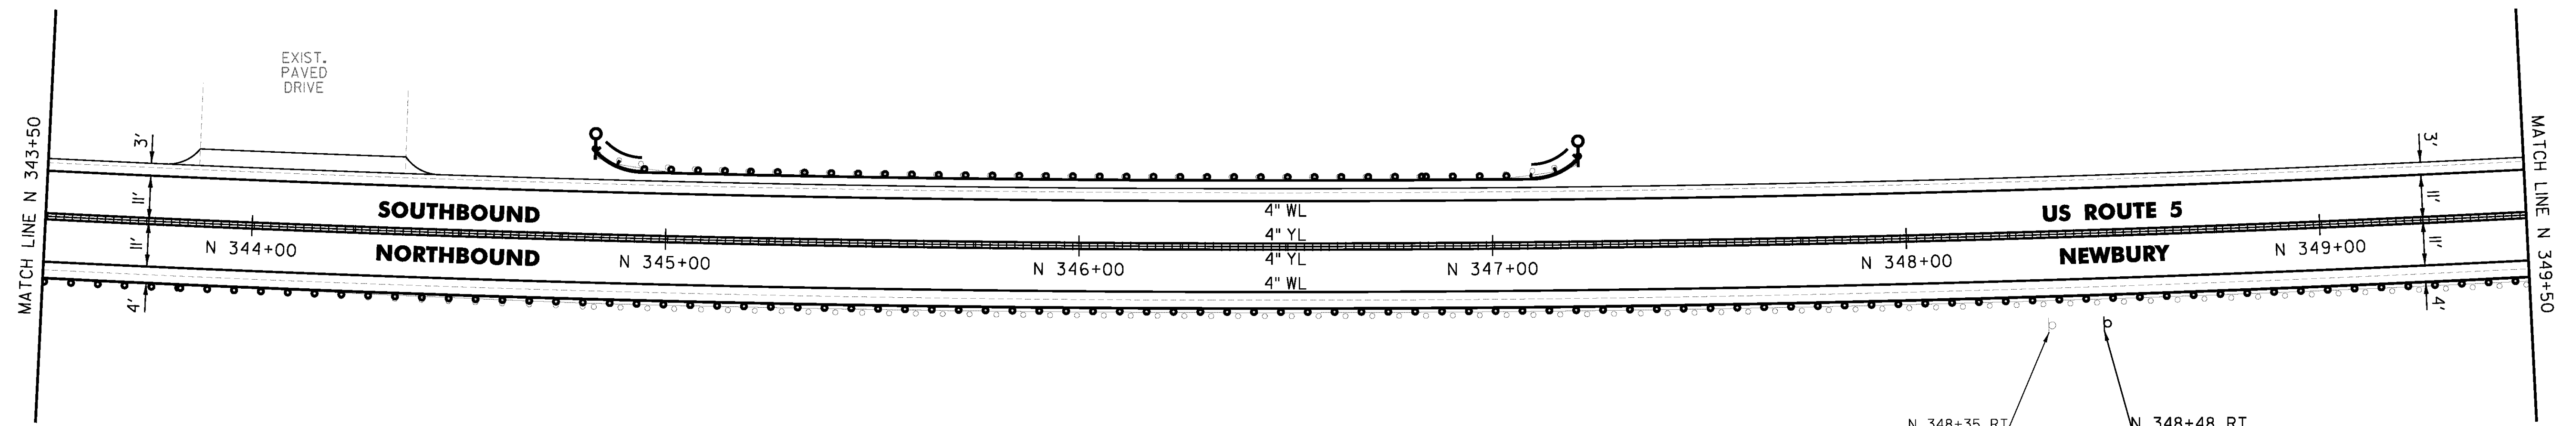

CLD 14-0278

NOT TO SCALE

PROJECT NAME: BRADFORD-RYEGATE	PLOT DATE: 2/4/2016
PROJECT NUMBER: STP 2929(I)	DRAWN BY: W. GORDON
FILE NAME: z10c264bdr.dgn	CHECKED BY: P. SHEDD
PROJECT LEADER: P. SHEDD	SHEET 156 OF 239
DESIGNED BY: N. LEMAY	
US 5 PLAN SHEET 98	