

TEMPORARY 4 INCH WHITE LINE, PAINT
DURABLE 4 INCH WHITE LINE (OPTION ITEM)
N 373+50 TO N 379+50 SOLID LT & RT

TEMPORARY 4 INCH YELLOW LINE, PAINT
N 373+50 TO N 379+50 DASHED CL

DURABLE 4 INCH YELLOW LINE (OPTION ITEM)
N 378+00 TO N 379+50 DASHED CL

DURABLE 4 INCH YELLOW LINE, EPOXY PAINT OR
DURABLE 4 INCH YELLOW LINE, POLYUREA (OPTION ITEM)
N 373+50 TO N 378+00 DASHED CL


REMOVE AND RESET GUARDRAIL
N 373+50 TO N 379+50 RT

STEEL BEAM GUARDRAIL, GALVANIZED
N 373+50 TO N 379+50 LT

REMOVAL AND DISPOSAL OF GUARDRAIL
N 373+50 TO N 379+50 LT

MILLED RUMBLE STRIPS
N 373+50 TO N 378+00 CL

REMOVING SIGNS
AS SHOWN - 1

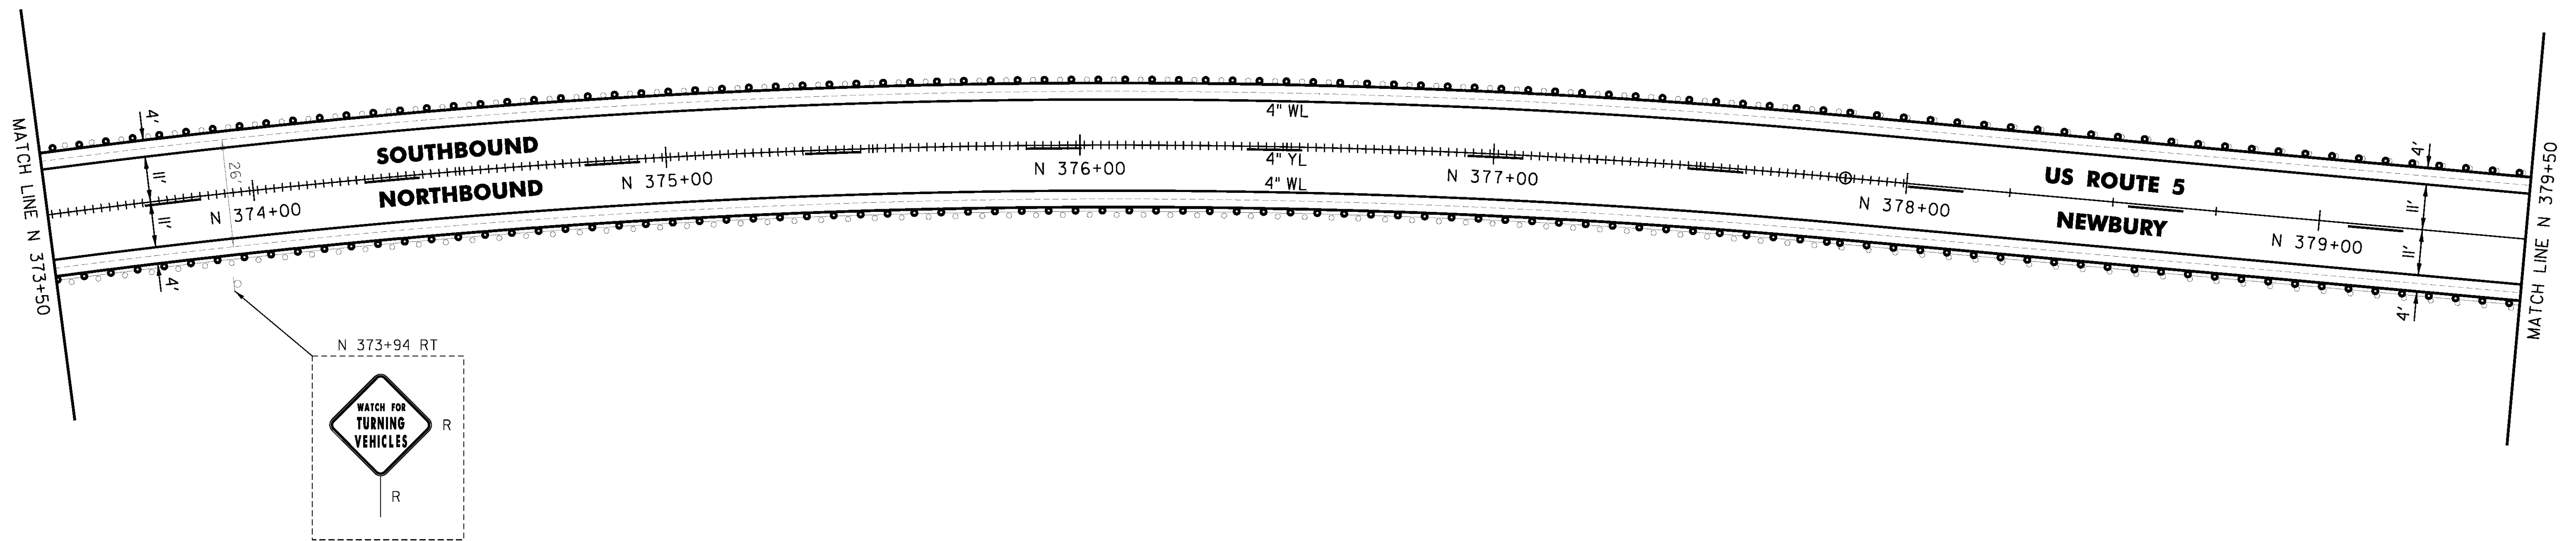

CLD 14-0278

NOT TO SCALE

PROJECT NAME: BRADFORD-RYEGATE	PLOT DATE: 2/4/2016
PROJECT NUMBER: STP 2929(I)	DRAWN BY: W. GORDON
FILE NAME: z10c264bdr.dgn	CHECKED BY: P. SHEDD
DESIGNED BY: N. LEMAY	SHEET 161 OF 239
US 5 PLAN SHEET 103	