

TEMPORARY 4 INCH WHITE LINE, PAINT  
 DURABLE 4 INCH WHITE LINE (OPTION ITEM)  
 N 384+50 TO N 390+50 SOLID LT & RT

TEMPORARY 4 INCH YELLOW LINE, PAINT  
 DURABLE 4 INCH YELLOW LINE, EPOXY PAINT OR  
 DURABLE 4 INCH YELLOW LINE, POLYUREA (OPTION ITEM)  
 N 384+50 TO N 390+50 DASHED CL

STEEL BEAM GUARDRAIL, GALVANIZED  
 N 384+50 TO N 384+97.5 LT  
 N 385+05.5 LT (12.5')  
 N 388+01 LT (12.5')  
 N 388+08.5 RT (12.5')  
 N 388+09 TO N 388+21.5 LT  
 N 388+28.5 RT (12.5')

REMOVE AND RESET GUARDRAIL  
 N 384+50 TO N 388+00 RT  
 N 388+21.5 TO N 390+50 LT  
 N 388+36.5 TO N 390+50 RT

REMOVAL AND DISPOSAL OF GUARDRAIL  
 N 384+50 TO N 385+04 LT  
 N 388+00 TO N 388+09 RT  
 N 388+04 TO N 388+21.5 LT  
 N 388+28 TO N 388+36 RT


DELINEATOR WITH STEEL POST  
 N 384+97.5 LT  
 N 388+00 RT  
 N 388+12 LT  
 N 388+36.5 RT

SPECIAL PROVISION (STEEL BEAM  
 GUARDRAIL GALVANIZED) (8 FEET RADIUS)

~~N 384+97.5 LT~~  
 N 388+00 RT  
 N 388+09 LT  
 N 388+36.5 RT

MILLED RUMBLE STRIPS  
 N 384+50 TO N 390+50 CL

ANCHOR FOR SBGR  
 IEA STA384+97.5 LT

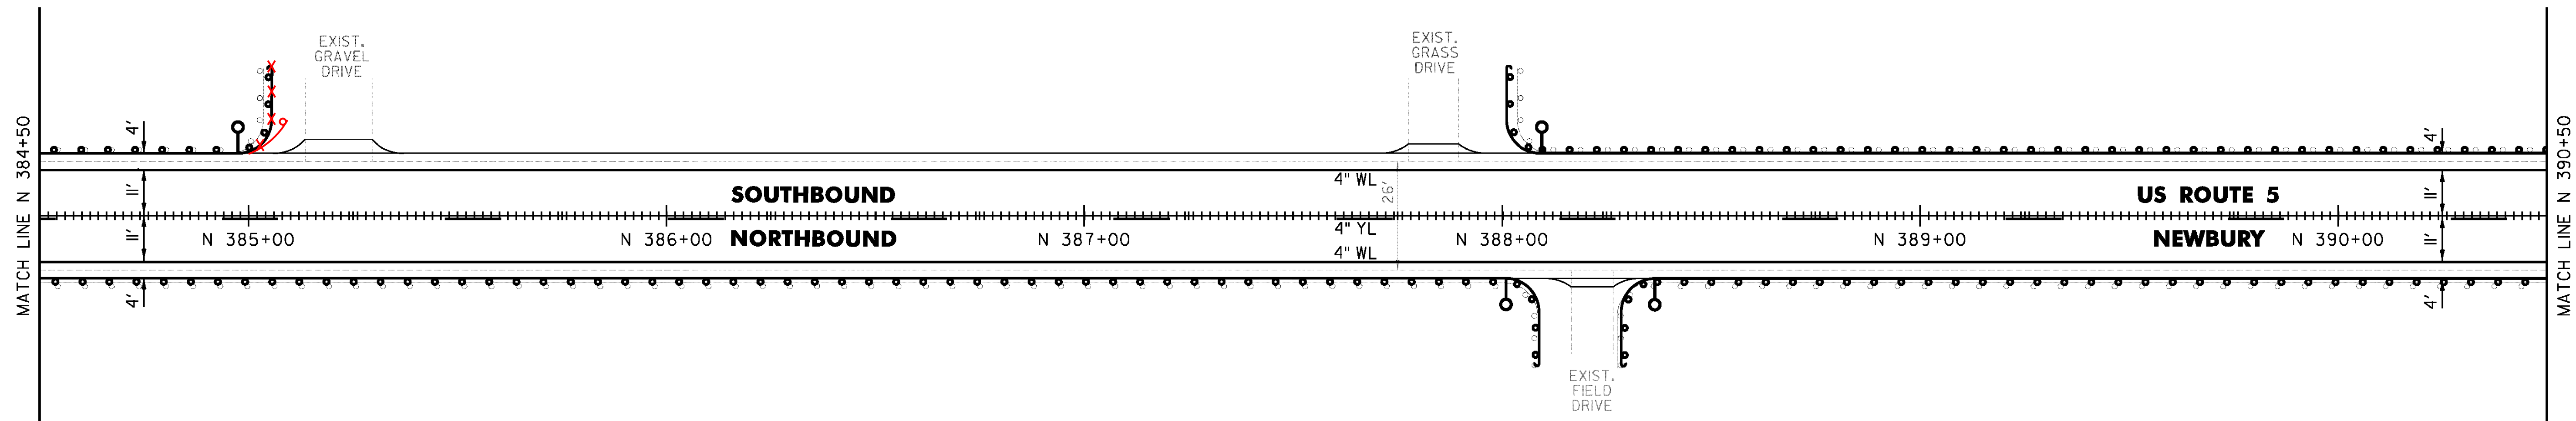

CLD 14-0278

NOT TO SCALE

PROJECT NAME: BRADFORD-RYEGATE	PLOT DATE: 2/4/2016
PROJECT NUMBER: STP 2929(I)	DRAWN BY: W. GORDON
FILE NAME: z10c264bdr.dgn	CHECKED BY: P. SHEDD
PROJECT LEADER: P. SHEDD	SHEET 163 OF 239
DESIGNED BY: N. LEMAY	
US 5 PLAN SHEET 105	