


TEMPORARY 4 INCH WHITE LINE, PAINT
 DURABLE 4 INCH WHITE LINE (OPTION ITEM)
 N 396+50 TO N 401+50 SOLID LT & RT

TEMPORARY 4 INCH YELLOW LINE, PAINT
 DURABLE 4 INCH YELLOW LINE, EPOXY PAINT OR
 DURABLE 4 INCH YELLOW LINE, POLYUREA (OPTION ITEM)
 N 396+50 TO N 399+15 DASHED CL
 N 399+15 TO N 401+50 DASHED LT, SOLID RT

REMOVE AND RESET GUARDRAIL
 N 396+50 TO N 401+50 LT
 N 396+50 TO N 401+50 RT

MILLED RUMBLE STRIPS
 N 396+50 TO N 401+50 CL

REMOVING SIGNS
 AS SHOWN - 1

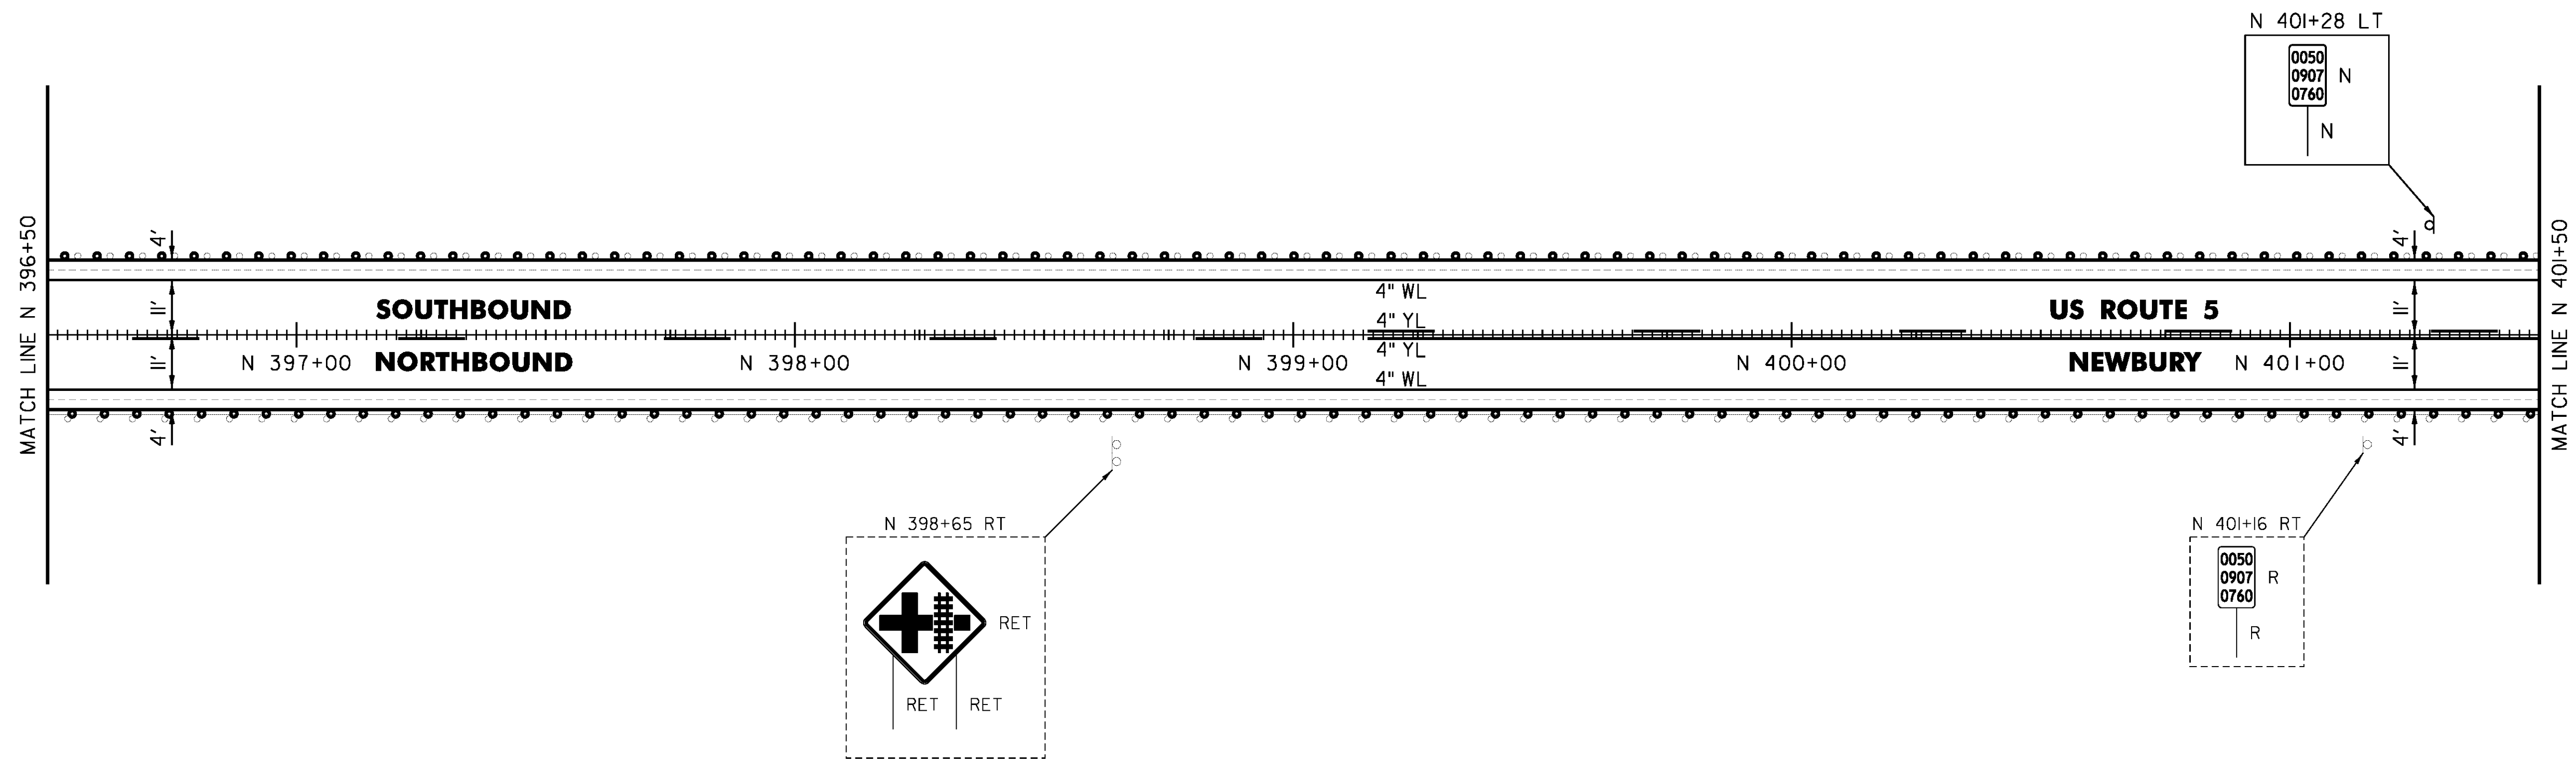

CLD 14-0278

NOT TO SCALE

PROJECT NAME: BRADFORD-RYEGATE	PROJECT NUMBER: STP 2929(I)
FILE NAME: z10c264bdr.dgn	PLOT DATE: 2/4/2016
PROJECT LEADER: P. SHEDD	DRAWN BY: W. GORDON
DESIGNED BY: N. LEMAY	CHECKED BY: P. SHEDD
US 5 PLAN SHEET 107	SHEET 165 OF 239