

TEMPORARY 4 INCH WHITE LINE, PAINT
DURABLE 4 INCH WHITE LINE (OPTION ITEM)
N 449+50 TO N 455+50 SOLID LT & RT

TEMPORARY 4 INCH YELLOW LINE, PAINT
N 449+50 TO N 455+50 SOLID LT & RT


DURABLE 4 INCH YELLOW LINE (OPTION ITEM)
N 449+50 TO N 450+25 SOLID LT & RT

DURABLE 4 INCH YELLOW LINE, EPOXY PAINT OR
DURABLE 4 INCH YELLOW LINE, POLYUREA (OPTION ITEM)
N 450+25 TO N 455+50 SOLID LT & RT

REMOVE AND RESET GUARDRAIL
N 449+50 TO N 455+50 RT

MILLED RUMBLE STRIPS
N 450+25 TO N 455+50 CL

REMOVING SIGNS
AS SHOWN - 1

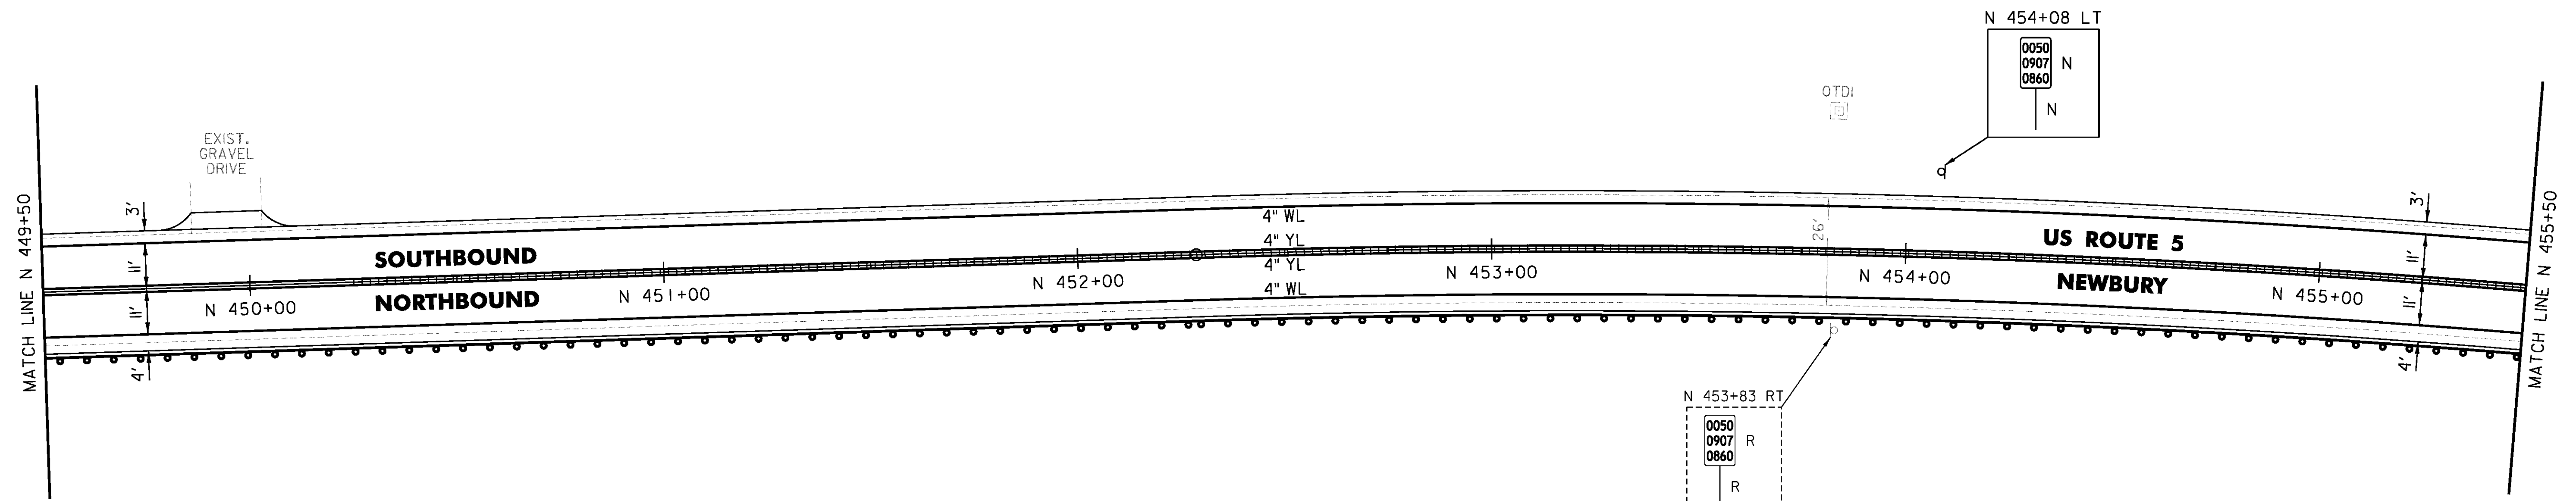

CLD 14-0278

NOT TO SCALE

PROJECT NAME: BRADFORD-RYEGATE

PROJECT NUMBER: STP 2929(I)

FILE NAME: z10c264bdr.dgn

PROJECT LEADER: P. SHEDD

DESIGNED BY: N. LEMAY

US 5 PLAN SHEET 116

PLOT DATE: 2/4/2016

DRAWN BY: W. GORDON

CHECKED BY: P. SHEDD

SHEET 174 OF 239