

TEMPORARY 4 INCH WHITE LINE, PAINT
 DURABLE 4 INCH WHITE LINE (OPTION ITEM)
 N 461+50 TO N 467+50 SOLID LT & RT

TEMPORARY 4 INCH YELLOW LINE, PAINT
 N 461+50 TO N 467+50 SOLID LT & RT

DURABLE 4 INCH YELLOW LINE (OPTION ITEM)
 N 465+93 TO N 467+50 SOLID LT & RT

DURABLE 4 INCH YELLOW LINE, EPOXY PAINT OR
 DURABLE 4 INCH YELLOW LINE, POLYUREA (OPTION ITEM)
 N 461+50 TO N 465+93 SOLID LT & RT

STEEL BEAM GUARDRAIL, GALVANIZED
 N 464+83 TO N 465+20.5 LT

ANCHOR FOR STEEL BEAM RAIL
 1' (SEE STANDARD G-1d)


REMOVE AND RESET GUARDRAIL
 N 461+50 TO N 467+50 RT
 N 465+20.5 TO N 467+50 LT

REMOVAL AND DISPOSAL OF GUARDRAIL
 N 464+83 TO N 465+20.5 LT

DELINEATOR WITH STEEL POST
 N 464+83 LT

MILLED RUMBLE STRIPS
 N 461+50 TO N 465+93 CL

REMOVING SIGNS
 AS SHOWN - 4

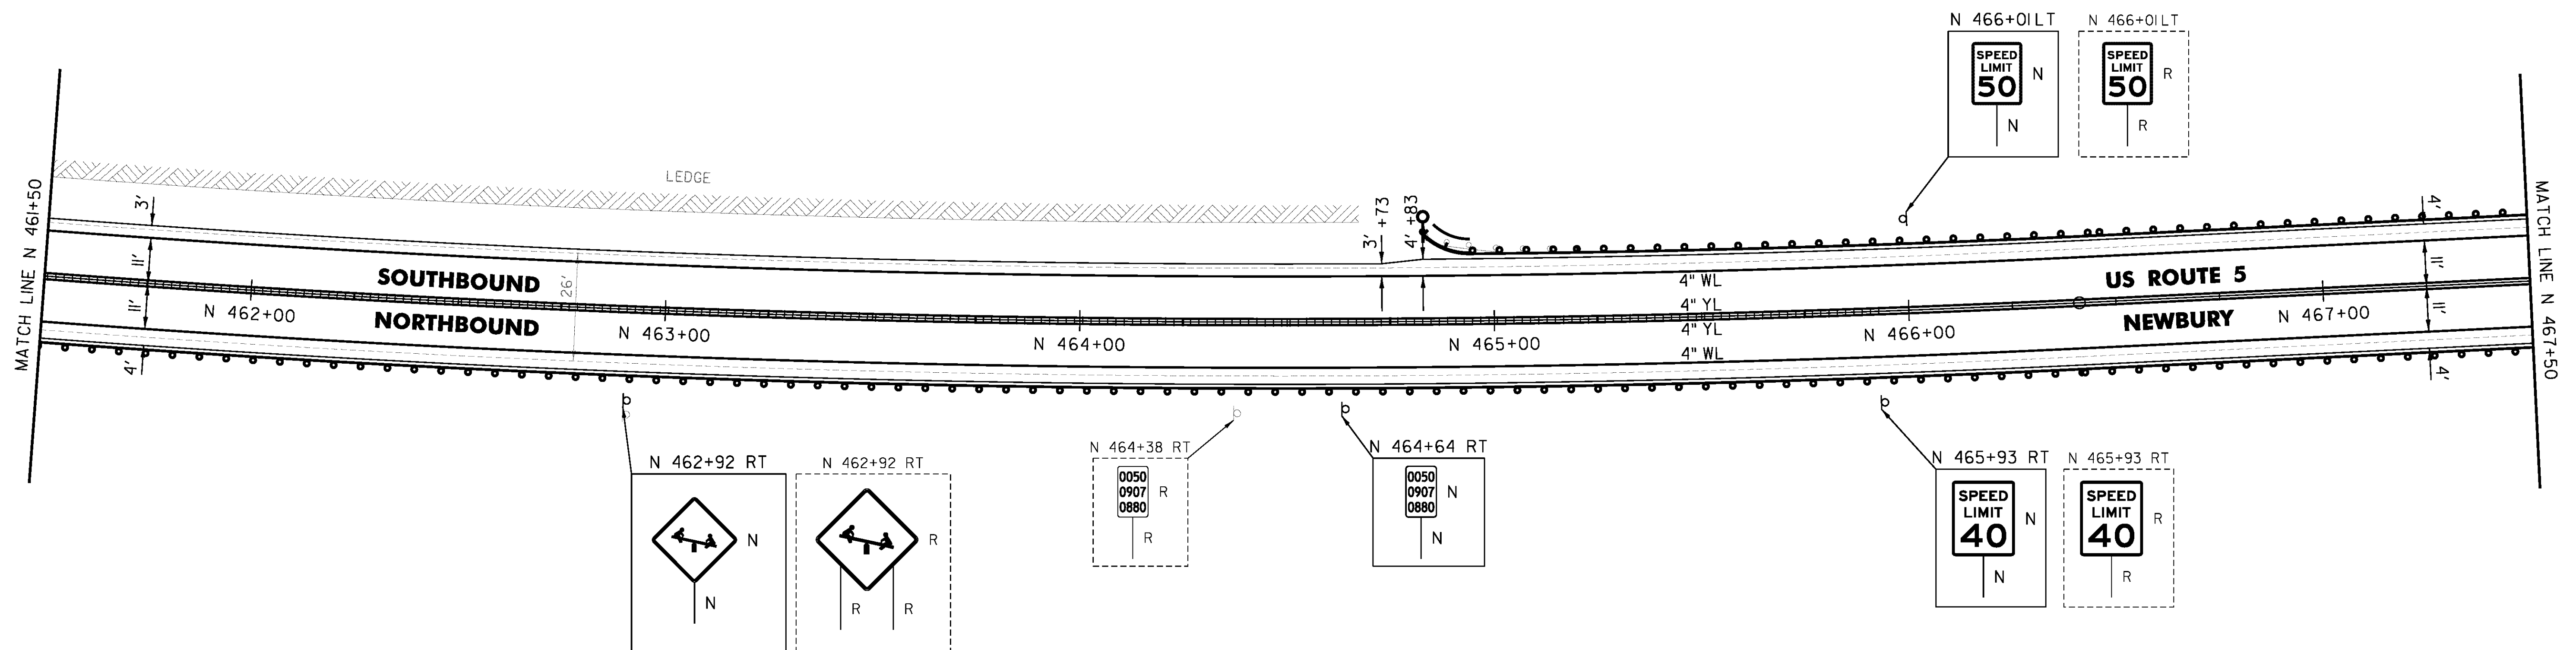

NOT TO SCALE

PROJECT NAME: BRADFORD-RYEGATE	PLOT DATE: 2/4/2016
PROJECT NUMBER: STP 2929(I)	DRAWN BY: W. GORDON
FILE NAME: z10c264bdr.dgn	CHECKED BY: P. SHEDD
PROJECT LEADER: P. SHEDD	SHEET 176 OF 239
DESIGNED BY: N. LEMAY	
US 5 PLAN SHEET 118	