

TEMPORARY 4 INCH WHITE LINE, PAINT
 DURABLE 4 INCH WHITE LINE (OPTION ITEM)
 N 508+50 TO N 510+92 SOLID LT
 N 508+50 TO N 509+65 SOLID RT
 N 510+45 TO N 514+50 SOLID RT
 N 510+92 TO N 511+15 SOLID LT (TH 403)
 N 511+40 TO N 511+57 SOLID LT (TH 403)
 N 511+57 TO N 514+50 SOLID LT

TEMPORARY 4 INCH YELLOW LINE, PAINT
 DURABLE 4 INCH YELLOW LINE (OPTION ITEM)
 N 508+50 TO N 509+83 SOLID LT & RT
 N 510+23 TO N 511+06 SOLID LT & RT
 N 511+27 TO N 511+29 DOUBLE SOLID LT (TH 403)
 N 511+46 TO N 514+50 SOLID LT & RT

TEMPORARY 24 INCH STOP BAR, PAINT
 DURABLE 24 INCH STOP BAR (OPTION ITEM)
 N 511+10 TO N 511+26 LT (TH 403)

TEMPORARY LETTER OR SYMBOL, PAINT
 DURABLE LETTER OR SYMBOL (OPTION ITEM)
 N 511+21 LT *STOP* (TH 403)

REHAB. DROP INLETS, CATCH BASINS,
 OR MANHOLES, CLASS I, CLASS II
 N 509+35 RT
 N 509+46 LT
 N 511+40 LT (TH 403)
 N 512+74 LT

CHANGING ELEVATION OF SEWER MANHOLES (NON-PART)
 N 511+17 LT (TH 403)

STONE FILL, TYPE I
 N 509+48 TO N 511+04 LT
 N 513+00 TO N 514+50 LT

STEEL BEAM GUARDRAIL, GALVANIZED
 N 508+50 TO N 508+53.5 RT
 N 513+16.5 TO N 513+29 RT

STEEL BEAM GUARDRAIL,
 GALVANIZED W/8 FEET POSTS
 N 513+29 TO N 514+50 RT

ANCHOR FOR STEEL BEAM RAIL
 2 (SEE STANDARD G-1d)


REMOVAL AND DISPOSAL OF GUARDRAIL
 N 513+23.5 TO N 514+50 RT

DELINEATOR WITH STEEL POST
 N 508+53.5 RT
 N 513+16.5 RT

REMOVAL OF EXISTING CURB
 N 514+19 TO N 514+50 LT

REMOVING SIGNS
 AS SHOWN - 14

ERECTING SALVAGED SIGNS
 AS SHOWN - 1

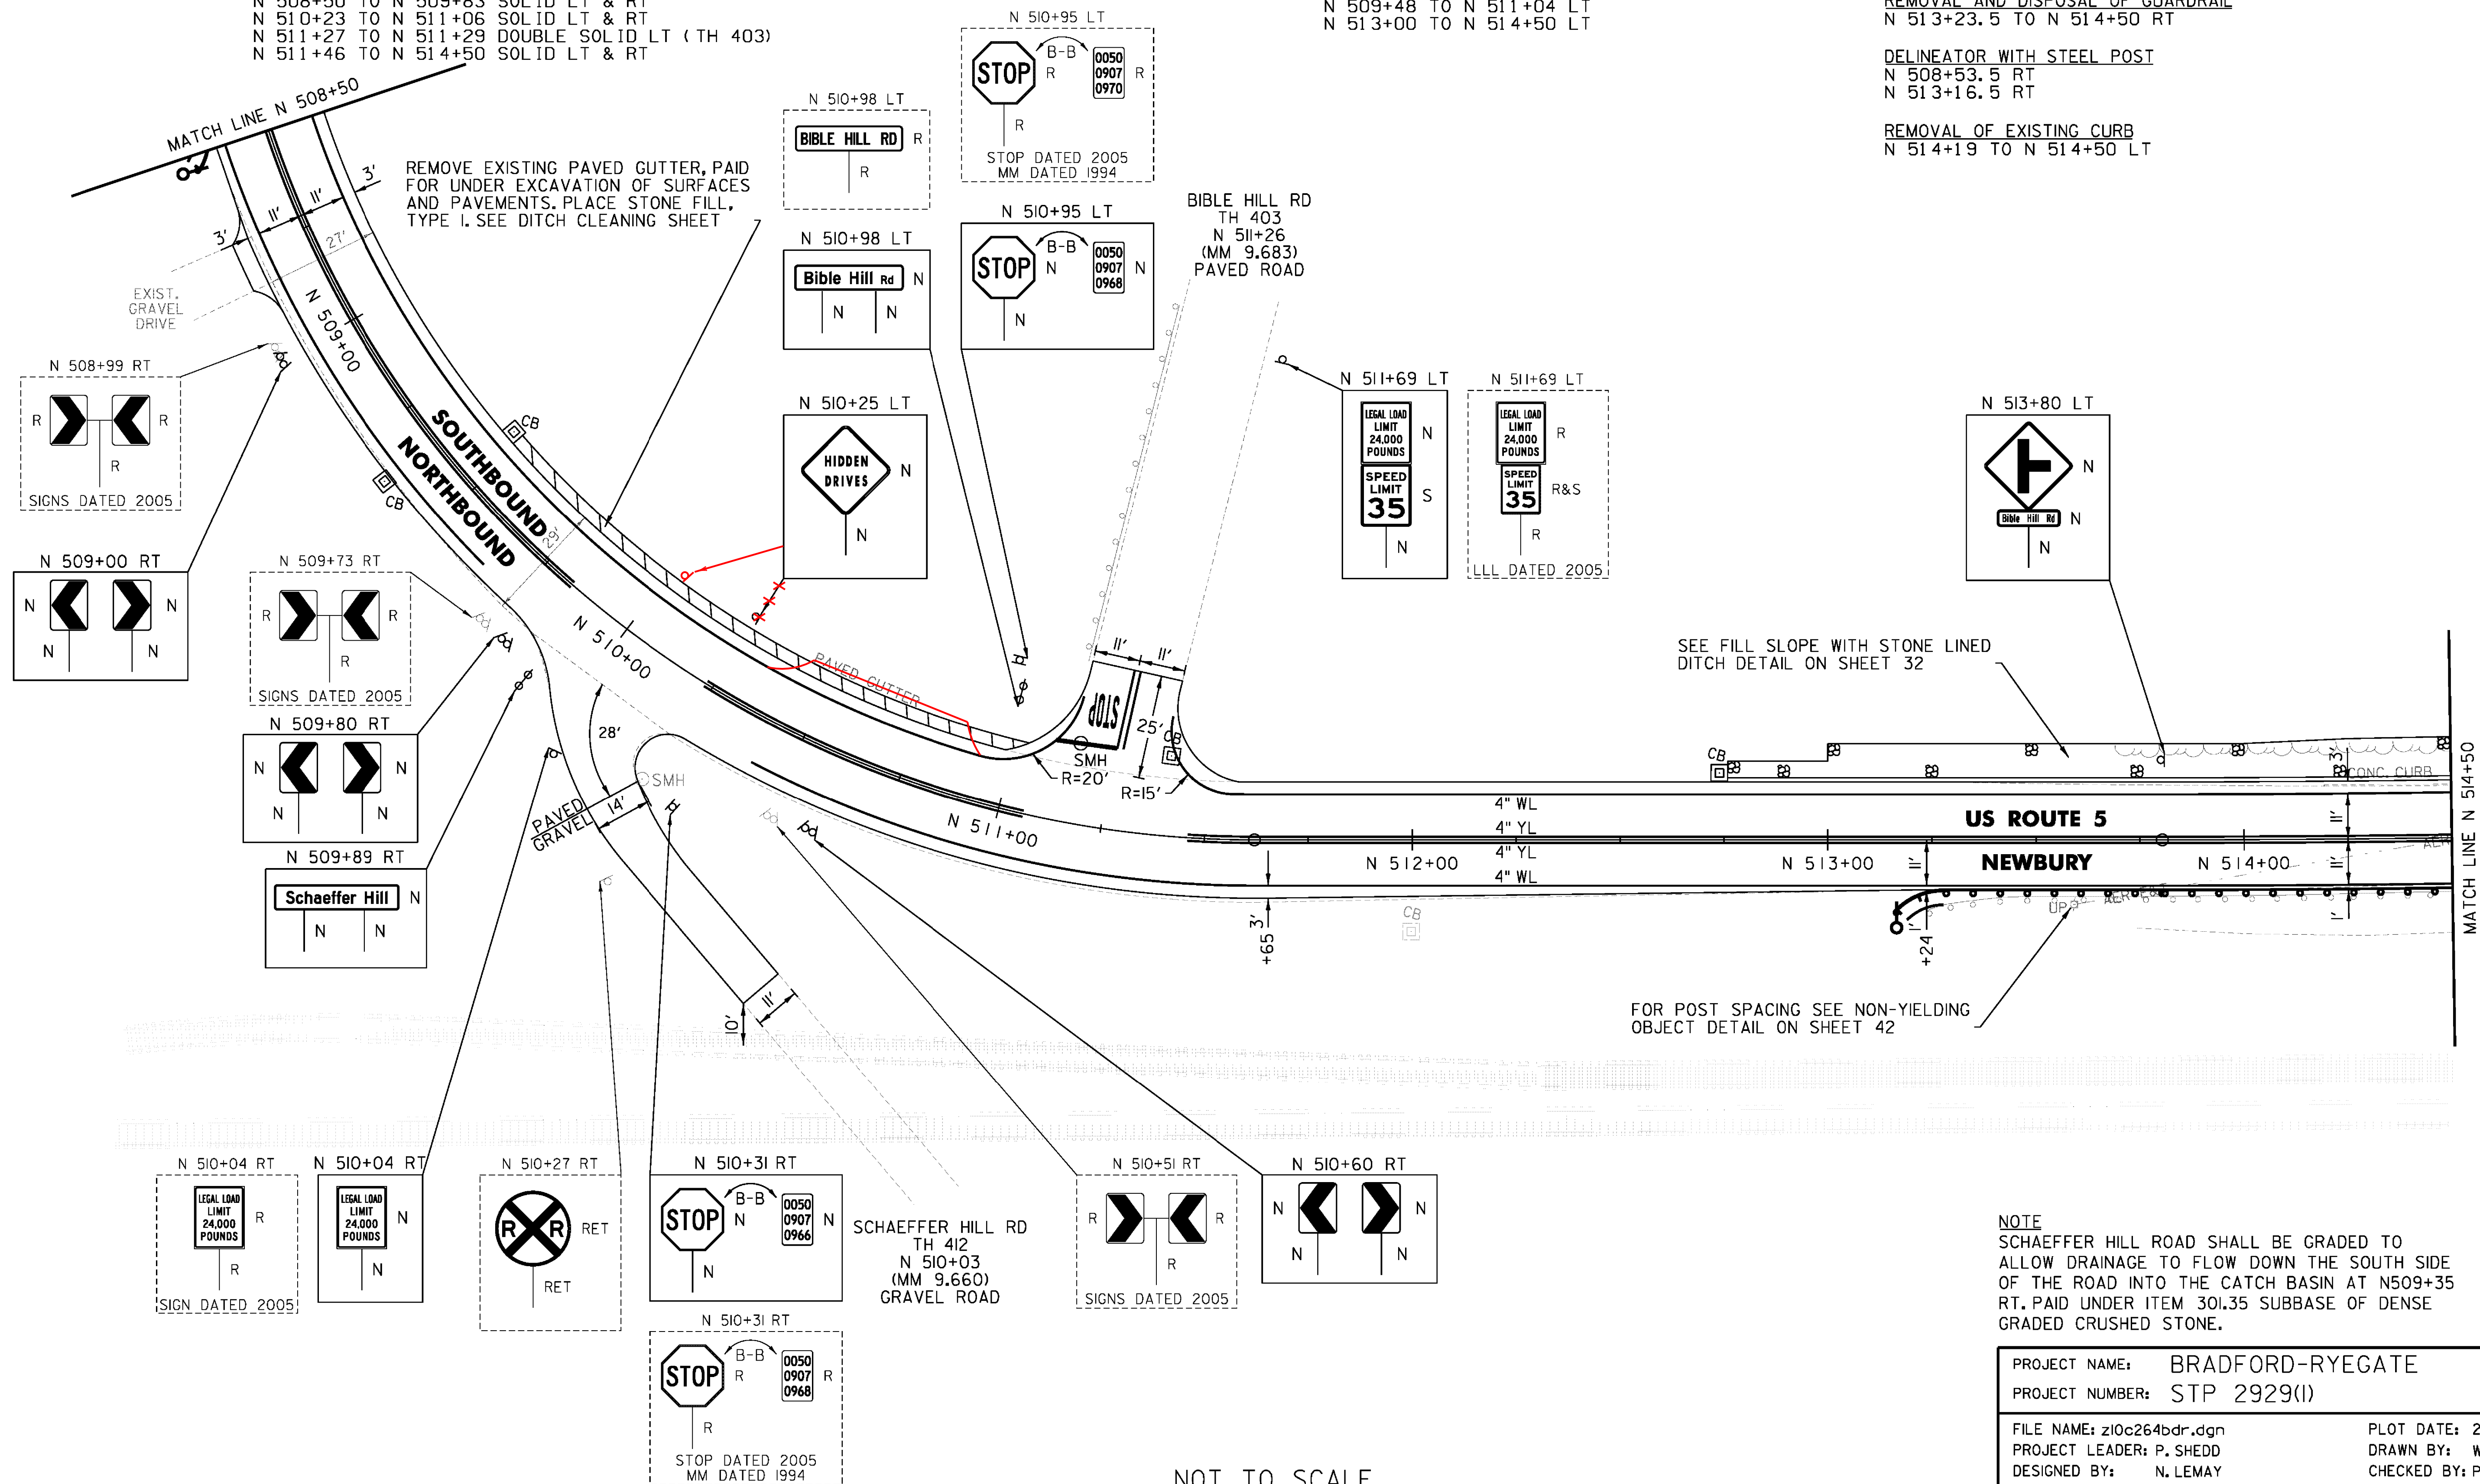

NOTE
 SCHAEFFER HILL ROAD SHALL BE GRADED TO
 ALLOW DRAINAGE TO FLOW DOWN THE SOUTH SIDE
 OF THE ROAD INTO THE CATCH BASIN AT N509+35
 RT. PAID UNDER ITEM 301.35 SUBBASE OF DENSE
 GRADED CRUSHED STONE.

PROJECT NAME:	BRADFORD-RYEGATE
PROJECT NUMBER:	STP 2929(I)
FILE NAME:	z10c264bdr.dgn
PROJECT LEADER:	P. SHEDD
DESIGNED BY:	N. LEMAY
US 5 PLAN SHEET	126
PLOT DATE:	2/4/2016
DRAWN BY:	W. GORDON
CHECKED BY:	P. SHEDD
SHEET	184 OF 239

NOT TO SCALE