


TEMPORARY 4 INCH WHITE LINE, PAINT
DURABLE 4 INCH WHITE LINE (OPTION ITEM)
R 20+50 TO R 26+50 SOLID LT & RT

REMOVING SIGNS
AS SHOWN - 1

TEMPORARY 4 INCH YELLOW LINE, PAINT
DURABLE 4 INCH YELLOW LINE (OPTION ITEM)
R 20+50 TO R 26+50 SOLID LT & RT

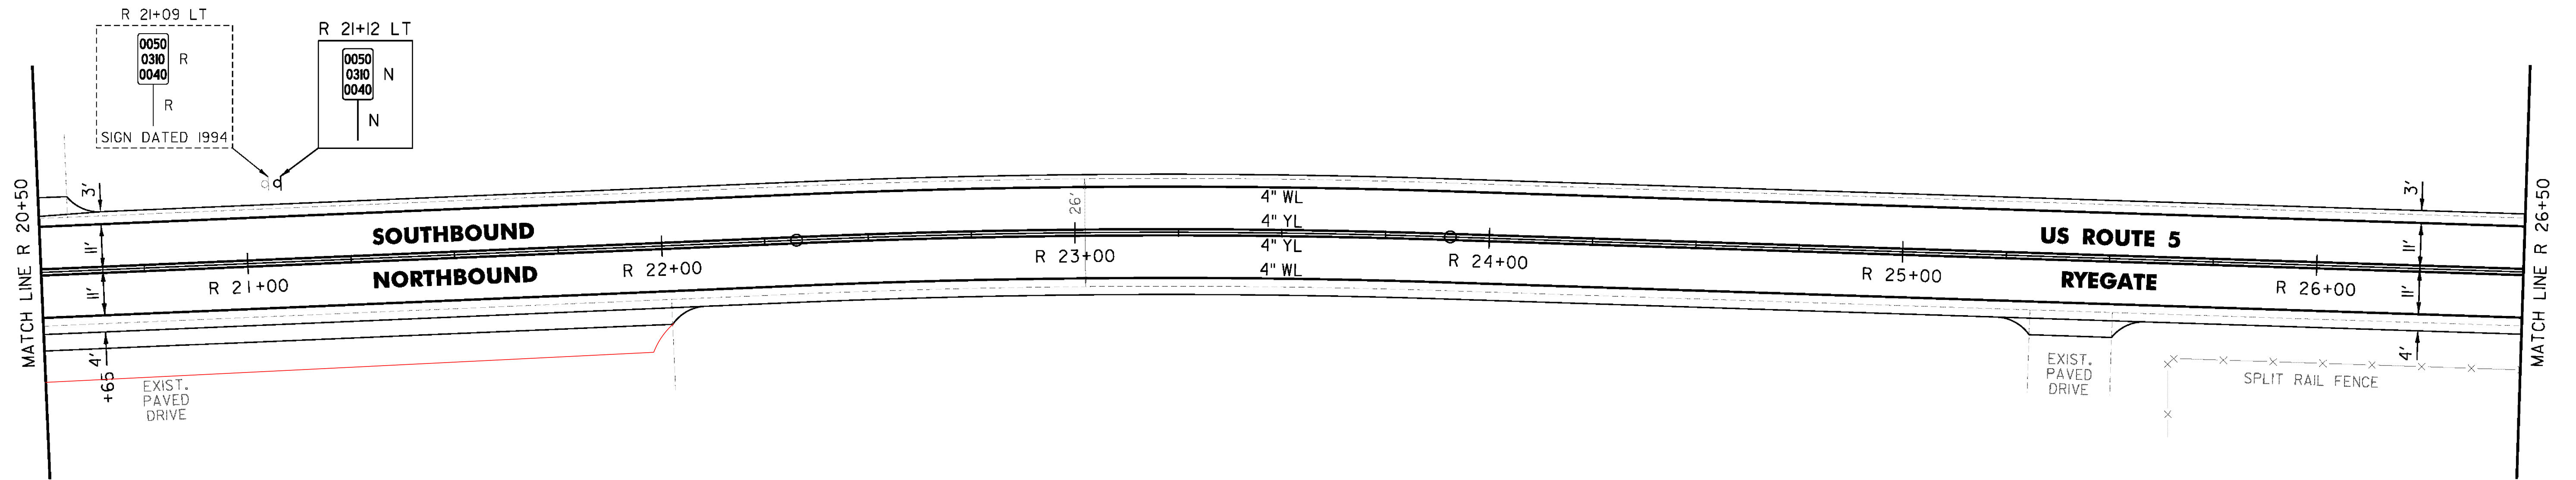

CLD 14-0278

NOT TO SCALE

PROJECT NAME: BRADFORD-RYEGATE	PLOT DATE: 2/4/2016
PROJECT NUMBER: STP 2929(1)	DRAWN BY: W. GORDON
FILE NAME: z10c264bdr.dgn	CHECKED BY: P. SHEDD
PROJECT LEADER: P. SHEDD	SHEET 189 OF 239
DESIGNED BY: N. LEMAY	
US 5 PLAN SHEET 131	