

TEMPORARY 4 INCH WHITE LINE, PAINT
 DURABLE 4 INCH WHITE LINE (OPTION ITEM)
 M 246+50 TO M 251+50 SOLID LT & RT

TEMPORARY 4 INCH YELLOW LINE, PAINT
 DURABLE 4 INCH YELLOW LINE (OPTION ITEM)
 M 246+50 TO M 251+50 SOLID LT & RT

REHAB. DROP INLETS, CATCH BASINS,
 OR MANHOLES, CLASS I, CLASS II
 M 250+04 LT


STEEL BEAM GUARDRAIL, GALVANIZED
 M 249+44 TO M 250+81.5 RT

REMOVING SIGNS
 AS SHOWN - 1

ANCHOR FOR STEEL BEAM RAIL
 2' (SEE STANDARD G-1d)

REMOVAL AND DISPOSAL OF GUARDRAIL
 M 249+44 TO M 250+81.5 RT

DELINEATOR WITH STEEL POST
 M 249+44 RT
 M 250+81.5 RT

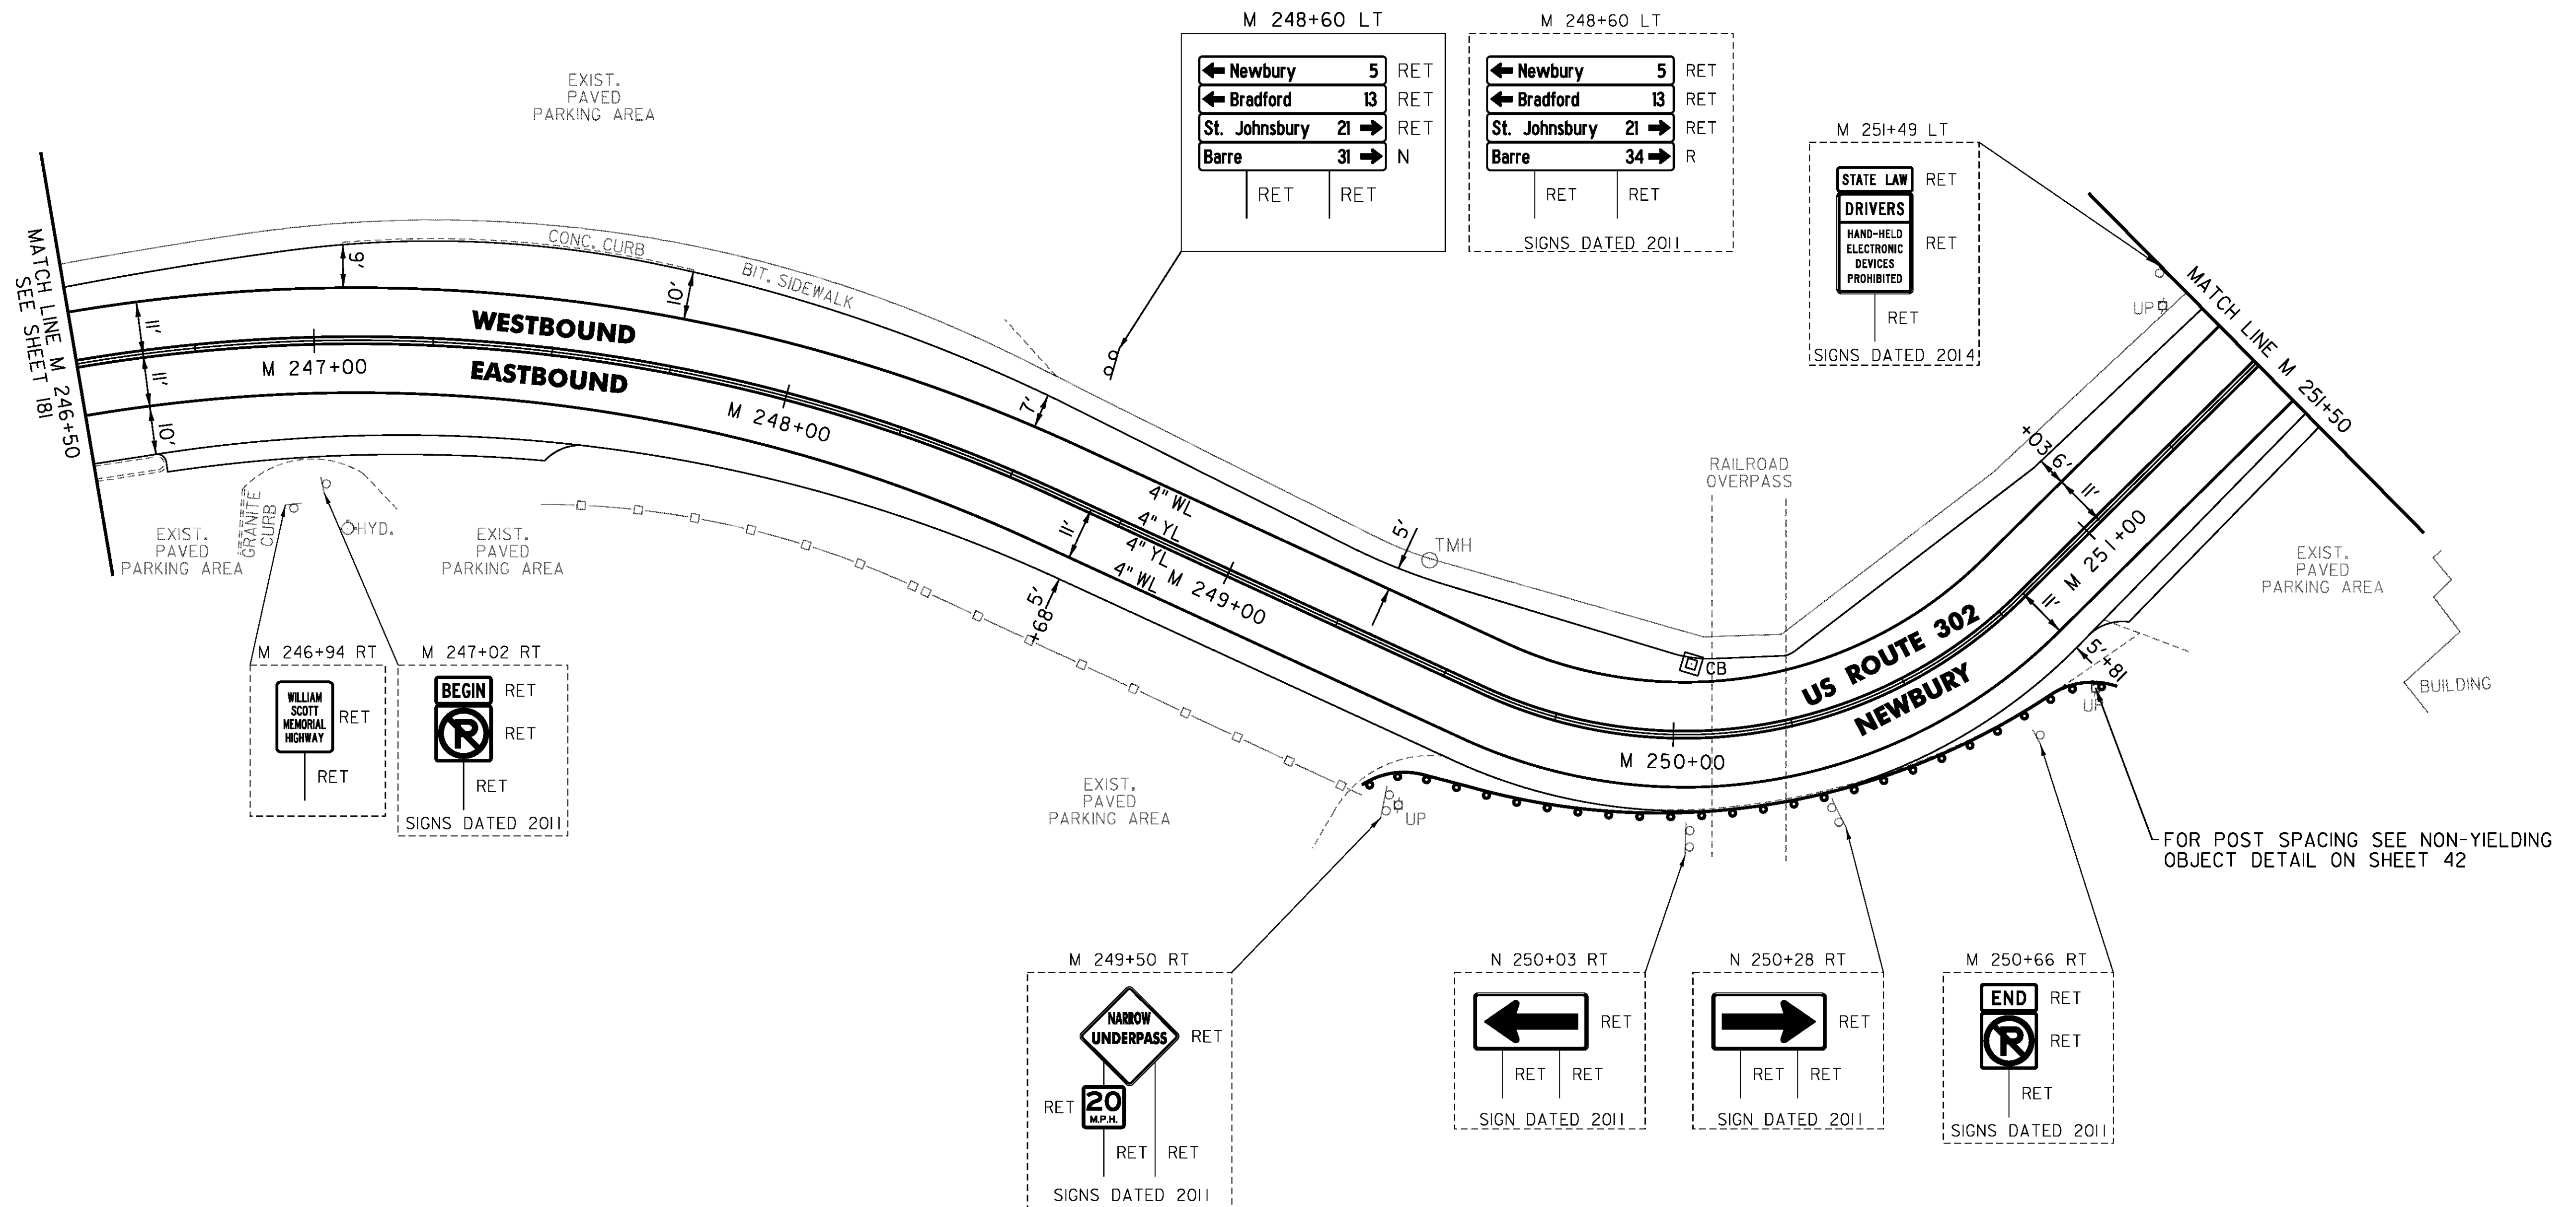

PROJECT NAME:	BRADFORD-RYEGATE
PROJECT NUMBER:	STP 2929(I)
FILE NAME:	z10c264bdr.dgn
PROJECT LEADER:	P. SHEDD
DESIGNED BY:	N. LEMAY
US 302 PLAN SHEET 1	
PLOT DATE:	2/4/2016
DRAWN BY:	W. GORDON
CHECKED BY:	P. SHEDD
SHEET	200 OF 239

NOT TO SCALE