

TEMPORARY 4 INCH WHITE LINE, PAINT
 DURABLE 4 INCH WHITE LINE (OPTION ITEM)
 M 257+50 TO M 258+27 SOLID LT
 M 257+50 TO M 259+33 SOLID RT
 M 258+27 TO M 258+69 SOLID LT (TH 412)
 M 258+98 TO M 259+21 SOLID LT (TH 412)
 M 259+21 TO M 259+33 SOLID LT

TEMPORARY 24 INCH STOP BAR, PAINT
 DURABLE 24 INCH STOP BAR (OPTION ITEM)
 M 258+53 TO M 258+80 LT
 TEMPORARY LETTER OR SYMBOL, PAINT
 DURABLE LETTER OR SYMBOL (OPTION ITEM)
 M 258+69 LT "STOP"

REHAB. DROP INLETS, CATCH BASINS,
 OR MANHOLES, CLASS I, CLASS II
 M 259+07 RT
 CHANGING ELEVATION OF SEWER MANHOLES (NON-PART)
 M 257+93 LT

~~GUARDRAIL APPROACH SECTION,
 GALVANIZED 2 RAIL BOX BEAM
 M 258+90 TO M 259+22 RT~~


REMOVING SIGNS
 AS SHOWN - 3

STEEL BEAM GUARDRAIL, GALVANIZED
 M 257+50 TO M 257+52.5 RT
 M 258+27.5 TO M 258+90 RT

REMOVAL AND DISPOSAL OF GUARDRAIL
 M 257+50 TO M 259+22 RT

STEEL BEAM GUARDRAIL,
 GALVANIZED/NESTED
 M 257+52.5 TO ~~M 258+27.5 RT~~
 M 257+65 RT

TEMPORARY 4 INCH YELLOW LINE, PAINT
 DURABLE 4 INCH YELLOW LINE (OPTION ITEM)
 M 257+50 TO M 258+59 SOLID LT & RT
 M 258+80 TO M 258+83 DOUBLE SOLID LT (TH 412)
 M 258+99 TO M 259+33 SOLID LT & RT

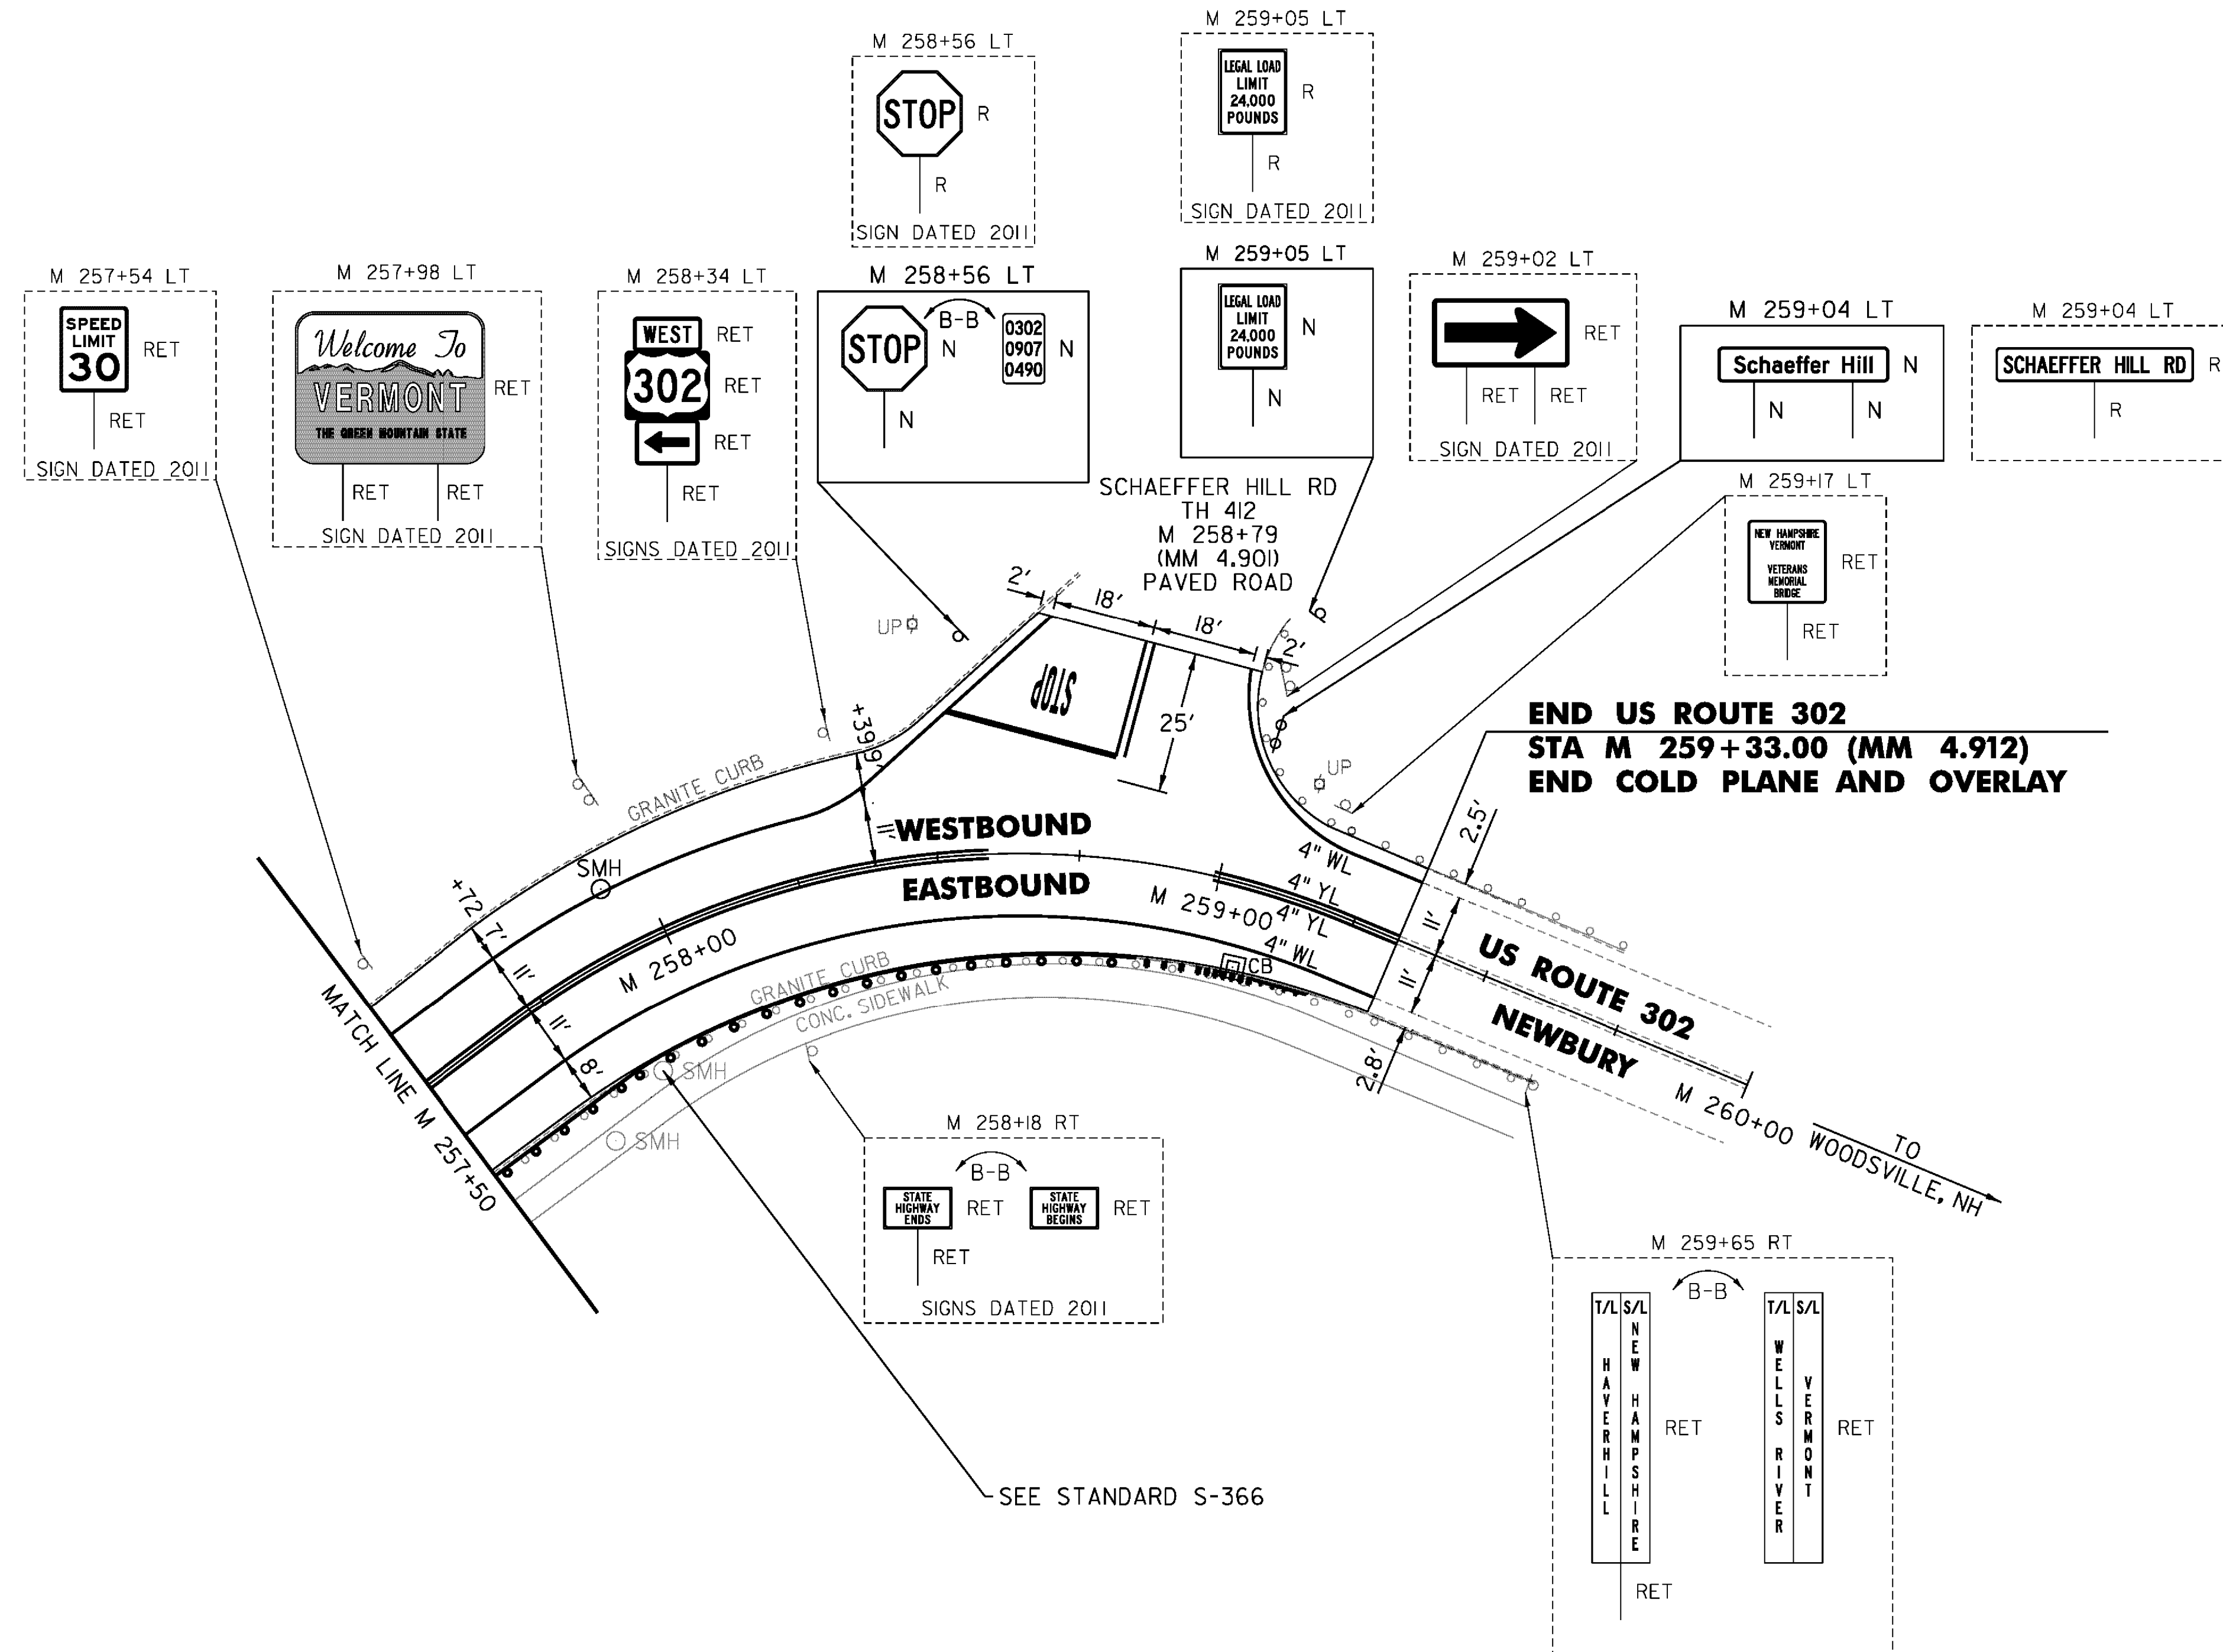

**END US ROUTE 302
 STA M 259+33.00 (MM 4.912)
 END COLD PLANE AND OVERLAY**

NOT TO SCALE

PROJECT NAME:	BRADFORD-RYEGATE
PROJECT NUMBER:	STP 2929(I)
FILE NAME:	z10c264bdr.dgn
PROJECT LEADER:	P. SHEDD
DESIGNED BY:	N. LEMAY
US 302 PLAN SHEET 3	
PLOT DATE:	2/4/2016
DRAWN BY:	W. GORDON
CHECKED BY:	P. SHEDD
SHEET	202 OF 239