

DURABLE 4 INCH WHITE LINE (SEE OPTION ITEMS)
 STA. 83+75 - STA. 89+50 (SOLID LT & RT)

TEMPORARY 4 INCH WHITE LINE, PAINT
 STA. 83+75 - STA. 89+50 (SOLID LT & RT)

DURABLE 4 INCH YELLOW LINE, POLYUREA
 STA. 83+75 - STA. 86+00 (SOLID LT, DASHED RT)
 STA. 86+00 - STA. 88+75 (SOLID LT & RT)
 STA. 88+75 - STA. 89+50 (CENTERLINE LT & RT)

TEMPORARY 4 INCH YELLOW LINE, PAINT
 STA. 83+75 - STA. 86+00 (SOLID LT, DASHED RT)
 STA. 86+00 - STA. 88+75 (SOLID LT & RT)
 STA. 88+75 - STA. 89+50 (CENTERLINE LT & RT)

DURABLE 8 INCH YELLOW LINE (SEE OPTION ITEMS)
 STA. 89+34 - STA. 89+50 (HATCHED LT & RT)

TEMPORARY 8 INCH YELLOW LINE, PAINT
 STA. 89+34 - STA. 89+50 (HATCHED LT & RT)


REMOVAL AND DISPOSAL OF GUARDRAIL
 STA. 83+75 - STA. 89+50 RT
 STA. 84+31 - STA. 87+80 LT

RELOCATE MAILBOX, MULTIPLE SUPPORT
 STA. 84+53 LT
 STA. 84+55 LT


STEEL BEAM GUARDRAIL, GALVANIZED
 STA. 83+75 - STA. 86+90 RT

MILLED RUMBLE STRIPS
 STA. 83+75 - STA. 88+75 CTR

ANCHOR FOR STEEL BEAM RAIL
 STA. ~~86+90~~ RT
 86+82

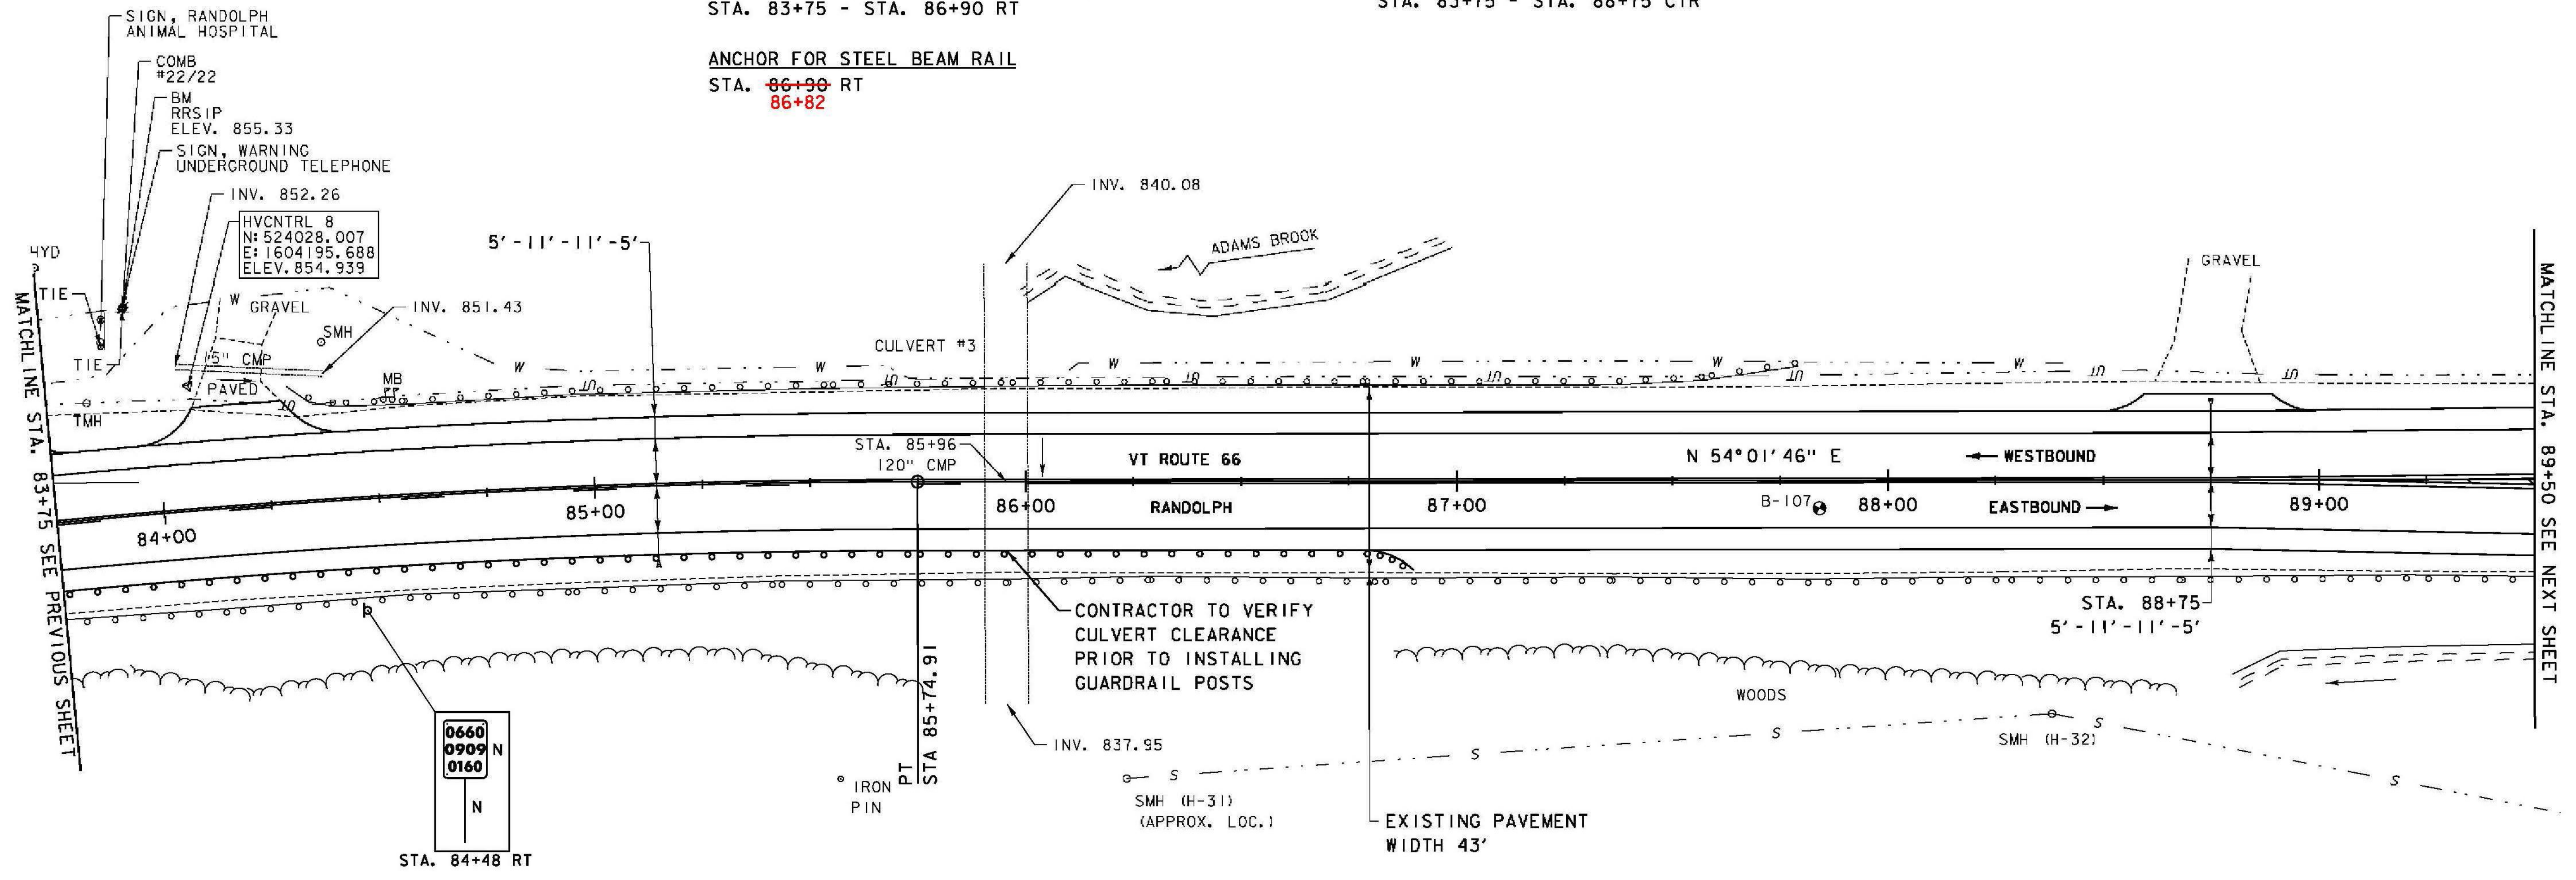

- SIGN LEGEND**
- R = REMOVE
 - R&S = REMOVE AND SALVAGE
 - RET = RETAIN
 - S = SALVAGE
 - N = NEW
 - B-B = BACK TO BACK
 - = EXISTING
 - = NEW

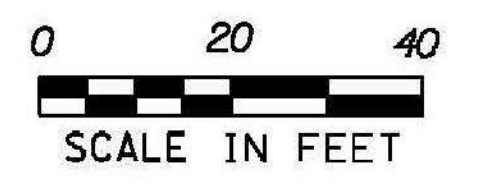

PROJECT NAME: RANDOLPH	PLOT DATE: 6/5/2014
PROJECT NUMBER: STP 2932 (1)	DRAWN BY: B. BRESLEND
FILE NAME: z10c270.dgn	CHECKED BY: C. LATHROP
PROJECT LEADER: C. LATHROP	SHEET 41 OF 276
DESIGNED BY: B. BRESLEND	
PROJECT LAYOUT SHEET 12	

MATCHLINE STA. 83+75 SEE PREVIOUS SHEET

MATCHLINE STA. 89+50 SEE NEXT SHEET