

DURABLE 4 INCH WHITE LINE (SEE OPTION ITEMS)
 STA. 107+25 - STA. 113+25 (SOLID LT & RT)

TEMPORARY 4 INCH WHITE LINE, PAINT
 STA. 107+25 - STA. 113+25 (SOLID LT & RT)

COMMON EXCAVATION
 STA. 107+25 - STA. 111+28 RT (BITUMINOUS GUTTER)
 STA. 111+54 - STA. 112+35 RT (BITUMINOUS GUTTER)
 STA. 112+60 - STA. 113+25 RT (BITUMINOUS GUTTER)

DURABLE 4 INCH YELLOW LINE, POLYUREA
 STA. 107+25 - STA. 109+50 (DASHED LT, SOLID RT)
 STA. 109+50 - STA. 113+25 (SOLID LT & RT)

TEMPORARY 4 INCH YELLOW LINE, PAINT
 STA. 107+25 - STA. 109+50 (SOLID LT, DASHED RT)
 STA. 109+50 - STA. 113+25 (SOLID LT & RT)

REHAB, DROP INLET, CATCH BASINS,
 OR MANHOLES, CLASS I, CLASS II OR CLASS III

CURVE #10
 DELTA = 10°20'35"
 D = 2°17'31"
 R = 2500.00'
 T = 226.26'
 L = 451.30'
 E = 10.22'
 BANKING 0.043 FT/FT
 DESIGN SPEED 50 MPH
 SEE SUPERELEVATION DIAGRAMS
 FOR MORE INFORMATION

REMOVING SIGNS
 AS SHOWN - 2

6 INCH UNDERDRAIN PIPE
~~STA. 107+95 - STA. 110+00 RT NA~~
~~STA. 112+05 - STA. 113+25 LT~~
~~STA. 111+90 - STA. 113+25 LT~~

SPECIAL PROVISION (CORING CONCRETE)
 STA. 107+95 RT







STA. 107+95 RT
 STA. 110+11 RT
 STA. 111+60 RT
 STA. 112+69 RT

STONE FILL, TYPE I
 STA. 107+25 - STA. 107+40 LT


GEOTEXTILE FOR SILT FENCE
 STA. 107+25 - STA. 107+40 LT

GRUBBING MATERIAL (6")
 STA. 107+25 - STA. 107+40 LT

MILLED RUMBLE STRIPS
 STA. 107+25 - STA. 113+25 CTR

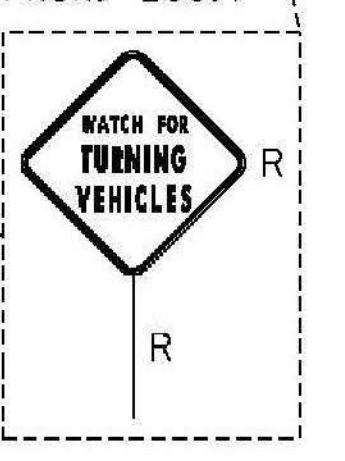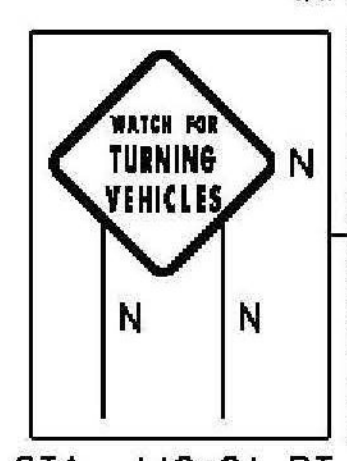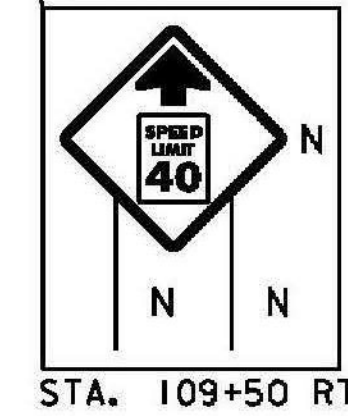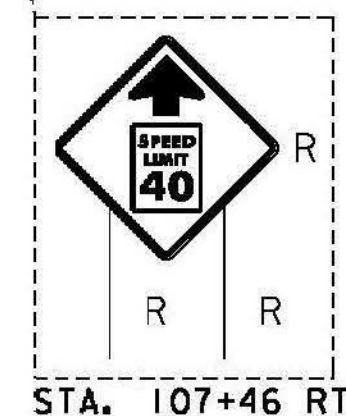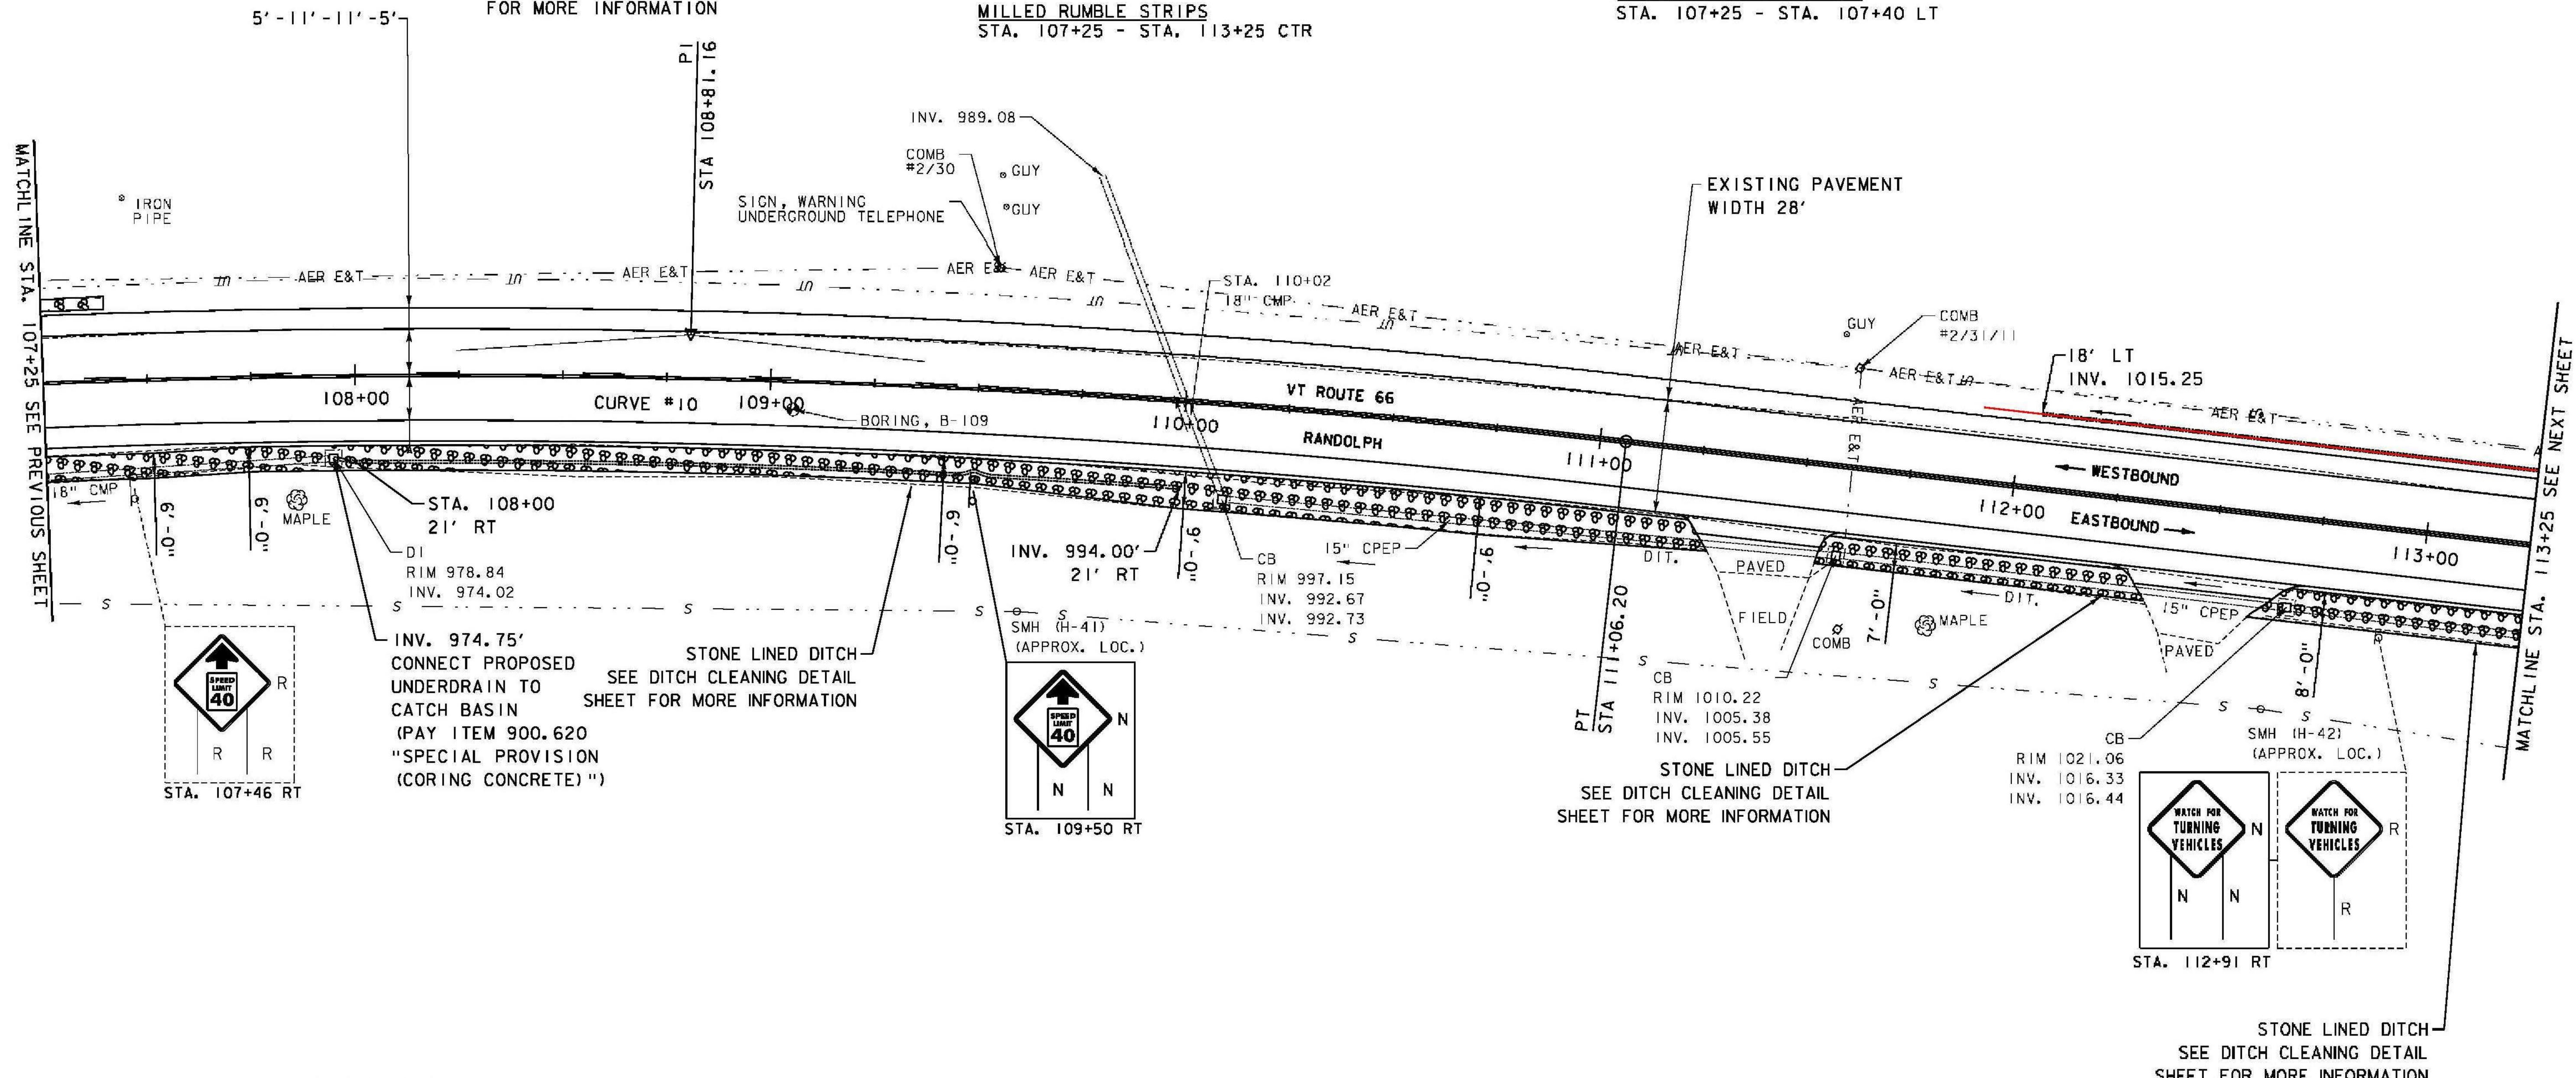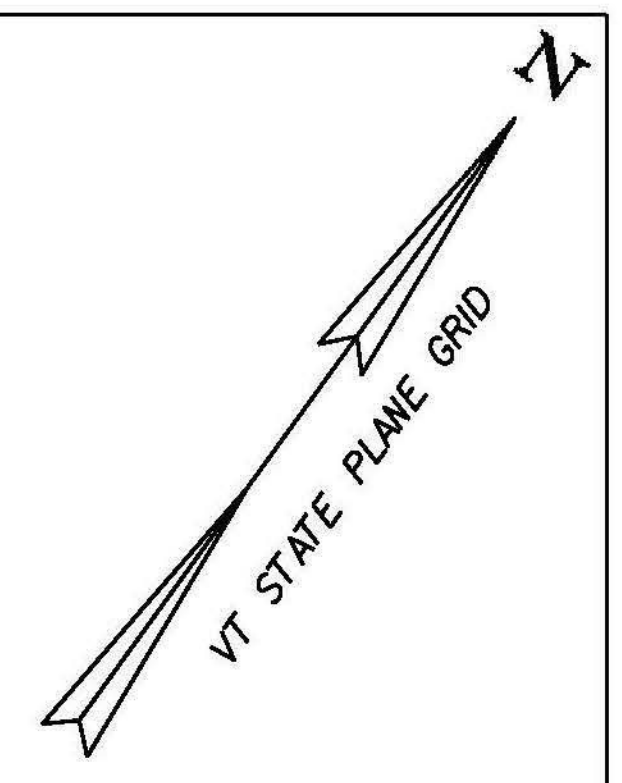

SIGN LEGEND
 R = REMOVE
 R&S = REMOVE AND SALVAGE
 RET = RETAIN
 S = SALVAGE
 N = NEW
 B-B = BACK TO BACK
 --- = EXISTING
 --- = NEW

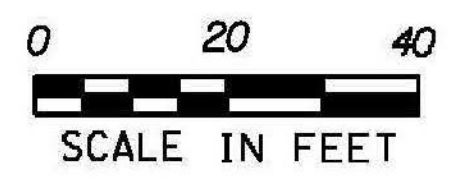

PROJECT NAME: RANDOLPH
 PROJECT NUMBER: STP 2932 (1)
 FILE NAME: z10c270.dgn
 PROJECT LEADER: C. LATHROP
 DESIGNED BY: B. BRESLEND
 PROJECT LAYOUT SHEET 16
 PLOT DATE: 6/5/2014
 DRAWN BY: B. BRESLEND
 CHECKED BY: C. LATHROP
 SHEET 45 OF 276