

DURABLE 4 INCH WHITE LINE (SEE OPTION ITEMS)
STA. 113+25 - STA. 119+25 (SOLID LT & RT)

TEMPORARY 4 INCH WHITE LINE, PAINT
STA. 113+25 - STA. 119+25 (SOLID LT & RT)

REMOVING SIGNS
AS SHOWN - 5

COMMON EXCAVATION
STA. 113+25 - STA. 119+25 RT (BITUMINOUS GUTTER)



DURABLE 4 INCH YELLOW LINE, POLYUREA
STA. 113+25 - STA. 119+25 (SOLID LT & RT)

TEMPORARY 4 INCH YELLOW LINE, PAINT
STA. 113+25 - STA. 119+25 (SOLID LT & RT)

6 INCH UNDERDRAIN PIPE
STA. 113+25 - STA. 117+25 LT
119+10

REHAB, DROP INLET, CATCH BASINS,
OR MANHOLES, CLASS I, CLASS II OR CLASS III
STA. 113+94 RT
STA. 115+89 RT
STA. 117+93 RT

MILLED RUMBLE STRIPS
STA. 113+25 - STA. 119+25 CTR

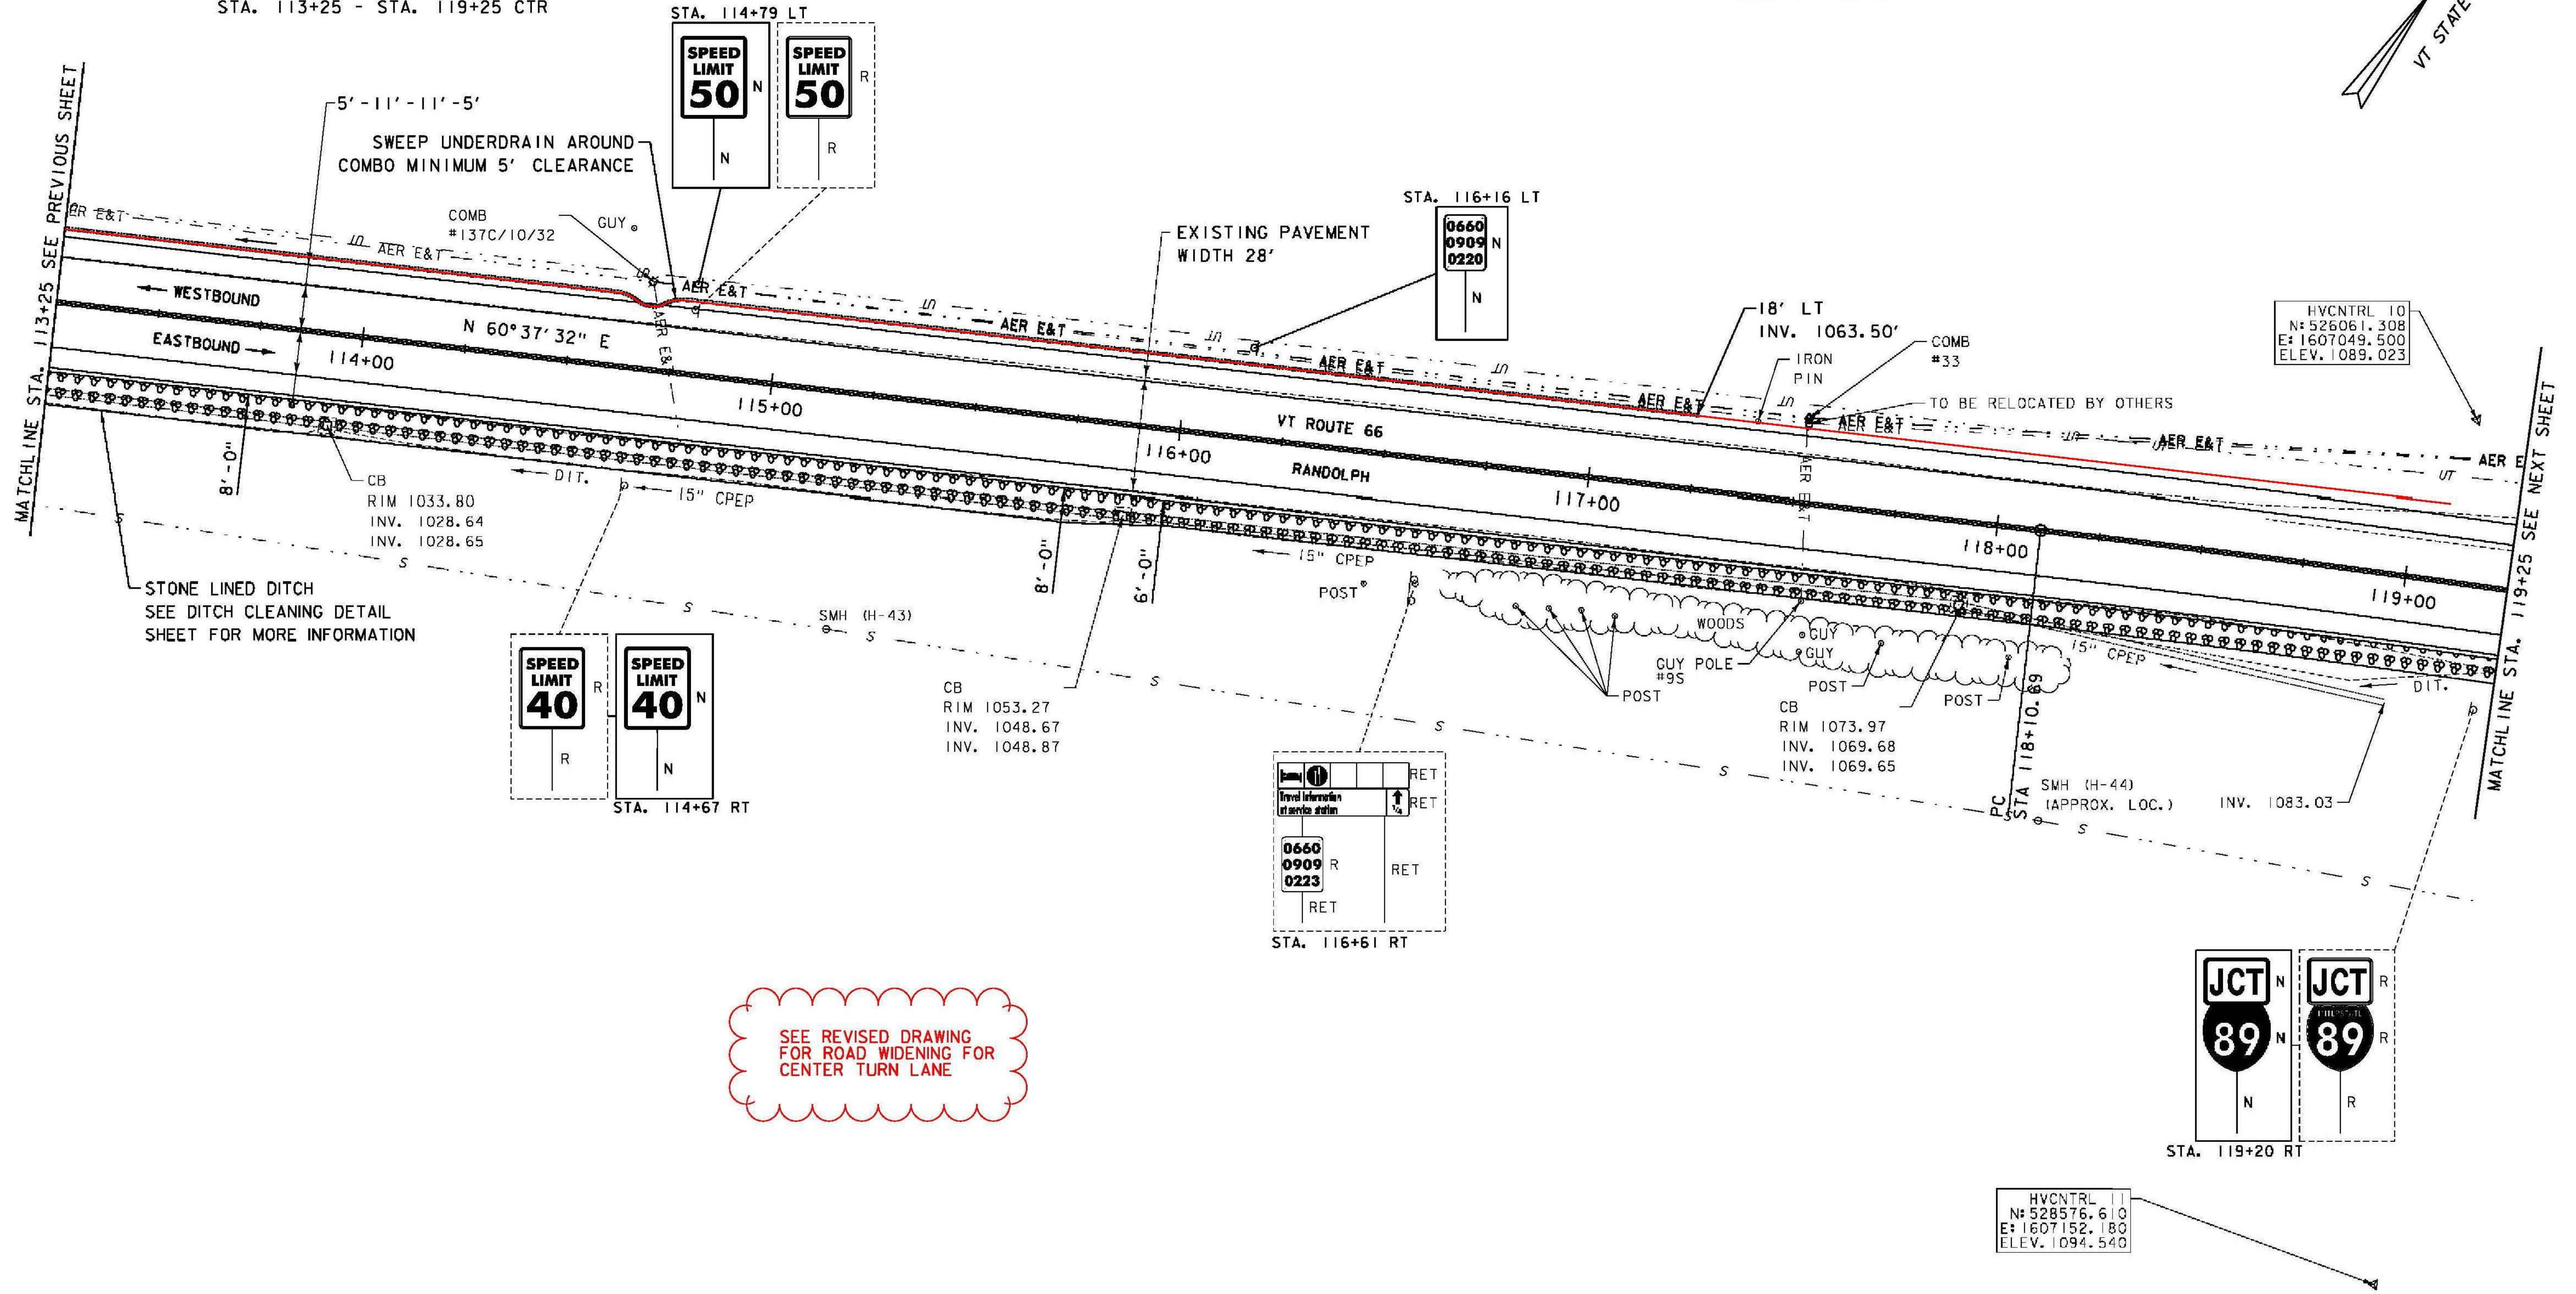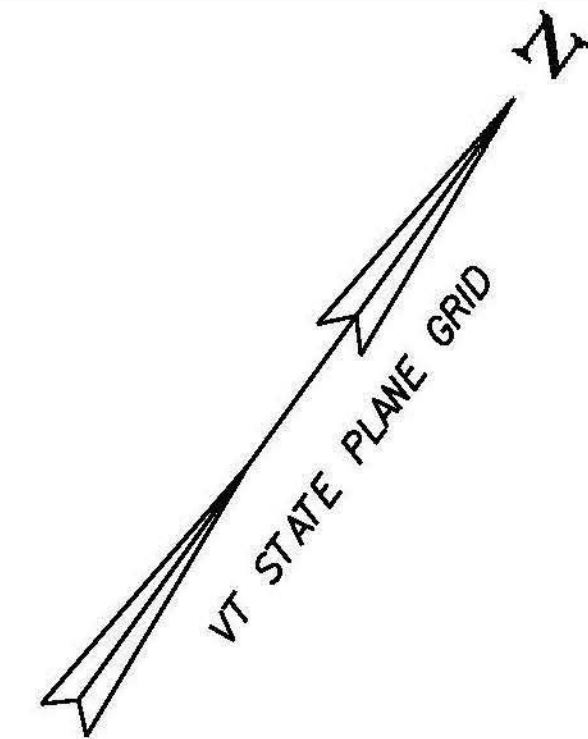

SIGN LEGEND

- R = REMOVE
- R&S = REMOVE AND SALVAGE
- RET = RETAIN
- S = SALVAGE
- N = NEW
- B-B = BACK TO BACK
- = EXISTING
- = NEW



PROJECT NAME: RANDOLPH	PLOT DATE: 6/5/2014
PROJECT NUMBER: STP 2932 (1)	DRAWN BY: B. BRESLEND
FILE NAME: z10c270.dgn	CHECKED BY: C. LATHROP
DESIGNED BY: B. BRESLEND	SHEET 46 OF 276
PROJECT LAYOUT SHEET 17	