

DURABLE 4 INCH WHITE LINE (SEE OPTION ITEMS)
 STA. 125+25 - STA. 126+97 (SOLID LT)
 STA. 125+25 - STA. 128+56 (SOLID RT)
 STA. 127+34 - STA. 128+97 (SOLID LT)
 STA. 128+98 - STA. 131+25 (SOLID RT)
 STA. 129+37 - STA. 131+25 (SOLID LT)
 STA. 129+99 - STA. 131+25 (SOLID LT)

TEMPORARY 4 INCH WHITE LINE, PAINT
 STA. 125+25 - STA. 126+97 (SOLID LT)
 STA. 125+25 - STA. 128+56 (SOLID RT)
 STA. 127+34 - STA. 128+97 (SOLID LT)
 STA. 128+98 - STA. 131+25 (SOLID RT)
 STA. 129+37 - STA. 131+25 (SOLID LT)
 STA. 129+99 - STA. 131+25 (SOLID LT)

DURABLE 4 INCH YELLOW LINE, POLYUREA
 STA. 125+25 - STA. 126+48 (SOLID LT & RT)
 STA. 127+51 - STA. 129+03 (SOLID LT, ISLAND)
 STA. 129+99 - STA. 131+25 (SOLID LT, ISLAND)

TEMPORARY 4 INCH YELLOW LINE, PAINT
 STA. 125+25 - STA. 126+48 (SOLID LT & RT)
 STA. 127+51 - STA. 129+03 (SOLID LT, ISLAND)
 STA. 129+99 - STA. 131+25 (SOLID LT, ISLAND)

**REHAB. DROP INLET, CATCH BASINS,
 OR MANHOLES, CLASS I**
 STA. 127+61 LT
 STA. 130+62 LT
 STA. 130+62 RT

DURABLE 24 INCH STOP BAR (SEE OPTIONS ITEMS)
 STA. 126+80 - STA. 127+10 LT
 STA. 128+47 - STA. 129+43 LT

DURABLE LETTER OR SYMBOL (SEE OPTIONS ITEMS)
 STA. 127+03 LT "STOP"
 STA. 129+11 LT "STOP"
 STA. 130+05 LT ARROW
 STA. 131+23 LT "ONLY"



TEMPORARY 24 INCH STOP BAR, PAINT
 STA. 126+80 - STA. 127+10 LT
 STA. 128+47 - STA. 129+43 LT

TEMPORARY LETTER OR SYMBOL, PAINT
 STA. 127+03 LT "STOP"
 STA. 129+11 LT "STOP"
 STA. 130+05 LT ARROW
 STA. 131+23 LT "ONLY"

CURVE #12
 DELTA = 1°47'57"
 D = 0°45'50"
 R = 7500.00'
 T = 117.77'
 L = 235.52'
 E = 0.92'
 BANKING NORMAL CROWN

CURVE #13
 DELTA = 2°20'51"
 D = 2°51'53"
 R = 2000.00'
 T = 40.98'
 L = 81.94'
 E = 0.42'
 BANKING NORMAL CROWN

CURVE #14
 DELTA = 3°13'37"
 D = 2°51'53"
 R = 2000.00'
 T = 56.34'
 L = 112.65'
 E = 0.79'
 BANKING NORMAL CROWN

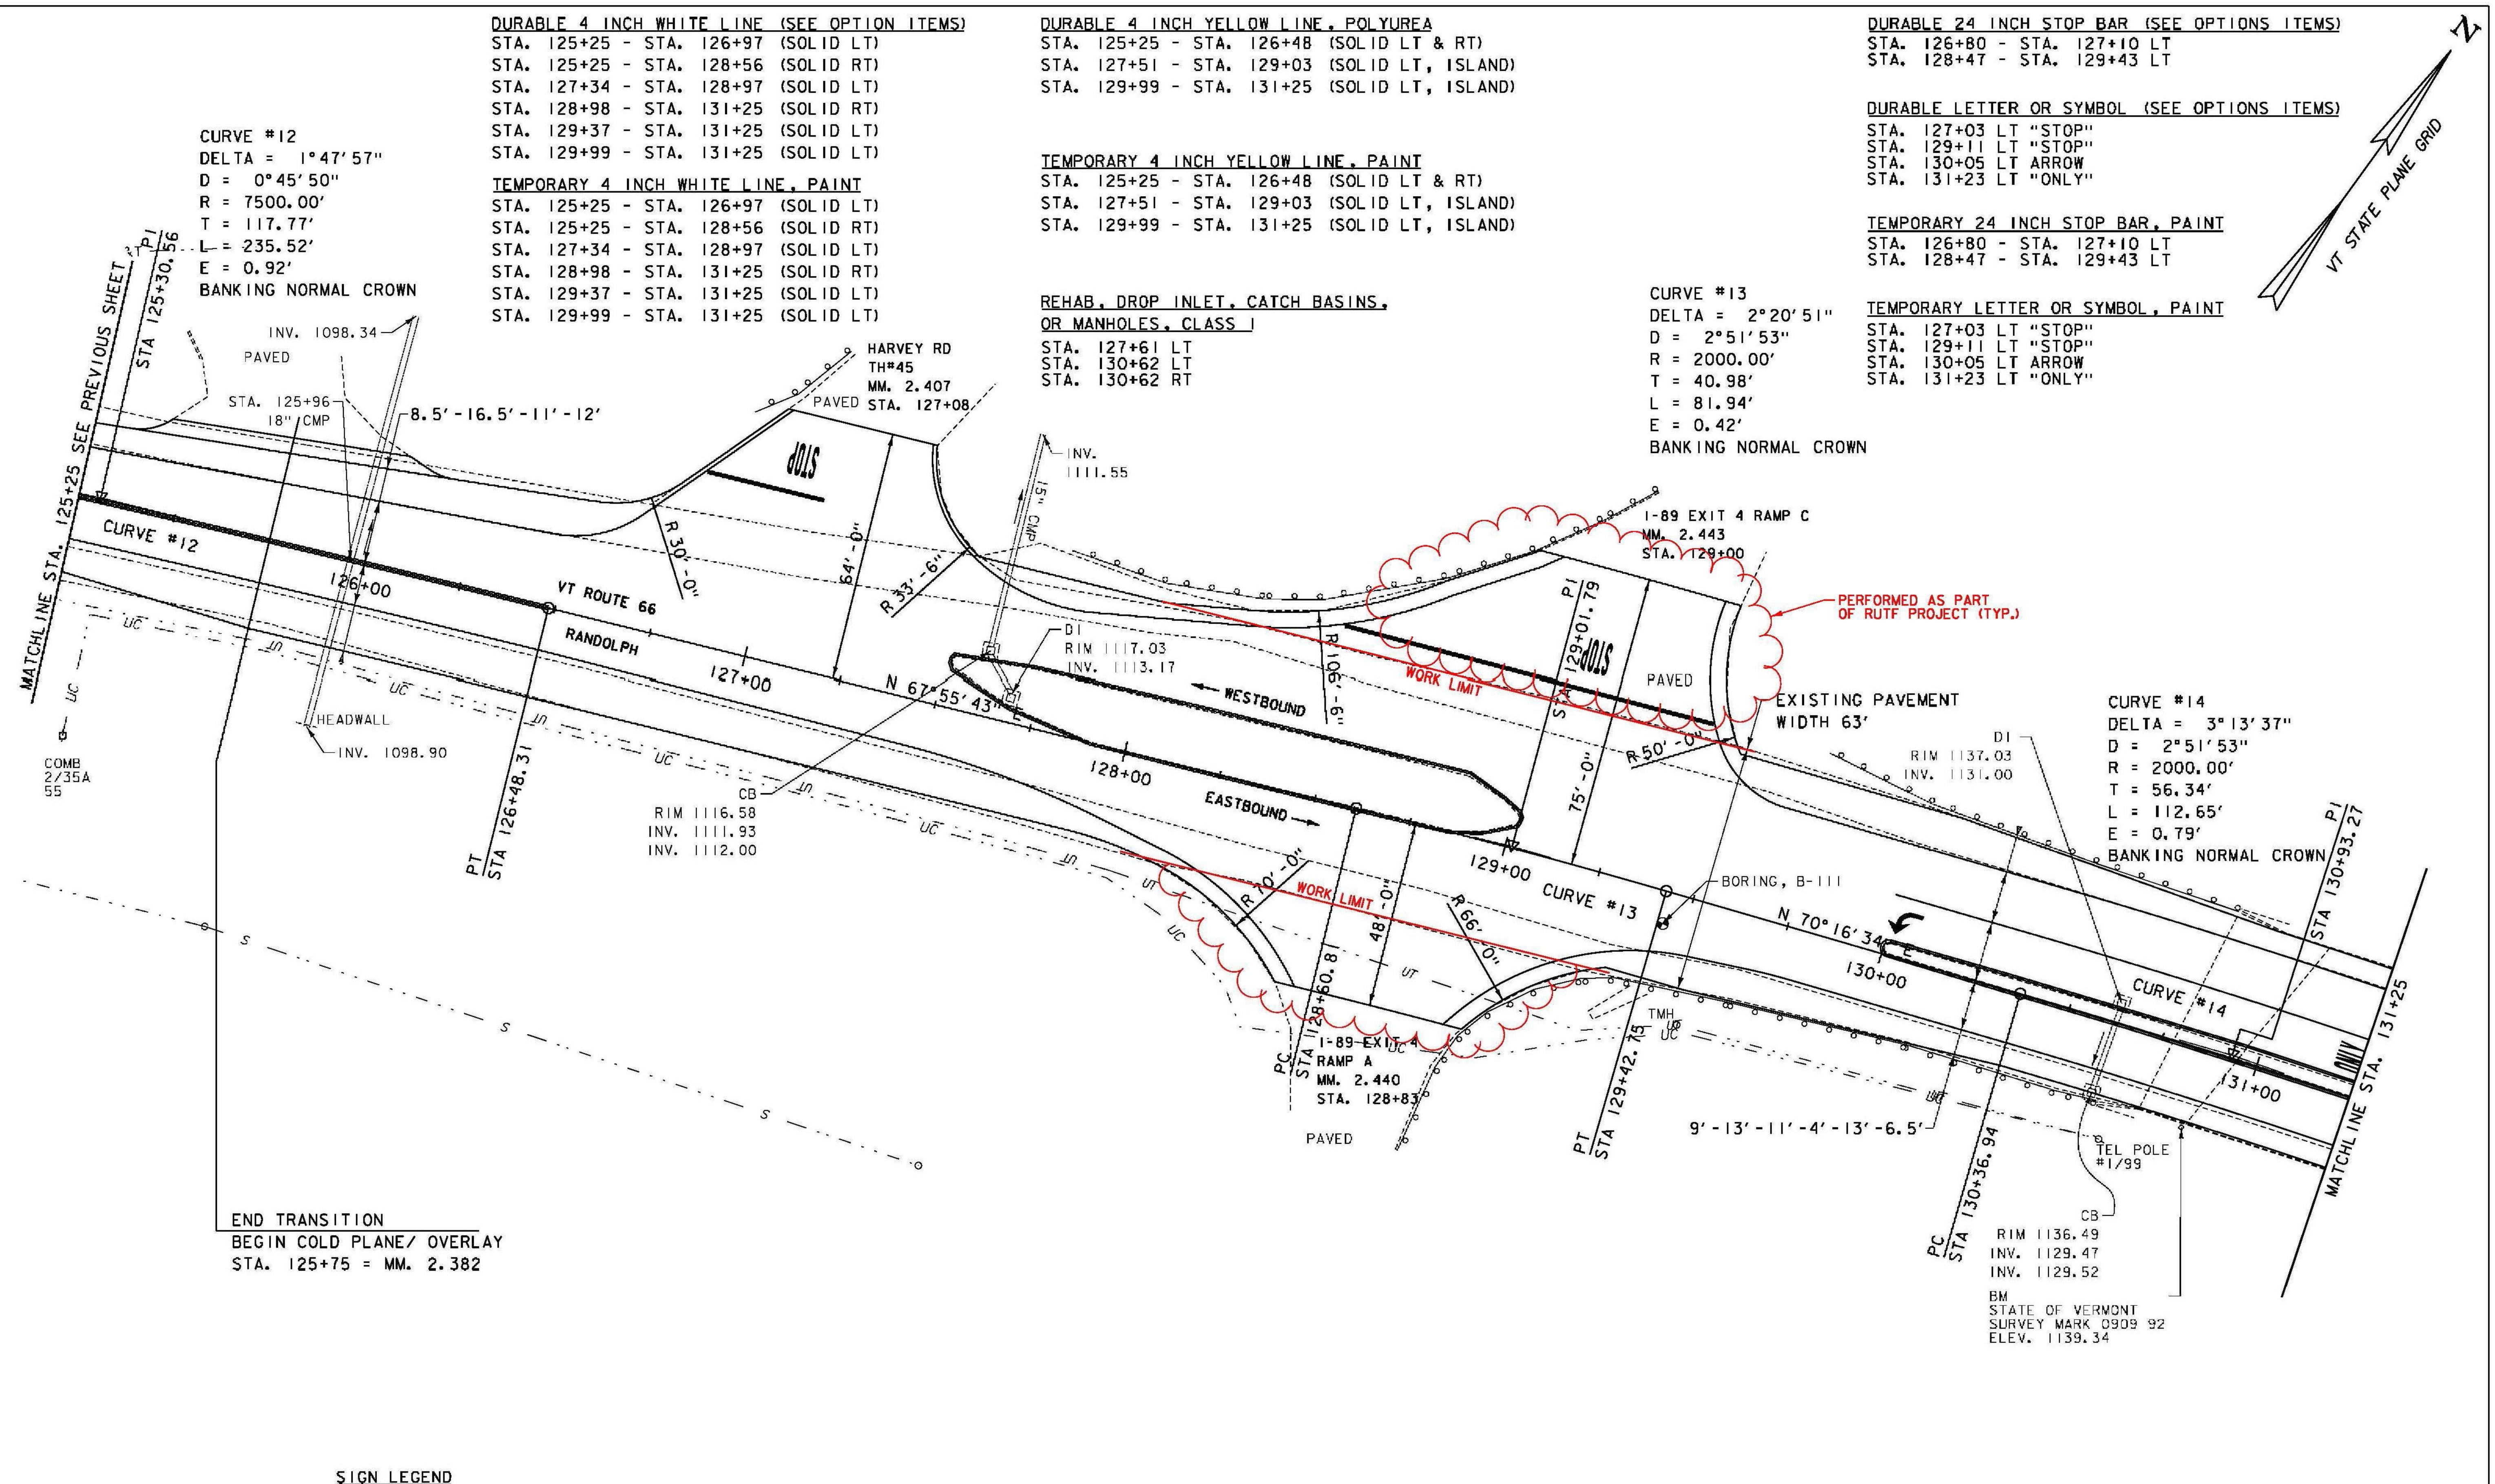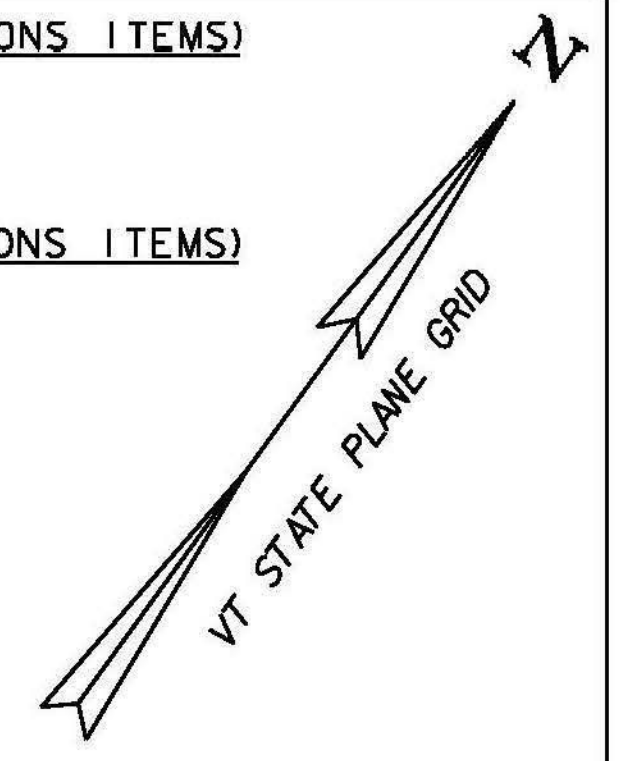

END TRANSITION
 BEGIN COLD PLANE/ OVERLAY
 STA. 125+75 = MM. 2.382

SIGN LEGEND
 R = REMOVE
 R&S = REMOVE AND SALVAGE
 RET = RETAIN
 S = SALVAGE
 N = NEW
 B-B = BACK TO BACK
 --- = EXISTING
 — = NEW



PROJECT NAME: RANDOLPH	PLOT DATE: 6/5/2014
PROJECT NUMBER: STP 2932 (1)	DRAWN BY: B. BRESLEND
FILE NAME: z10c270.dgn	CHECKED BY: C. LATHROP
PROJECT LEADER: C. LATHROP	DESIGNED BY: B. BRESLEND
DESIGNED BY: B. BRESLEND	PROJECT LAYOUT SHEET 19
PROJECT LAYOUT SHEET 19	SHEET 48 OF 276