


CURVE #12
 DELTA = 1°47'57"
 D = 0°45'50"
 R = 7500.00'
 T = 117.77'
 L = 235.52'
 E = 0.92'
 BANKING NORMAL CROWN

REMOVING SIGNS
 AS SHOWN - 21

ERECTING SALVAGED SIGNS
 AS SHOWN - 10


CURVE #13
 DELTA = 2°20'51"
 D = 2°51'53"
 R = 2000.00'
 T = 40.98'
 L = 81.94'
 E = 0.42'
 BANKING NORMAL CROWN

CURVE #14
 DELTA = 3°13'37"
 D = 2°51'53"
 R = 2000.00'
 T = 56.34'
 L = 112.65'
 E = 0.79'
 BANKING NORMAL CROWN

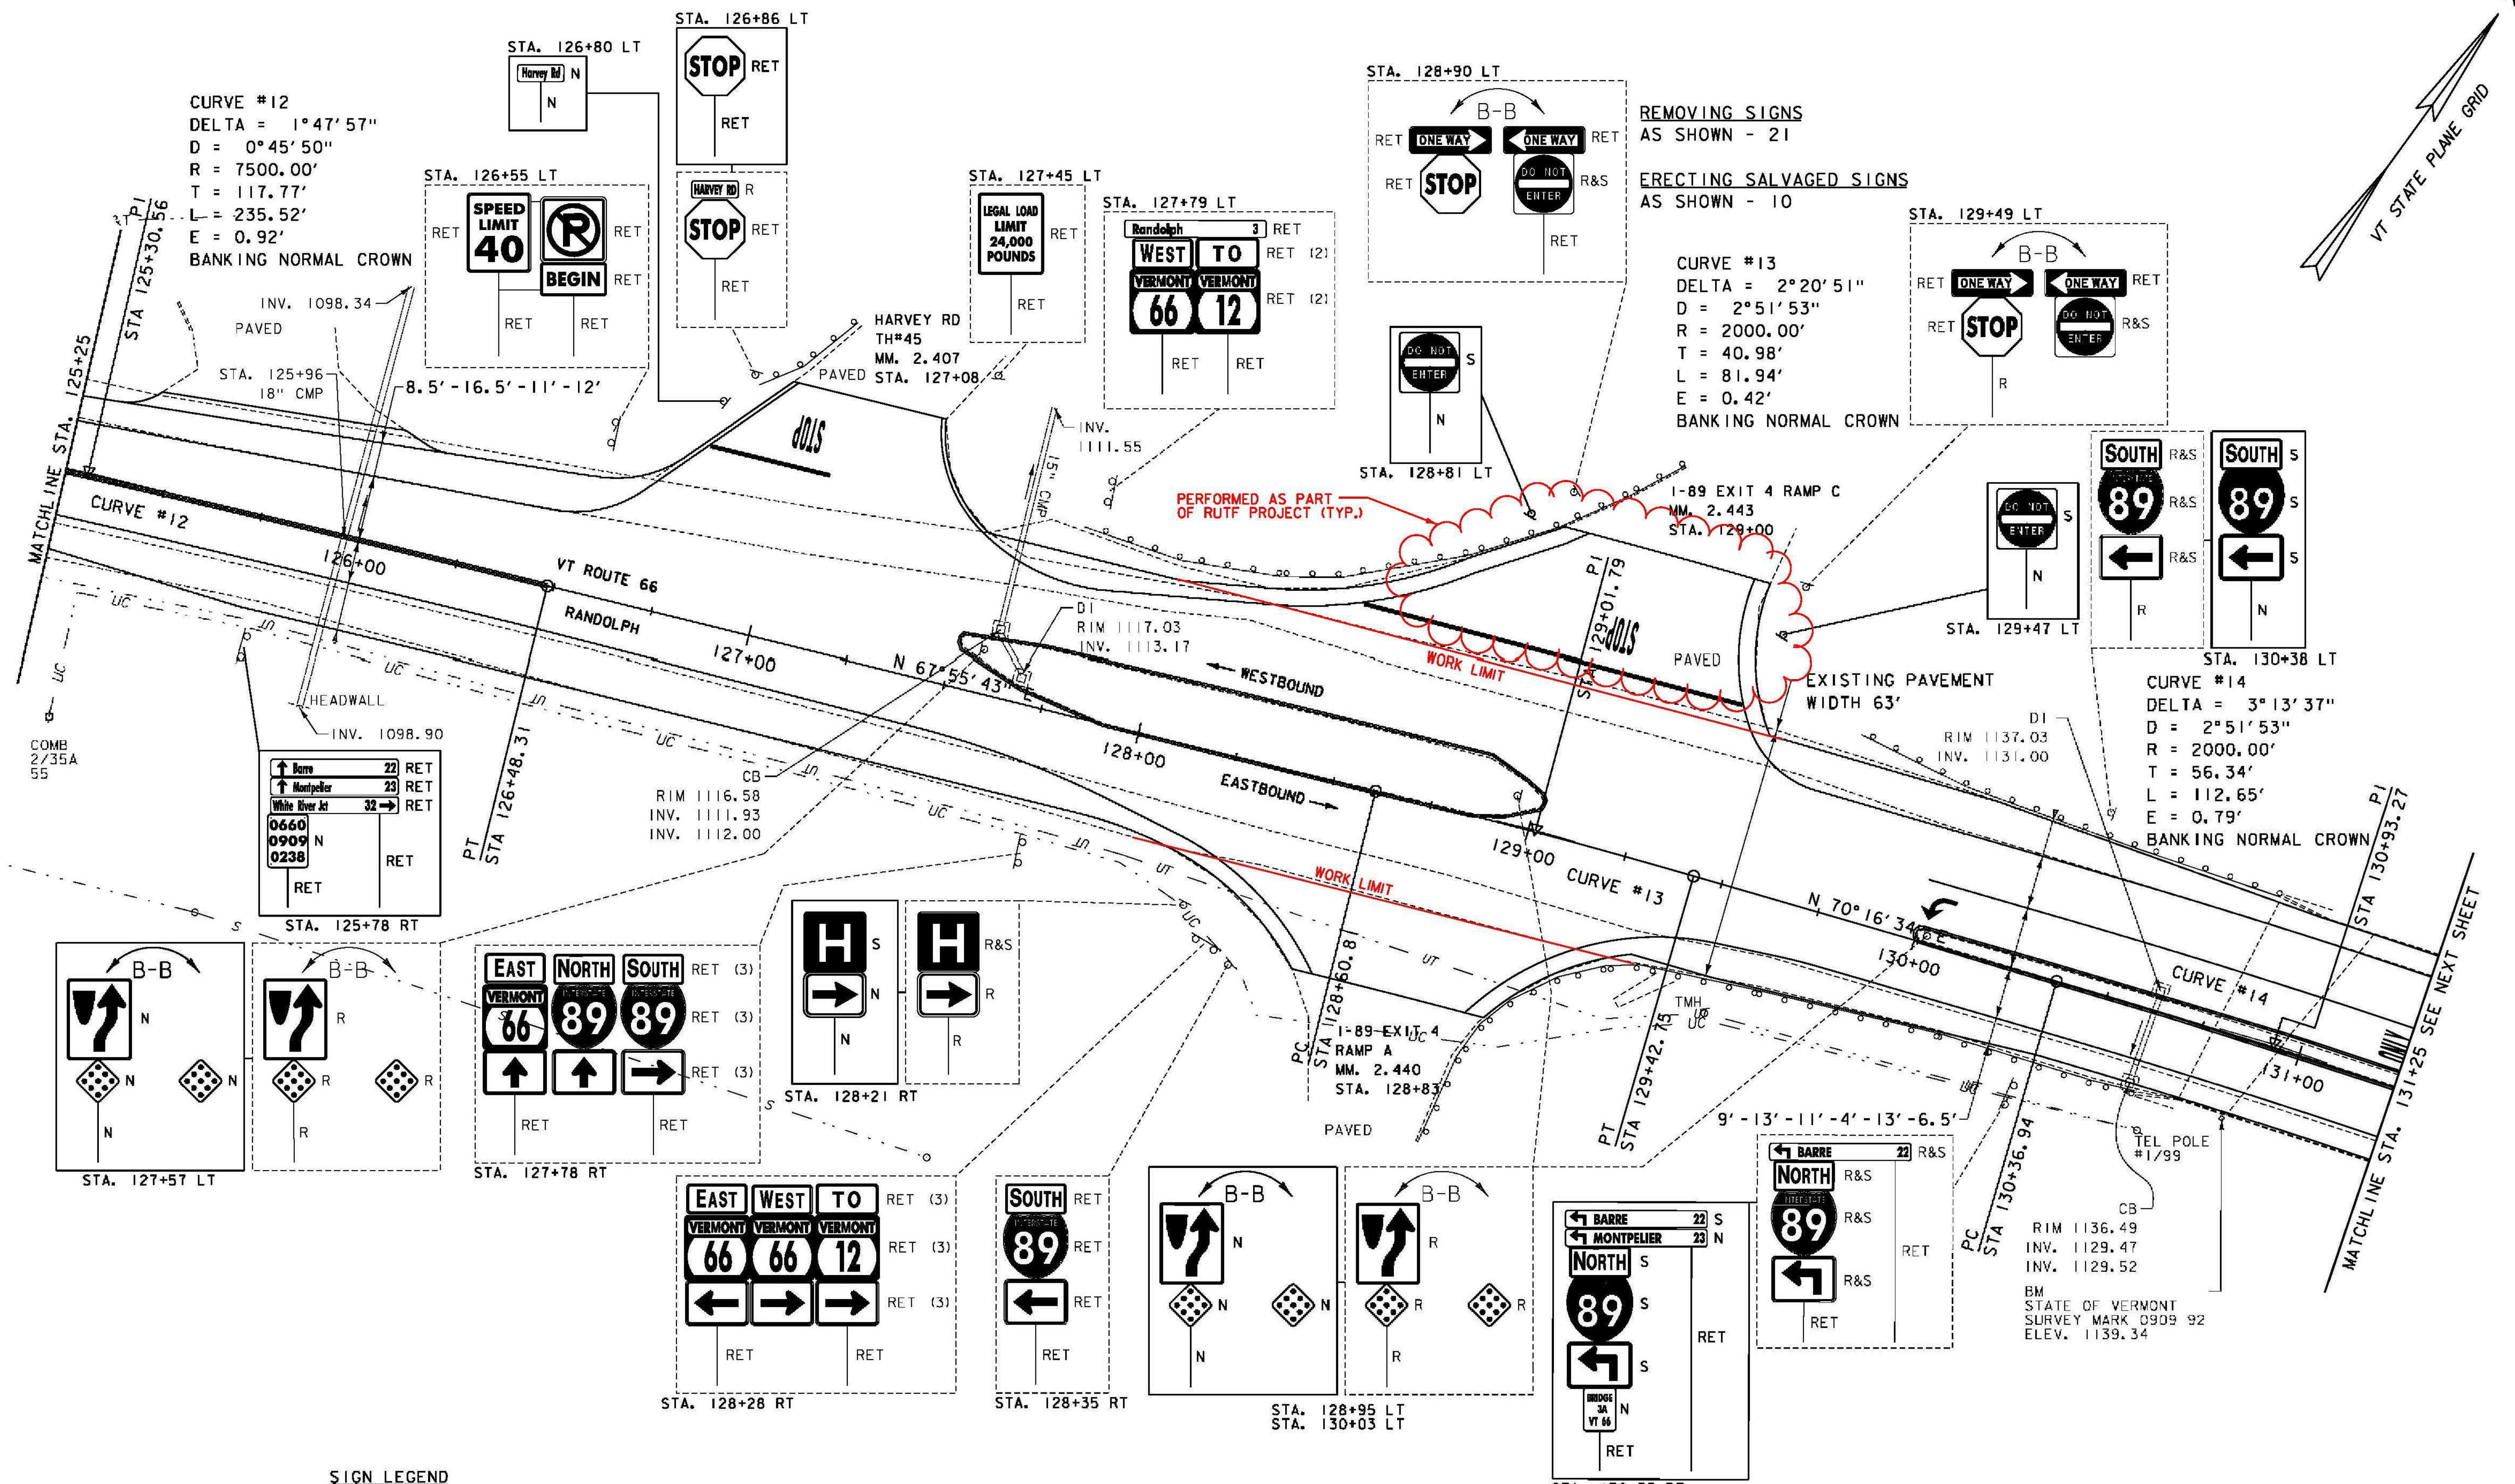

SIGN LEGEND

R = REMOVE
 R&S = REMOVE AND SALVAGE
 RET = RETAIN
 S = SALVAGE
 N = NEW
 B-B = BACK TO BACK
 --- = EXISTING
 — = NEW

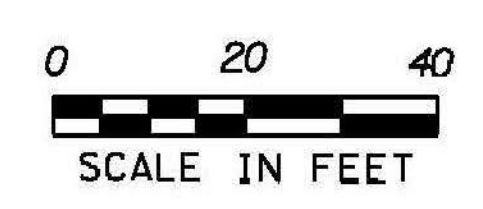

PROJECT NAME: RANDOLPH
 PROJECT NUMBER: STP 2932 (1)

FILE NAME: z10C270.dgn
 PROJECT LEADER: C. LATHROP
 DESIGNED BY: B. BRESLEND
 PROJECT LAYOUT SHEET 19A

PLOT DATE: 6/5/2014
 DRAWN BY: B. BRESLEND
 CHECKED BY: E. DETRICK
 SHEET 49 OF 276