

DURABLE 4 INCH WHITE LINE (SEE OPTION ITEMS)
 STA. 136+25 - STA. 136+94 (SOLID RT)
 STA. 136+25 - STA. 137+03 (SOLID LT)
 STA. 137+30 - STA. 138+90 (SOLID LT)
 STA. 137+35 - STA. 138+95 (SOLID LT)
 STA. 137+56 - STA. 142+25 (SOLID RT)
 STA. 139+38 - STA. 142+25 (SOLID LT)

TEMPORARY 4 INCH WHITE LINE, PAINT
 STA. 136+25 - STA. 136+94 (SOLID RT)
 STA. 136+25 - STA. 137+03 (SOLID LT)
 STA. 137+30 - STA. 138+90 (SOLID LT)
 STA. 137+35 - STA. 138+95 (SOLID LT)
 STA. 137+56 - STA. 142+25 (SOLID RT)
 STA. 139+38 - STA. 142+25 (SOLID LT)



DURABLE 4 INCH YELLOW LINE, POLYUREA
 STA. 137+30 - STA. 138+90 (SOLID LT, ISLAND)
 STA. 139+39 - STA. 140+70 (CENTERLINE LT)
 STA. 139+39 - STA. 142+25 (SOLID LT & RT)

TEMPORARY 4 INCH YELLOW LINE, PAINT
 STA. 137+30 - STA. 138+90 (SOLID LT, ISLAND)
 STA. 139+39 - STA. 140+70 (CENTERLINE LT)
 STA. 139+39 - STA. 142+25 (SOLID LT & RT)

DURABLE 8 INCH YELLOW LINE (SEE OPTION ITEMS)
 STA. 139+40 - STA. 140+61 (HATCH LT)

TEMPORARY 8 INCH YELLOW LINE, PAINT
 STA. 139+40 - STA. 140+61 (HATCH LT)

CURVE #110
 DELTA = 6°44'05"
 D = 5°43'46"
 R = 1000.00'
 T = 58.84'
 L = 117.54'
 E = 1.73'

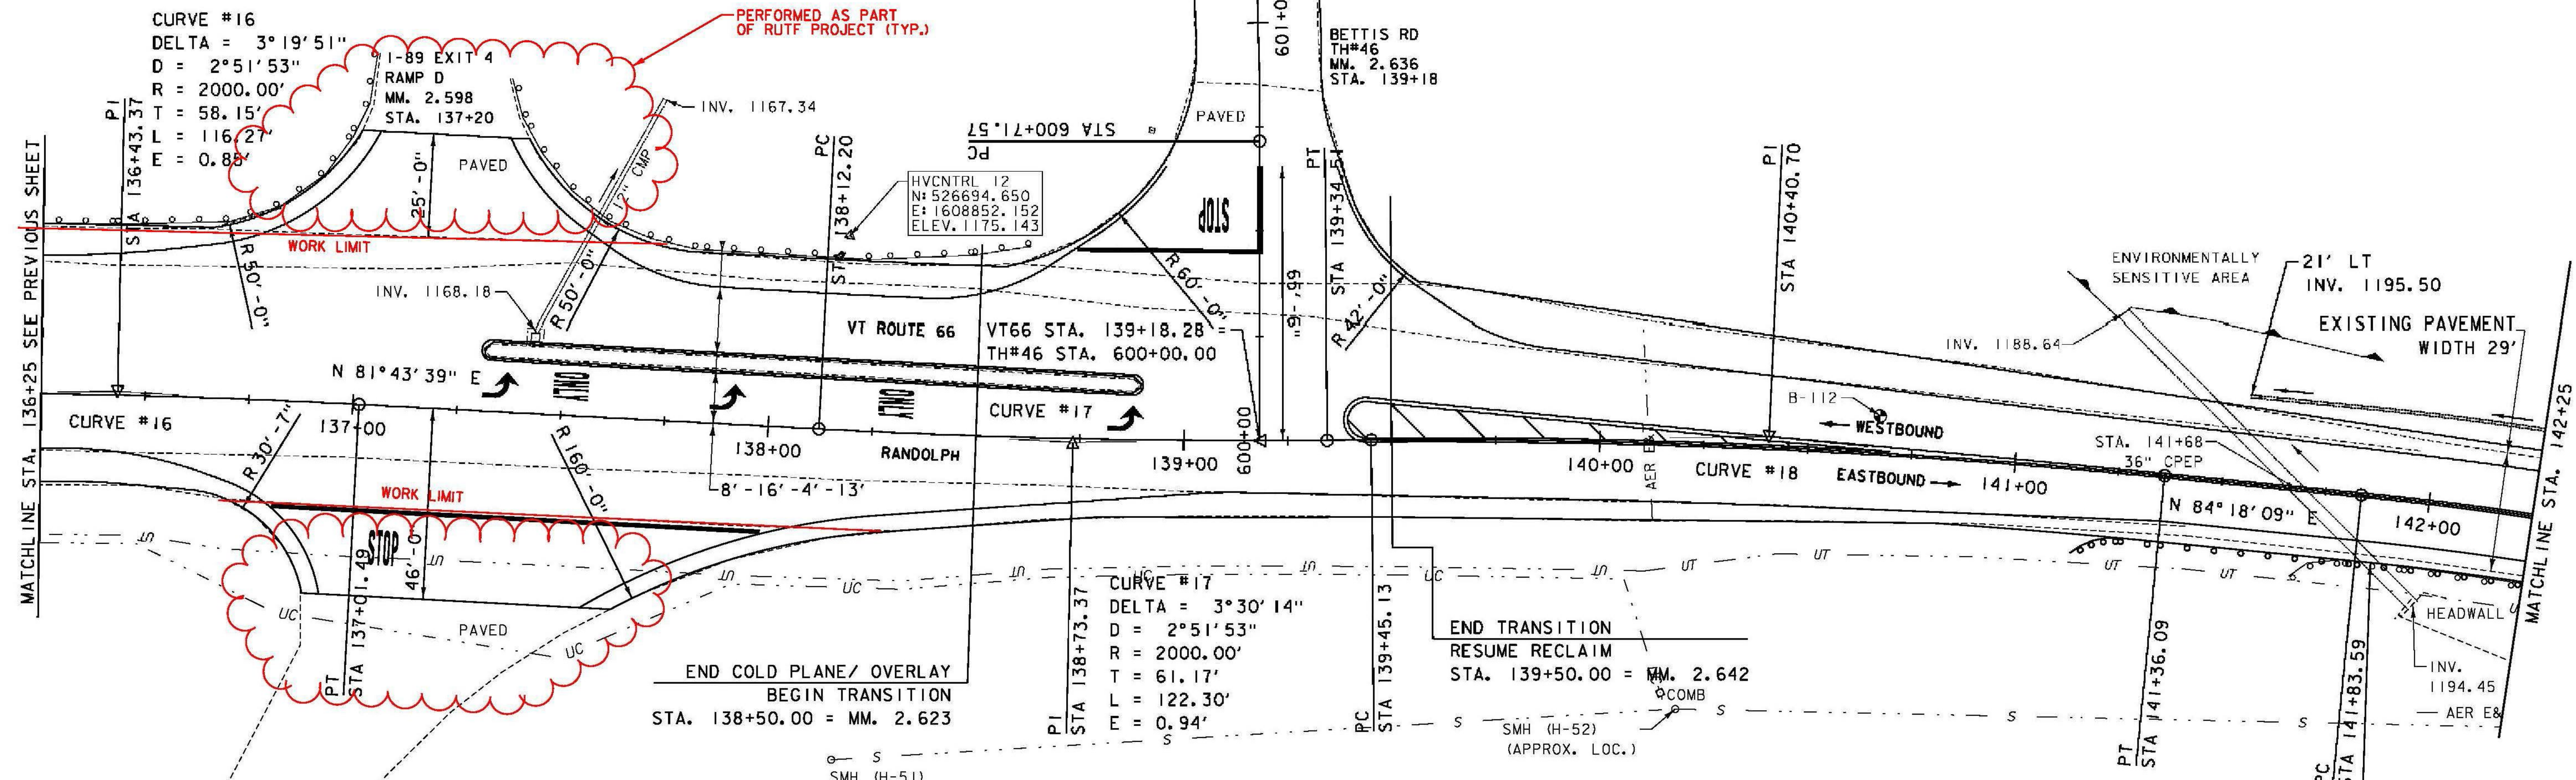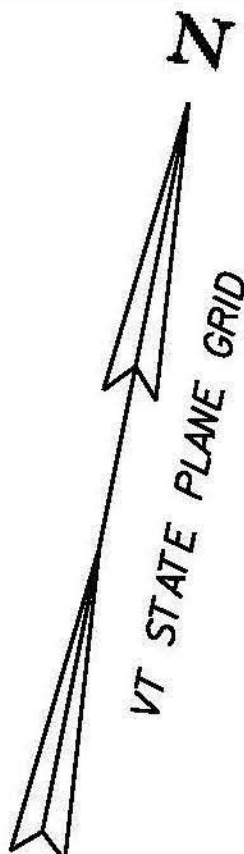

CURVE #16
 DELTA = 3°19'51"
 D = 2°51'53"
 R = 2000.00'
 T = 58.15'
 L = 116.27'
 E = 0.88'

CURVE #17
 DELTA = 3°30'14"
 D = 2°51'53"
 R = 2000.00'
 T = 61.17'
 L = 122.30'
 E = 0.94'

CURVE #18
 DELTA = 6°04'43"
 D = 3°10'59"
 R = 1800.00'
 T = 95.57'
 L = 190.97'
 E = 2.54'

1-89 EXIT 4 RAMP B
 MM. 2.600
 STA. 137+26

DURABLE 24 INCH STOP BAR (SEE OPTIONS ITEMS)
 STA. 136+82 - STA. 137+99 RT
 STA. 138+73 - STA. 139+19 LT

TEMPORARY 24 INCH STOP BAR, PAINT
 STA. 136+82 - STA. 137+99 RT
 STA. 138+73 - STA. 139+19 LT

DURABLE LETTER OR SYMBOL (SEE OPTIONS ITEMS)
 STA. 137+09 RT "STOP"
 STA. 137+35 RT ARROW
 STA. 137+52 LT "ONLY"
 STA. 137+90 LT ARROW
 STA. 138+31 LT "ONLY"
 STA. 138+86 LT ARROW
 STA. 139+09 LT "STOP"

TEMPORARY LETTER OR SYMBOL, PAINT
 STA. 137+09 RT "STOP"
 STA. 137+35 RT ARROW
 STA. 137+52 LT "ONLY"
 STA. 137+90 LT ARROW
 STA. 138+31 LT "ONLY"
 STA. 138+86 LT ARROW
 STA. 139+09 LT "STOP"

6 INCH UNDERDRAIN PIPE
 STA. 141+55 - STA. 142+25 LT

REMOVAL AND DISPOSAL OF GUARDRAIL
 STA. 137+25 - STA. 138+62 LT
 STA. 141+68 - STA. 142+25 RT

ANCHOR FOR STEEL BEAM RAIL
 STA. 141+15 RT
 141+20

STEEL BEAM GUARDRAIL, GALVANIZED
 STA. 141+15 - STA. 141+77.5 RT 141+75
 STA. 142+02.5 - STA. 142+25 RT 142+00

REHAB. DROP INLET, CATCH BASINS, OR MANHOLES, CLASS I
 STA. 137+43 LT

STEEL BEAM GUARDRAIL, GALVANIZED/NESTED
 STA. 141+77.5 - STA. 142+02.5 RT 141+75
 142+00

SIGN LEGEND
 R = REMOVE
 R&S = REMOVE AND SALVAGE
 RET = RETAIN
 S = SALVAGE
 N = NEW
 B-B = BACK TO BACK
 --- = EXISTING
 --- = NEW

ENVIRONMENTALLY SENSITIVE LOCATIONS:

NO.	LIMITS	POS.	TYPE
2.	STA. 141+09 - STA. 141+85	LT	-



PROJECT NAME: RANDOLPH
 PROJECT NUMBER: STP 2932 (1)
 FILE NAME: z10c270.dgn
 PROJECT LEADER: C. LATHROP
 DESIGNED BY: B. BRESLEND
 PROJECT LAYOUT SHEET 21
 PLOT DATE: 6/5/2014
 DRAWN BY: B. BRESLEND
 CHECKED BY: C. LATHROP
 SHEET 51 OF 276