
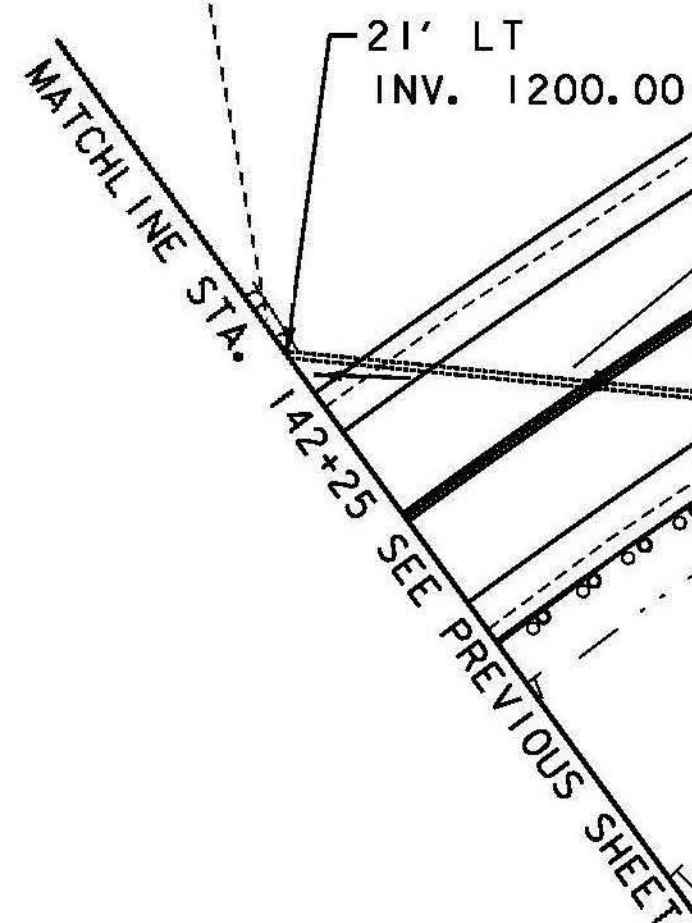
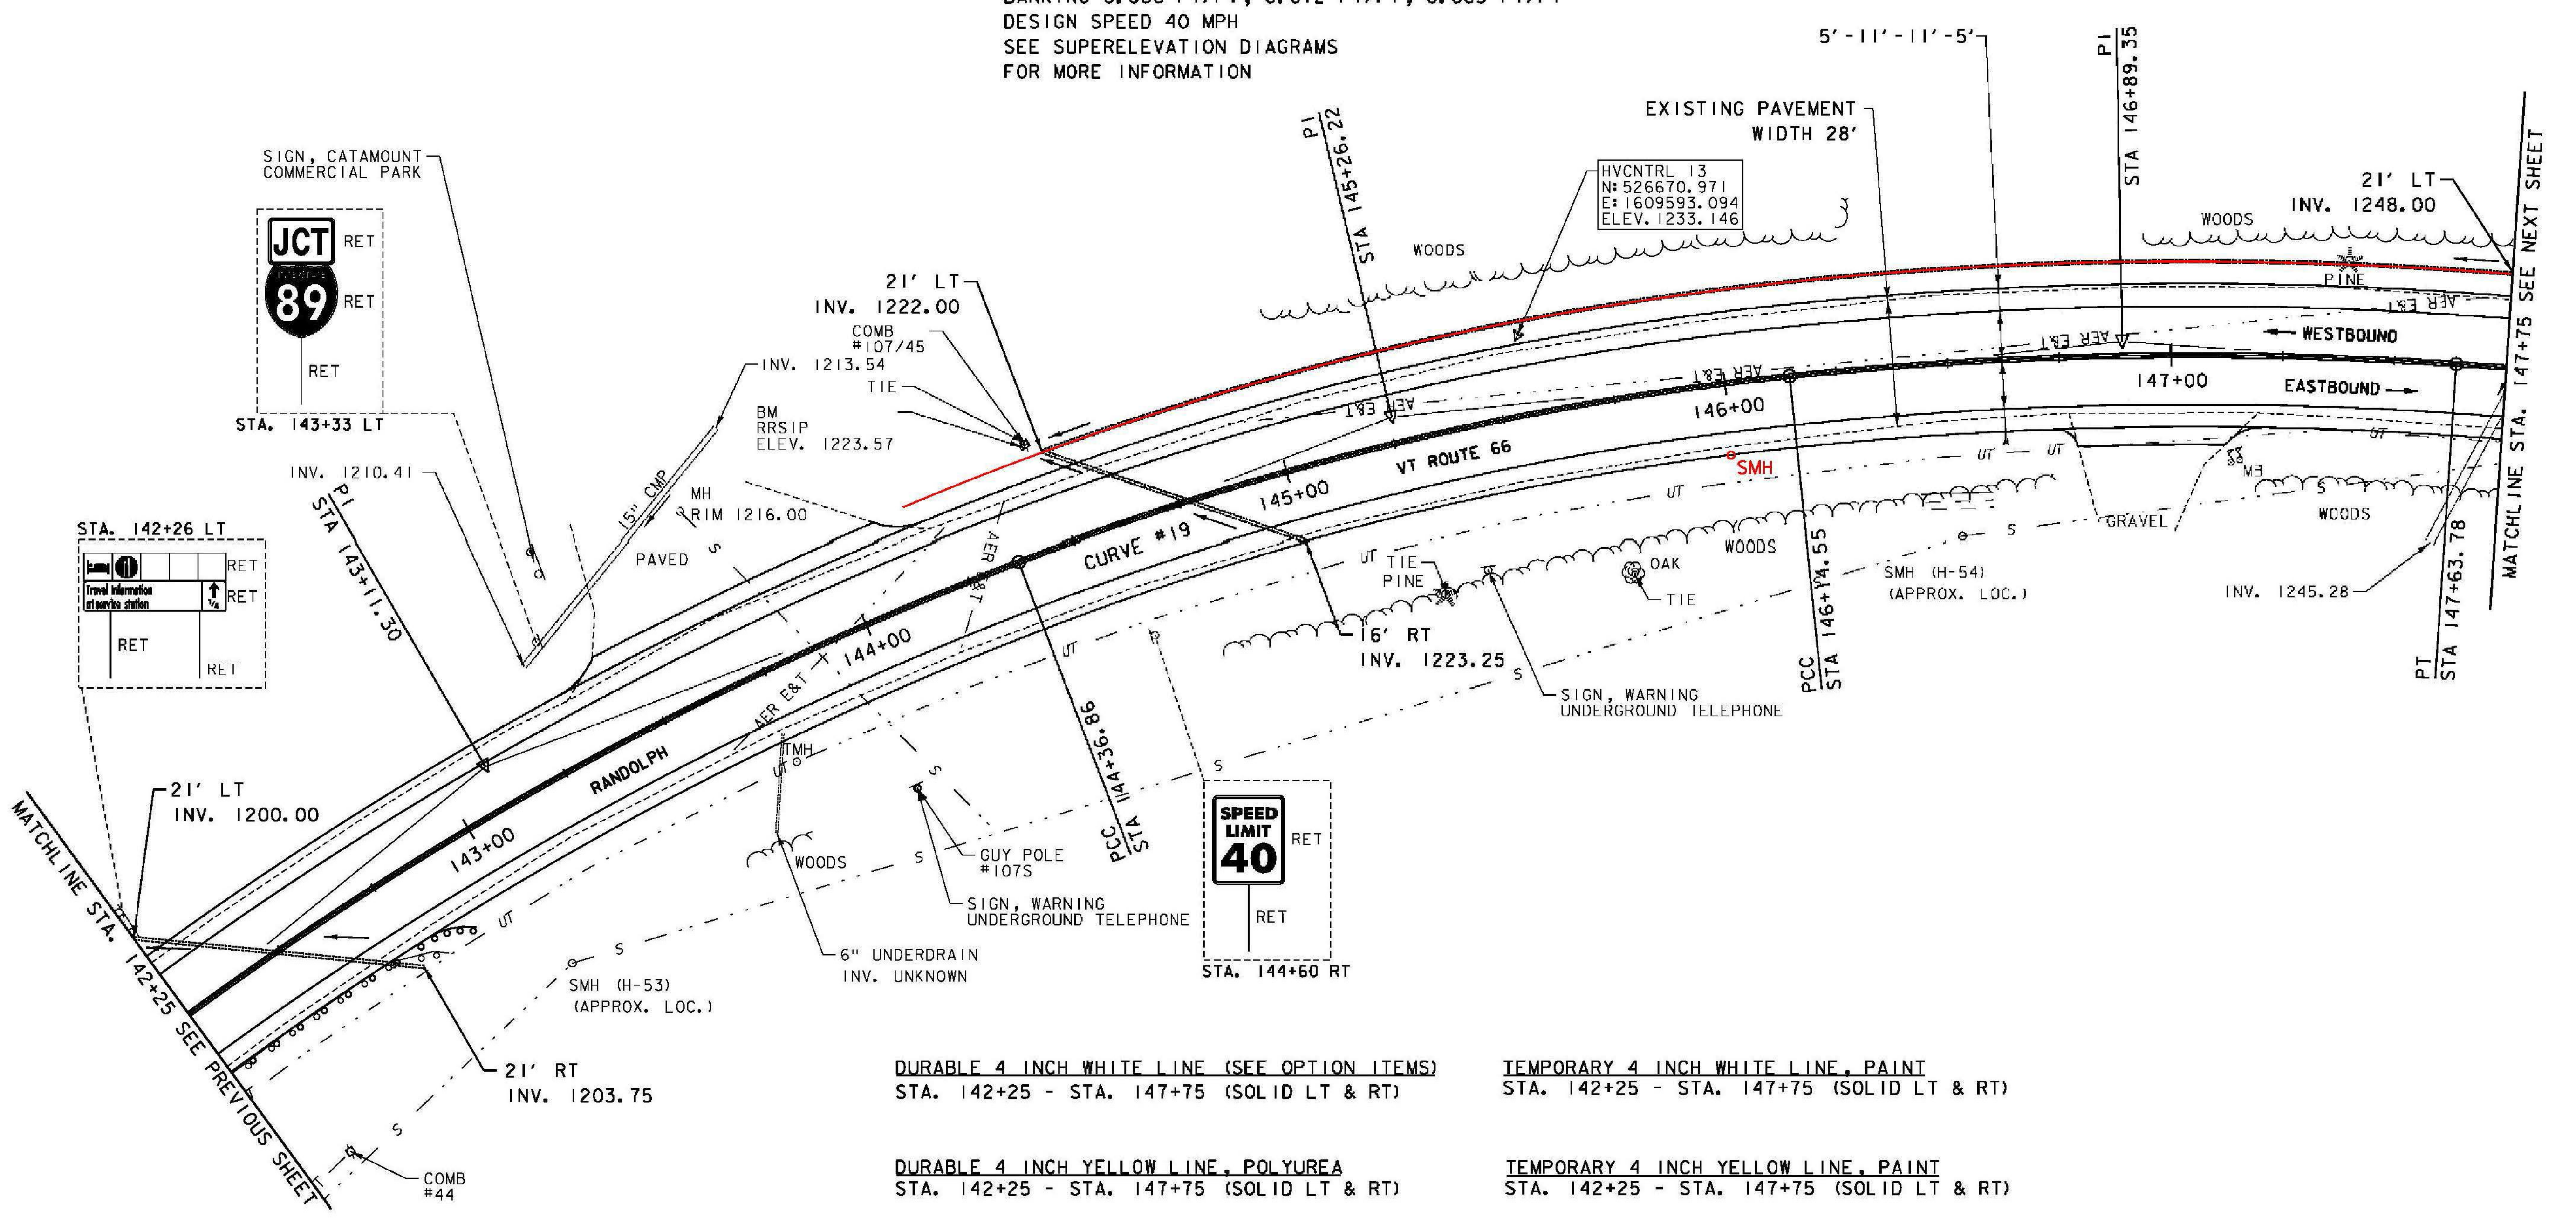


CURVE #19
 DELTA = 42°58'18"
 D = 7°09'43" (1) D = 8°29'18" (2) D = 6°31'59" (3)
 R = 800.00' (1) R = 675.00' (2) R = 877.00' (3)
 T = 302.23' (1) T = 305.89' (2)
 L = 253.27' (1) L = 177.69' (2) L = 149.23' (3)
 E = 55.18'
 BANKING 0.066 FT/FT, 0.072 FT/FT, 0.063 FT/FT
 DESIGN SPEED 40 MPH
 SEE SUPERELEVATION DIAGRAMS
 FOR MORE INFORMATION

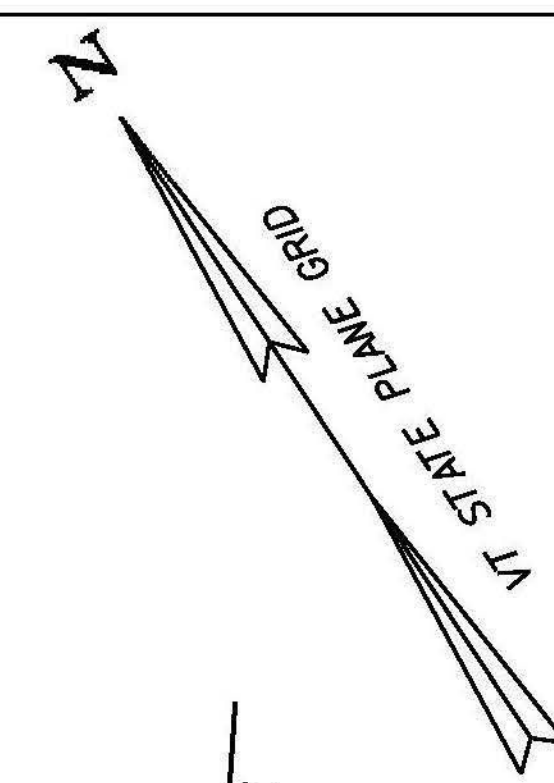

DURABLE 4 INCH WHITE LINE (SEE OPTION ITEMS)
 STA. 142+25 - STA. 147+75 (SOLID LT & RT)

TEMPORARY 4 INCH WHITE LINE, PAINT
 STA. 142+25 - STA. 147+75 (SOLID LT & RT)

DURABLE 4 INCH YELLOW LINE, POLYUREA
 STA. 142+25 - STA. 147+75 (SOLID LT & RT)

TEMPORARY 4 INCH YELLOW LINE, PAINT
 STA. 142+25 - STA. 147+75 (SOLID LT & RT)


REMOVAL AND DISPOSAL OF GUARDRAIL
 STA. 142+25 - STA. 142+82 RT

6 INCH UNDERDRAIN PIPE
 STA. 142+25 LT - STA. 142+75 RT
 STA. 144+50 LT - STA. 145+00 RT
~~STA. 144+50 - STA. 147+75 LT~~
 STA. 144+20 - STA. 147+75 LT

STEEL BEAM GUARDRAIL, GALVANIZED
 STA. 142+25 - STA. 142+90 RT

ANCHOR FOR STEEL BEAM RAIL
 STA. ~~142+90~~ RT
 142+85

- SIGN LEGEND**
- R = REMOVE
 - R&S = REMOVE AND SALVAGE
 - RET = RETAIN
 - S = SALVAGE
 - N = NEW
 - B-B = BACK TO BACK
 - = EXISTING
 - = NEW

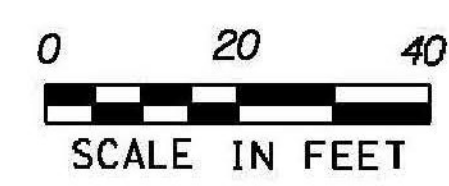

| | | |
|------------------------------|-------------------------|-------------------------|
| PROJECT NAME: RANDOLPH | FILE NAME: z10c270.dgn | PLOT DATE: 6/5/2014 |
| PROJECT NUMBER: STP 2932 (1) | DESIGNED BY: C. LATHROP | DRAWN BY: B. BRESLEND |
| | CHECKED BY: C. LATHROP | PROJECT LAYOUT SHEET 22 |
| | | SHEET 53 OF 276 |