

DURABLE 4 INCH WHITE LINE (SEE OPTION ITEMS)
STA. 147+75 - STA. 153+75 (SOLID LT & RT)

DURABLE 4 INCH YELLOW LINE, POLYUREA
STA. 147+75 - STA. 153+75 (SOLID LT & RT)

REHAB. DROP INLETS, CATCH BASINS, OR
MANHOLES, CLASS I, CLASS II, CLASS III
~~STA. 147+87 LT NA RETAIN~~

RELOCATE MAILBOX, SINGLE SUPPORT
STA. 149+54 LT

6 INCH UNDERDRAIN PIPE
STA. 152+50 - STA. 153+75 LT

REMOVING SIGNS
AS SHOWN - 1

TEMPORARY 4 INCH WHITE LINE, PAINT
STA. 147+75 - STA. 153+75 (SOLID LT & RT)

TEMPORARY 4 INCH YELLOW LINE, PAINT
STA. 147+75 - STA. 153+75 (SOLID LT & RT)

REMOVAL AND DISPOSAL OF GUARDRAIL
STA. 148+60 - STA. 150+07 RT
STA. 149+52 - STA. 152+23 LT

ANCHOR FOR STEEL BEAM RAIL
STA. ~~148+10~~ RT ~~148+15~~
STA. ~~149+51.25~~ LT ~~149+56~~
STA. ~~150+10~~ RT ~~150+05~~
STA. ~~151+51.25~~ LT ~~151+46~~

STEEL BEAM GUARDRAIL, GALVANIZED
STA. 148+10 - STA. 150+10 RT
~~STA. 149+51.25 - STA. 149+63.75 LT~~
~~STA. 151+38.75 - STA. 151+51.25 LT~~


STEEL BEAM GUARDRAIL, GALVANIZED W/8 FEET POSTS
STA. ~~149+88.75 - STA. 151+38.75 LT~~
~~149+51.25 151+51.25~~

STEEL BEAM GUARDRAIL, GALVANIZED/NESTED W/8 FEET POSTS
STA. ~~149+63.75 - STA. 149+88.75 LT~~
~~149+67 149+92~~

STONE FILL, TYPE I
STA. 149+79 - STA. 151+28 LT
STA. 152+35 - STA. 152+95 RT

GEOTEXTILE FOR SILT FENCE
STA. 149+79 - STA. 151+28 LT
STA. 152+35 - STA. 152+95 RT

GRUBBING MATERIAL (6")
STA. 149+79 - STA. 151+28 LT
STA. 152+35 - STA. 152+95 RT

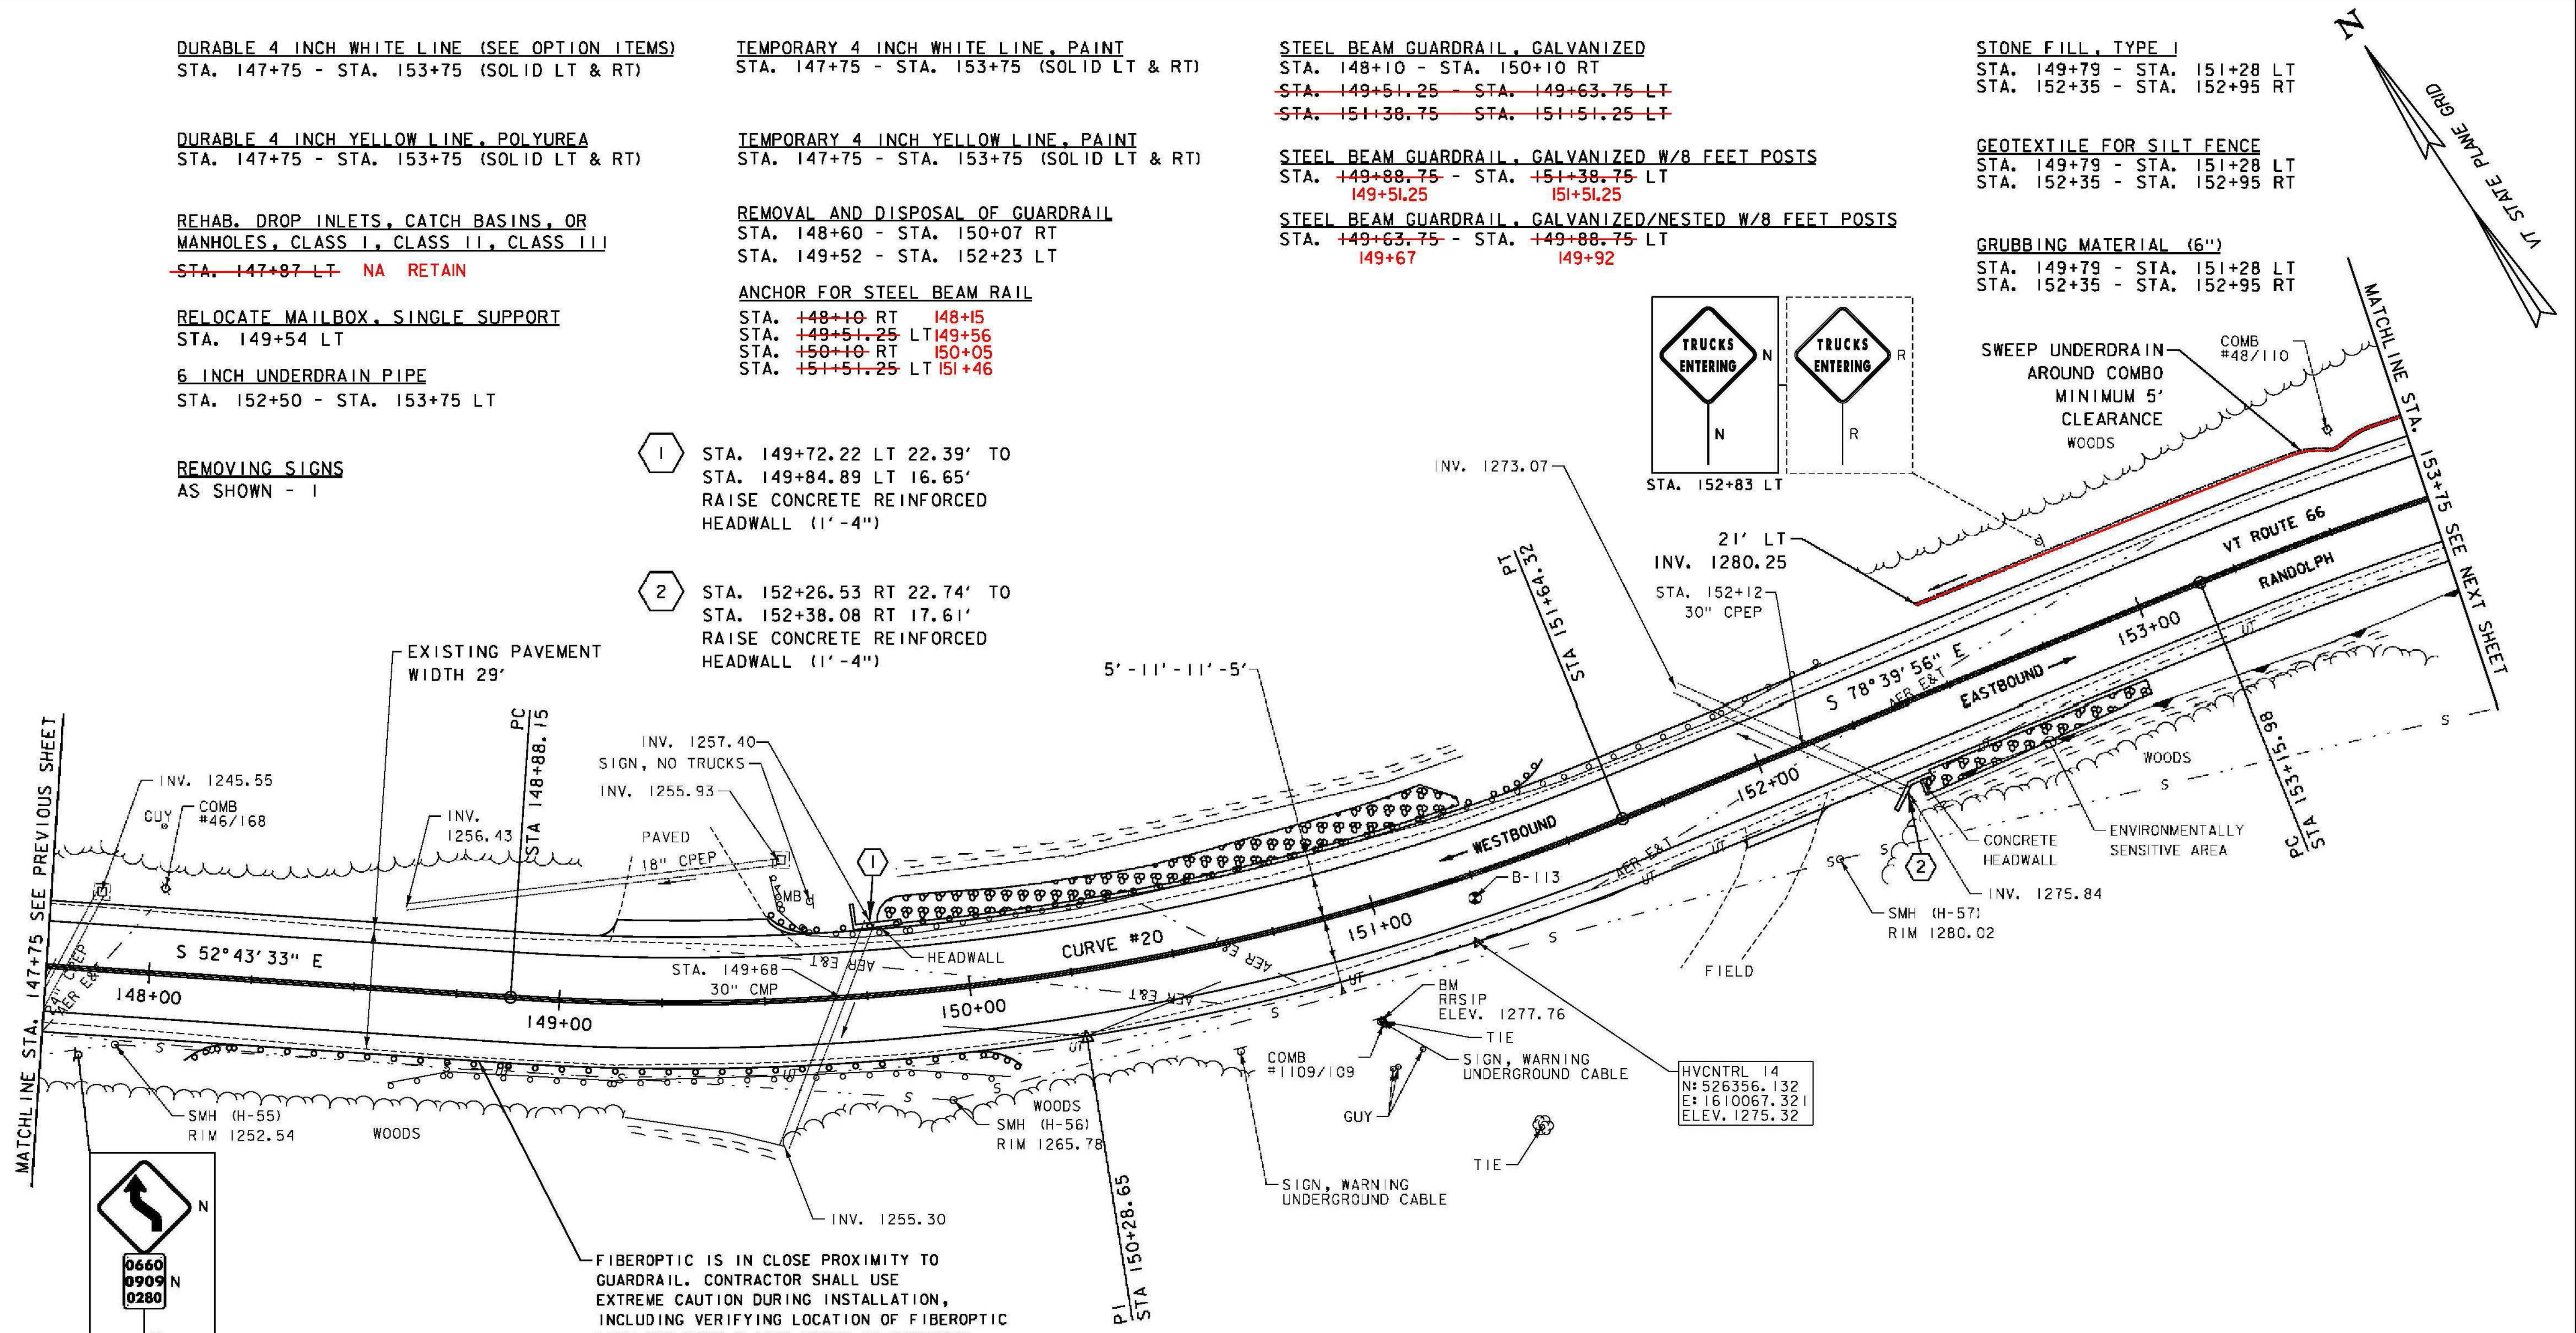

- 1 STA. 149+72.22 LT 22.39' TO STA. 149+84.89 LT 16.65' RAISE CONCRETE REINFORCED HEADWALL (1'-4")
- 2 STA. 152+26.53 RT 22.74' TO STA. 152+38.08 RT 17.61' RAISE CONCRETE REINFORCED HEADWALL (1'-4")

FIBEROPTIC IS IN CLOSE PROXIMITY TO GUARDRAIL. CONTRACTOR SHALL USE EXTREME CAUTION DURING INSTALLATION, INCLUDING VERIFYING LOCATION OF FIBEROPTIC LINE AND HAND PLACED POSTS IF REQUIRED.


CURVE #20
DELTA = 25°56'23"
D = 9°23'34"
R = 610.00'
T = 140.49'
L = 276.17'
E = 15.97'
BANKING 0.075 FT/FT
DESIGN SPEED 40 MPH
SEE SUPERELEVATION DIAGRAMS FOR MORE INFORMATION

ENVIRONMENTALLY SENSITIVE LOCATIONS:

NO.	LIMITS	POS.	TYPE
3.	STA. 152+45 - STA. 153+75	RT	-

SIGN LEGEND

- R = REMOVE
- R&S = REMOVE AND SALVAGE
- RET = RETAIN
- S = SALVAGE
- N = NEW
- B-B = BACK TO BACK
- = EXISTING
- = NEW

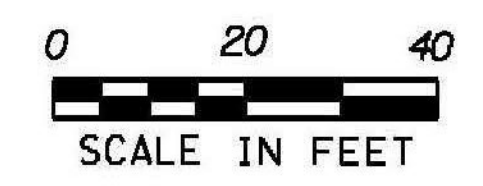

PROJECT NAME: RANDOLPH
PROJECT NUMBER: STP 2932 (1)

FILE NAME: z10c270.dgn
PROJECT LEADER: C. LATHROP
DESIGNED BY: B. BRESLEND
PROJECT LAYOUT SHEET 23

PLOT DATE: 6/5/2014
DRAWN BY: B. BRESLEND
CHECKED BY: C. LATHROP
SHEET 54 OF 276