

DURABLE 4 INCH WHITE LINE (SEE OPTION ITEMS)  
STA. 153+75 - STA. 159+75 (SOLID LT & RT)

DURABLE 4 INCH YELLOW LINE, POLYUREA  
STA. 153+75 - STA. 159+75 (SOLID LT & RT)

CURVE #21  
DELTA = 21°50'32"  
D = 6°11'39" (1) D = 1°29'53" (2)  
R = 925.00' (1) R = 3825.00' (2)  
T = 189.06' (1) T = 319.70' (2)  
L = 304.43' (1) L = 199.31' (2)  
E = 19.12'  
BANKING 0.061 FT/FT, 0.021 FT/FT  
DESIGN SPEED 40 MPH  
SEE SUPERELEVATION DIAGRAMS  
FOR MORE INFORMATION

TEMPORARY 4 INCH WHITE LINE, PAINT  
STA. 153+75 - STA. 159+75 (SOLID LT & RT)

TEMPORARY 4 INCH YELLOW LINE, PAINT  
STA. 153+75 - STA. 159+75 (SOLID LT & RT)



6 INCH UNDERDRAIN PIPE  
STA. 153+75 - STA. 156+50 LT  
STA. 157+05 - STA. 159+25 LT  
157+00 158+30

REMOVING SIGNS  
AS SHOWN - 3

STONE FILL, TYPE I  
STA. 156+00 - STA. 159+50 RT

GEOTEXTILE FOR SILT FENCE  
STA. 156+00 - STA. 159+50 RT

GRUBBING MATERIAL (6")  
STA. 156+00 - STA. 159+50 RT

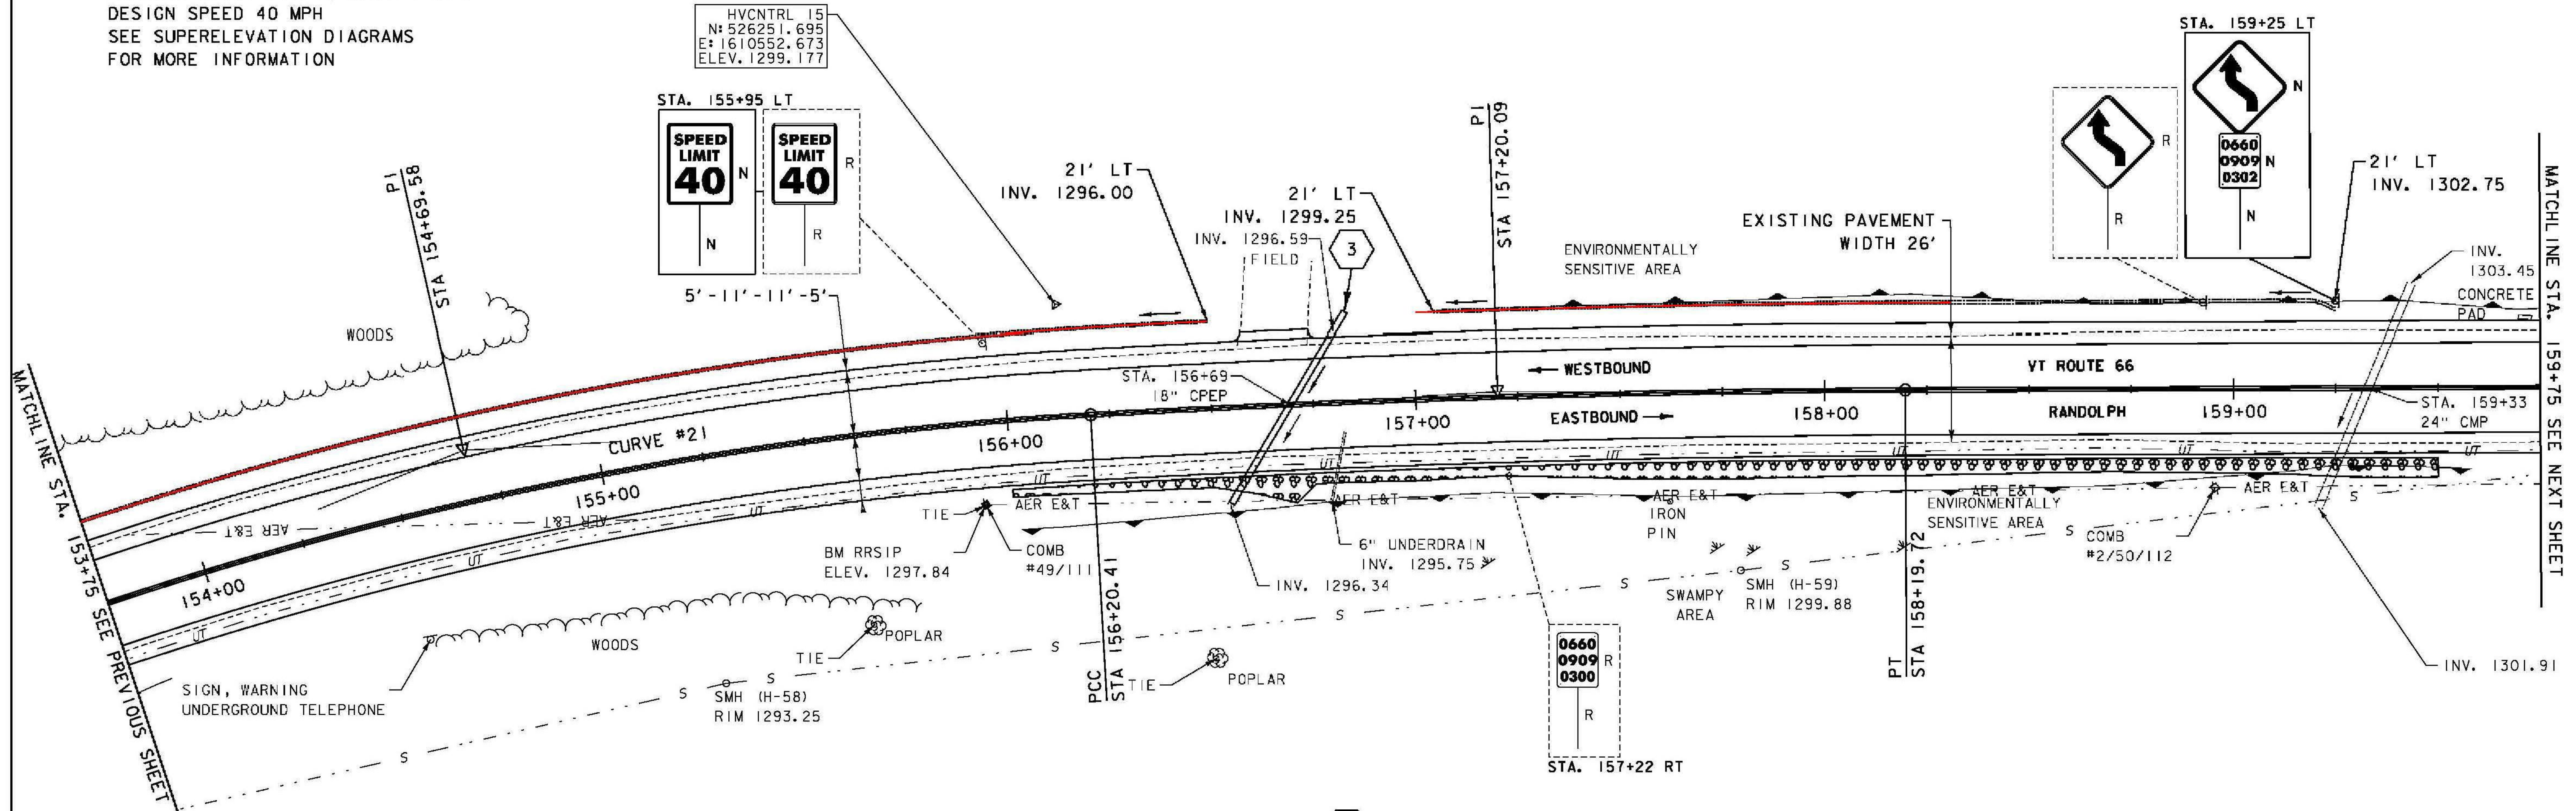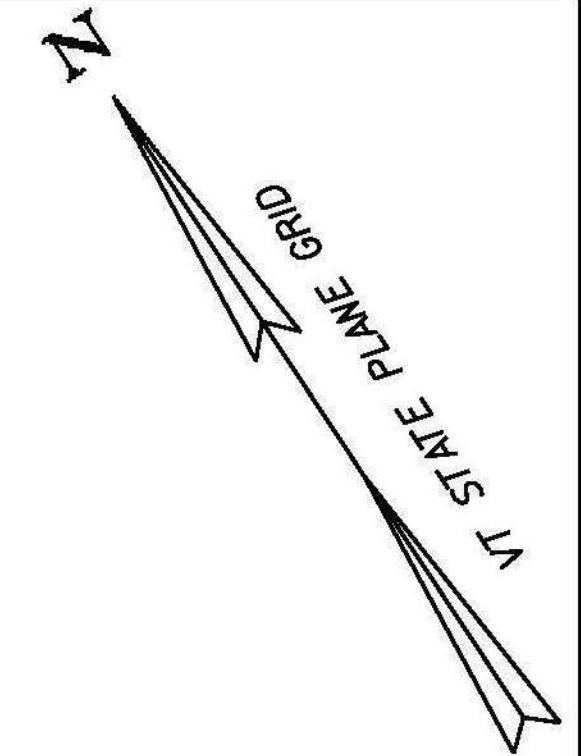


3 STA. 156+53.92 RT 23.42' TO  
STA. 156+83.43 LT 21.81'  
REMOVE EXISTING 18" CPEP  
INSTALL NEW 18" CPEP (54'-0")  
INV. IN = 1299.00'  
INV. OUT = 1296.80'

**ENVIRONMENTALLY SENSITIVE LOCATIONS:**

NO.	LIMITS	POS.	TYPE
3.	STA. 153+75 - STA. 153+84	RT	-
4.	STA. 156+01 - STA. 159+58	RT	-
5.	STA. 157+29 - STA. 159+75	LT	-

**SIGN LEGEND**  
R = REMOVE  
R&S = REMOVE AND SALVAGE  
RET = RETAIN  
S = SALVAGE  
N = NEW  
B-B = BACK TO BACK  
— = EXISTING  
— = NEW

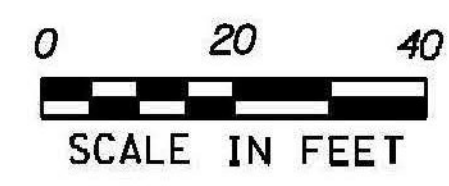

PROJECT NAME: RANDOLPH  
PROJECT NUMBER: STP 2932 (1)  
FILE NAME: z10c270.dgn  
PROJECT LEADER: C. LATHROP  
DESIGNED BY: B. BRESLEND  
PROJECT LAYOUT SHEET 24  
PLOT DATE: 6/5/2014  
DRAWN BY: B. BRESLEND  
CHECKED BY: C. LATHROP  
SHEET 55 OF 276