

DURABLE 4 INCH WHITE LINE (SEE OPTION ITEMS)
 STA. 159+75 - STA. 165+75 (SOLID LT & RT)

TEMPORARY 4 INCH WHITE LINE, PAINT
 STA. 159+75 - STA. 165+75 (SOLID LT & RT)



6 INCH UNDERDRAIN PIPE
 STA. 163+25 - STA. 164+50 LT
 162+92

CHANGING ELEVATION OF SEWER MANHOLES
 STA. 162+97 RT

DURABLE 4 INCH YELLOW LINE, POLYUREA
 STA. 159+75 - STA. 165+75 (SOLID LT & RT)

TEMPORARY 4 INCH YELLOW LINE, PAINT
 STA. 159+75 - STA. 165+75 (SOLID LT & RT)

CURVE #22
 DELTA = 5° 10' 06"
 D = 1° 25' 57"
 R = 4000.00'
 T = 180.53'
 L = 360.82'
 E = 4.07'
 BANKING REVERSE CROWN
 DESIGN SPEED 40 MPH
 SEE SUPERELEVATION DIAGRAMS
 FOR MORE INFORMATION

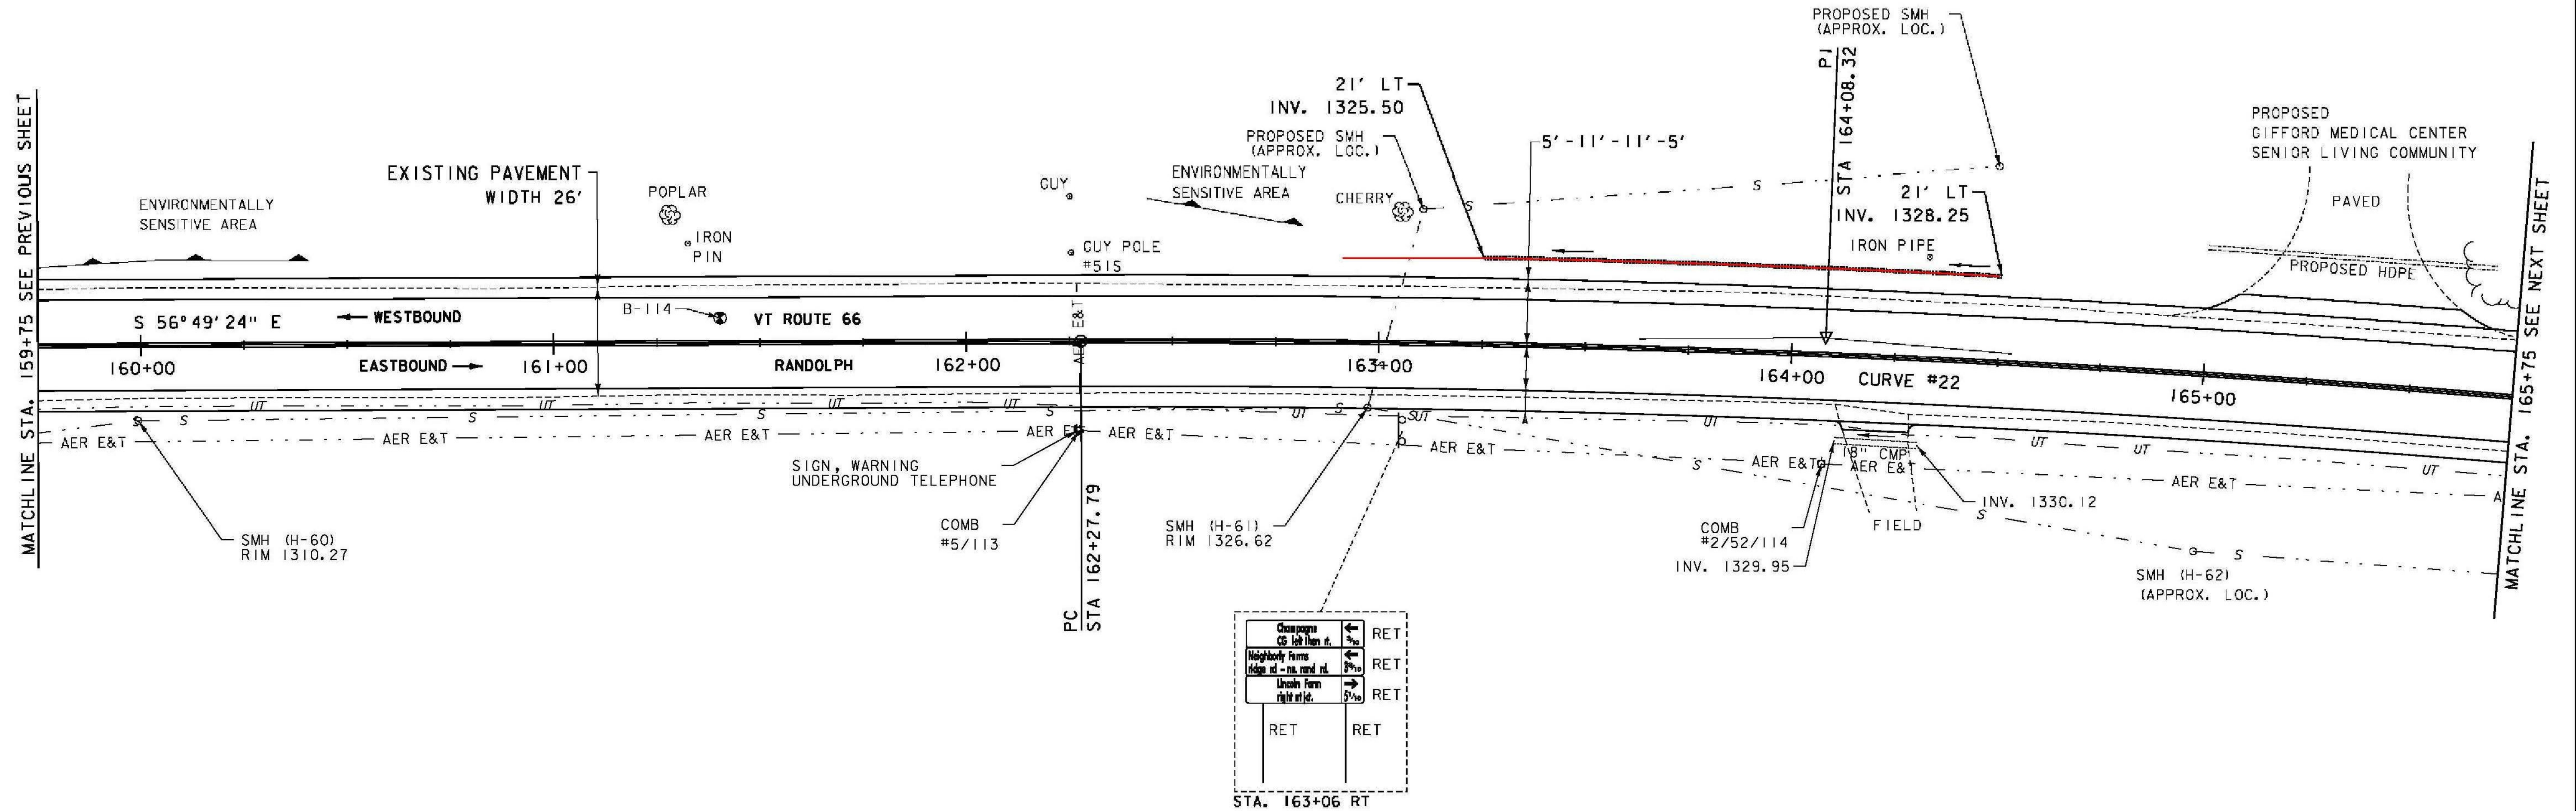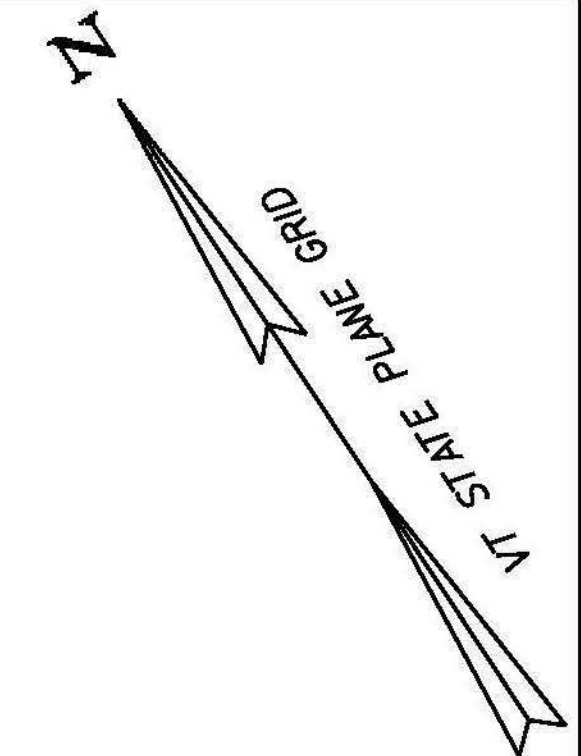

ENVIRONMENTALLY SENSITIVE LOCATIONS:

NO.	LIMITS	POS.	TYPE
5.	STA. 159+75 - STA. 160+41	LT	-
6.	STA. 162+44 - STA. 162+81	LT	-

SIGN LEGEND

- R = REMOVE
- R&S = REMOVE AND SALVAGE
- RET = RETAIN
- S = SALVAGE
- N = NEW
- B-B = BACK TO BACK
- = EXISTING
- = NEW

PROJECT NAME: RANDOLPH
 PROJECT NUMBER: STP 2932 (1)

FILE NAME: z10c270.dgn
 PROJECT LEADER: C. LATHROP
 DESIGNED BY: B. BRESLEND
 PROJECT LAYOUT SHEET 25

PLOT DATE: 6/5/2014
 DRAWN BY: B. BRESLEND
 CHECKED BY: C. LATHROP
 SHEET 56 OF 276

