

DURABLE 4 INCH WHITE LINE (SEE OPTION ITEMS)
STA. 165+75 - STA. 171+50 (SOLID LT & RT)



TEMPORARY 4 INCH WHITE LINE, PAINT
STA. 165+75 - STA. 171+50 (SOLID LT & RT)

REMOVING SIGNS
AS SHOWN - 5

DURABLE 4 INCH YELLOW LINE, POLYUREA
STA. 165+75 - STA. 171+50 (SOLID LT & RT)

TEMPORARY 4 INCH YELLOW LINE, PAINT
STA. 165+75 - STA. 171+50 (SOLID LT & RT)

6 INCH UNDERDRAIN PIPE
~~STA. 167+78 - STA. 169+00 LT~~
~~STA. 170+00 - STA. 171+50 LT~~
STA. 167+70 - STA. 171+30 LT

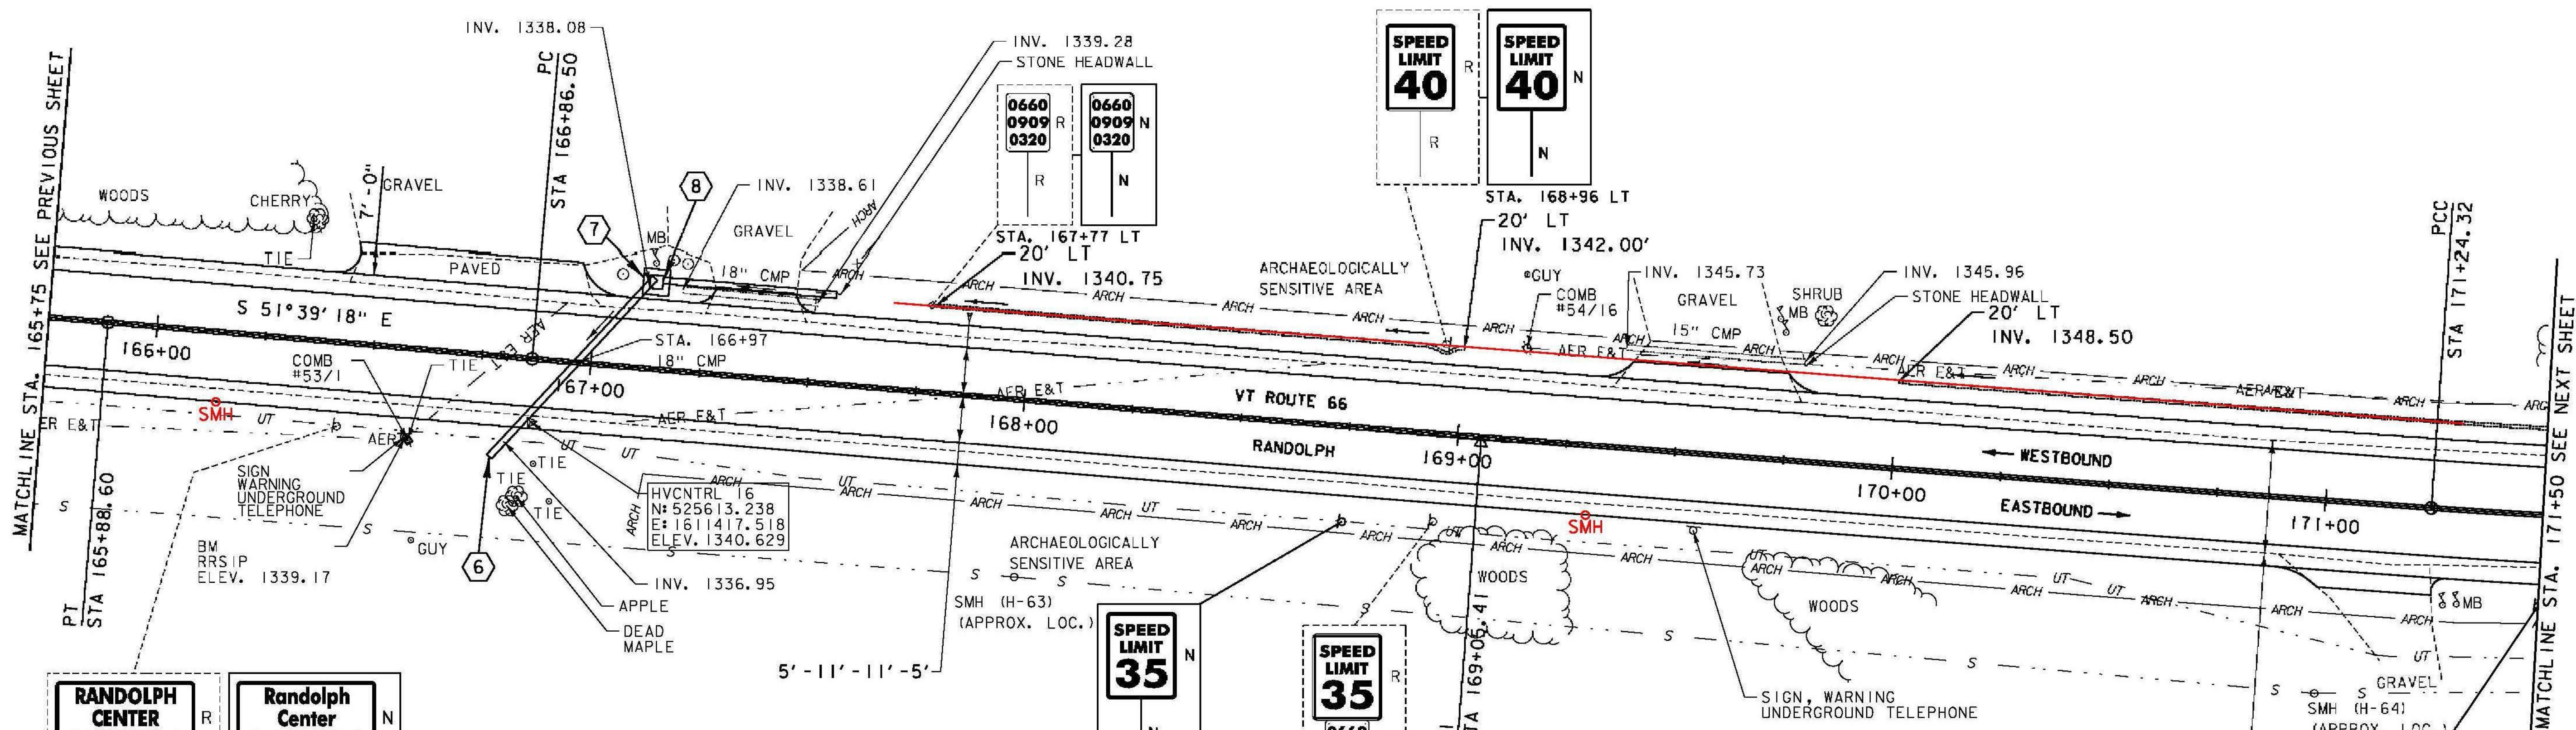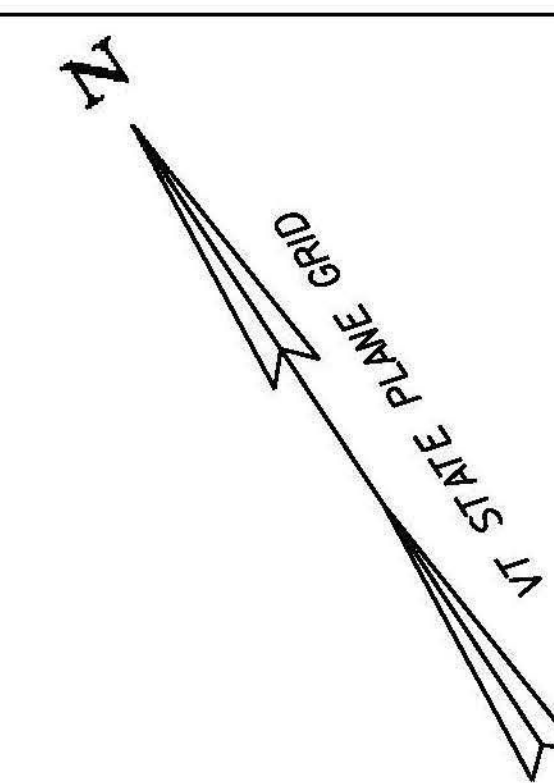

- 6 STA. 166+78.56 RT 23.29' TO STA. 167+13.02 LT 20.85'
REMOVE EXISTING PIPE
INSTALL NEW 18" CPEP (56'-0")
INV. IN = 1337.15'
INV. OUT = 1336.85'
- 7 STA. 167+13.50 LT 20.00'
CONCRETE REINFORCED CATCH BASIN WITH CAST IRON GRATE (TYPE D)
RIM = 1341.00'
- 8 STA. 167+15.00 LT 20.50' TO STA. 167+55.00 LT 20.50'
REMOVE EXISTING 18" CMP
REMOVE EXISTING HEADWALL
INSTALL NEW 18" CPEP (40'-0")
INV. IN = 1340.45'
INV. OUT = 1337.75'

SIGN LEGEND

- R = REMOVE
- R&S = REMOVE AND SALVAGE
- RET = RETAIN
- S = SALVAGE
- N = NEW
- B-B = BACK TO BACK
- = EXISTING
- = NEW

PROJECT NAME: RANDOLPH
PROJECT NUMBER: STP 2932 (1)

FILE NAME: z10c270.dgn
PROJECT LEADER: C. LATHROP
DESIGNED BY: B. BRESLEND
PROJECT LAYOUT SHEET 26

PLOT DATE: 6/5/2014
DRAWN BY: B. BRESLEND
CHECKED BY: C. LATHROP
SHEET 57 OF 276

