

DURABLE 4 INCH WHITE LINE (SEE OPTION ITEMS)  
STA. 199+25 - STA. 204+50 (SOLID LT & RT)

TEMPORARY 4 INCH WHITE LINE, PAINT  
STA. 199+25 - STA. 204+50 (SOLID LT & RT)

6 INCH UNDERDRAIN PIPE  
STA. 202+60 - STA. 204+50 RT

DURABLE 4 INCH YELLOW LINE, POLYUREA  
STA. 199+25 - STA. 204+50 (SOLID LT & RT)


TEMPORARY 4 INCH YELLOW LINE, PAINT  
STA. 199+25 - STA. 204+50 (SOLID LT & RT)

REMOVING SIGNS  
AS SHOWN - 2

(12) STA. 202+46.44 LT 27.94' TO  
STA. 202+49.86 RT 25.95'  
REMOVE EXISTING PIPE  
INSTALL NEW 18" CPEP (54'-0")  
INV. IN = 1373.21'  
INV. OUT = 1372.67'


RELOCATE MAILBOX, SINGLE SUPPORT  
STA. 203+90 RT

CURVE #29  
DELTA = 1°06'02"  
D = 1°08'45"  
R = 5000.00'  
T = 48.02'  
L = 96.04'  
E = 0.23'  
BANKING NORMAL CROWN  
DESIGN SPEED 35 MPH

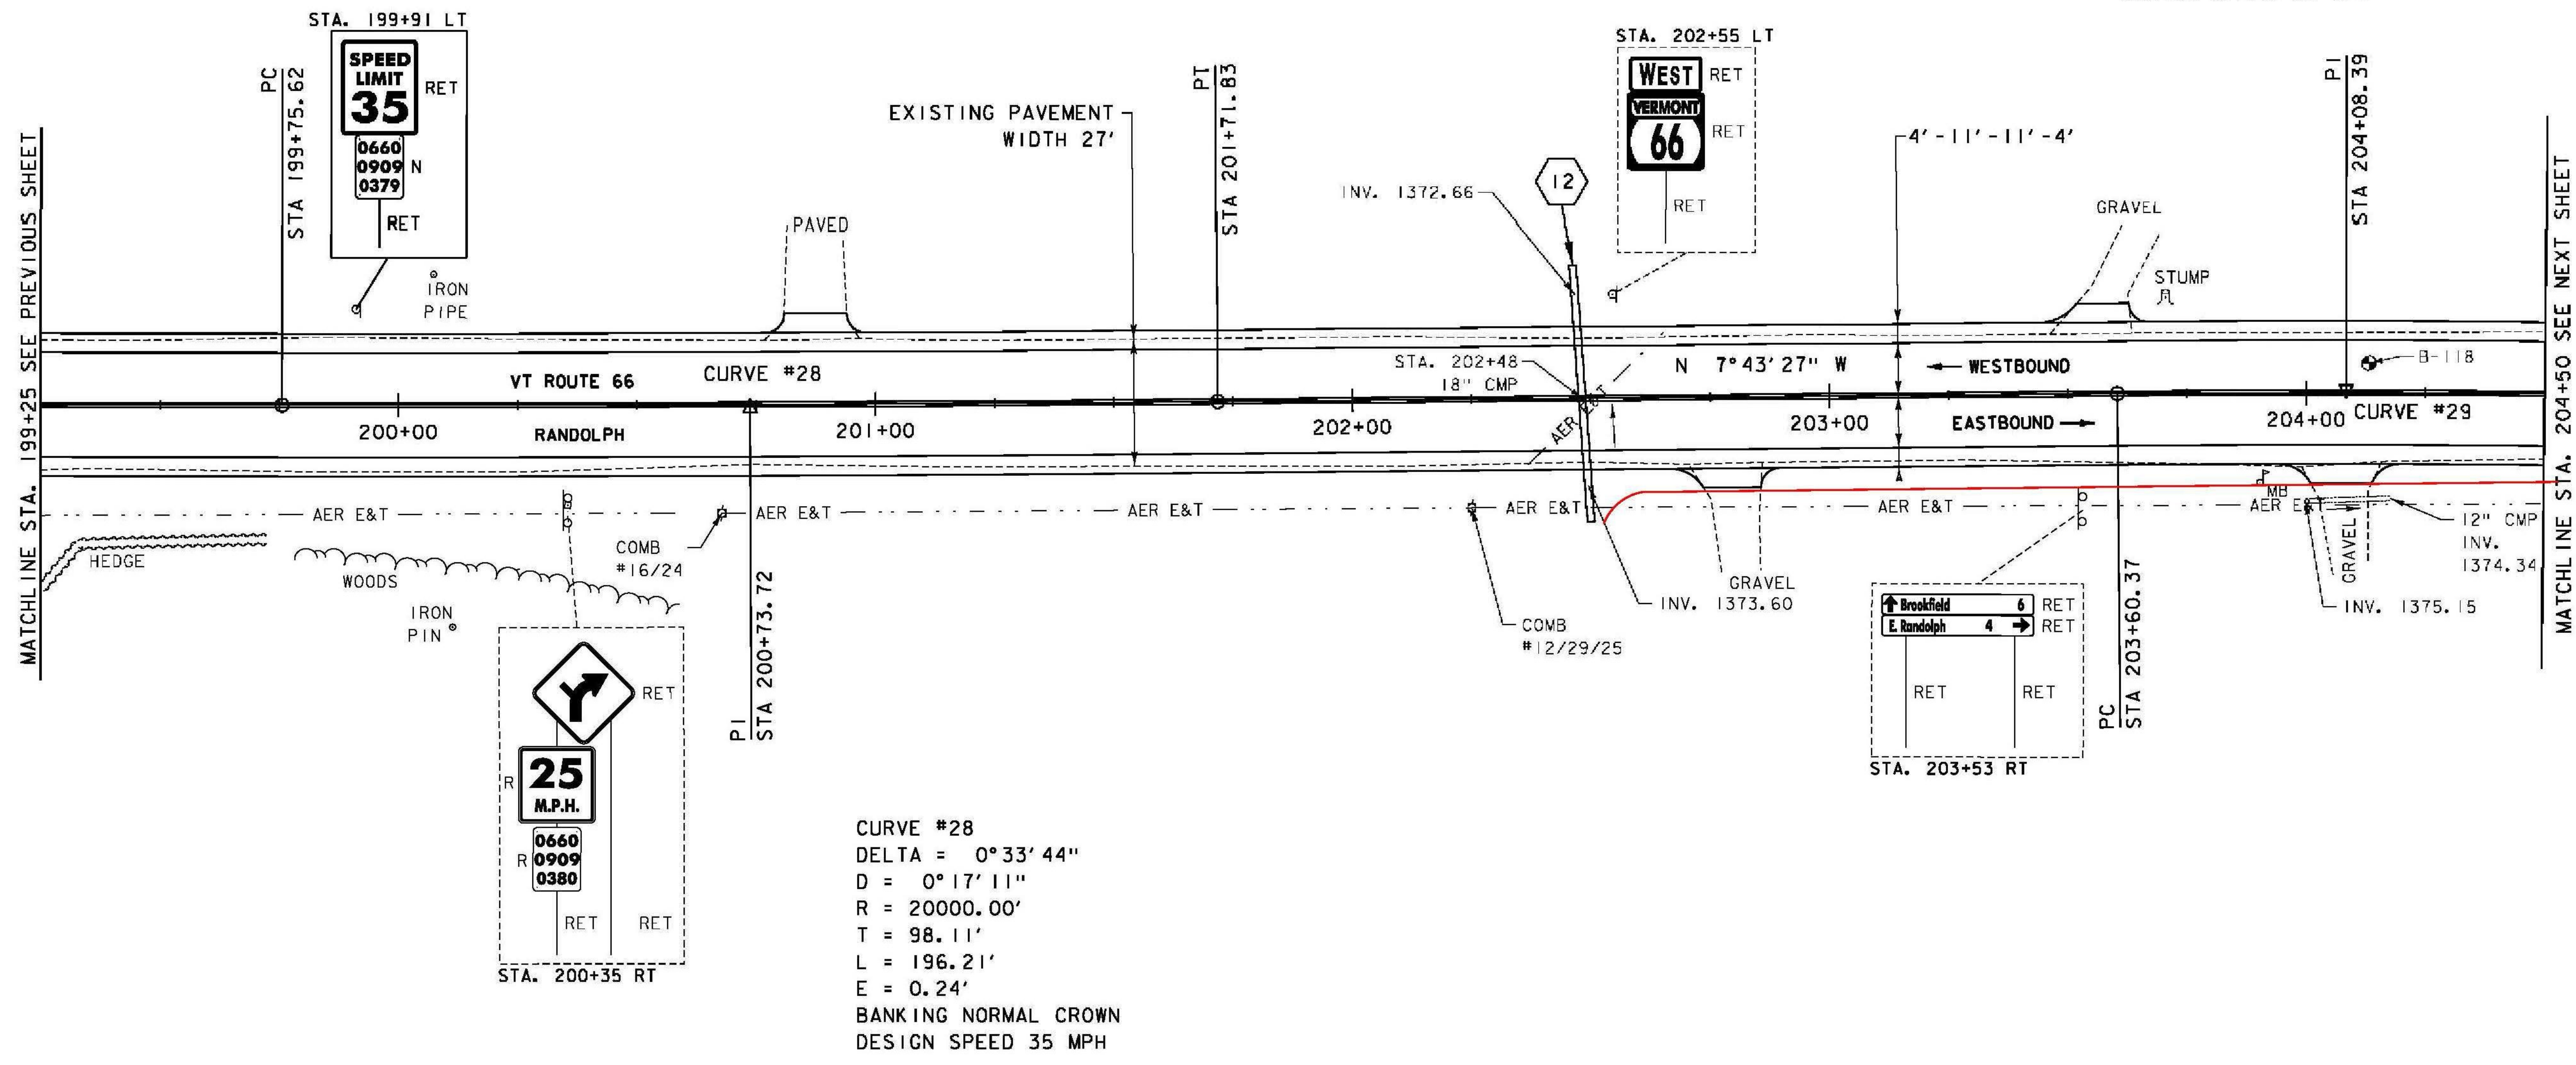

**SIGN LEGEND**

- R = REMOVE
- R&S = REMOVE AND SALVAGE
- RET = RETAIN
- S = SALVAGE
- N = NEW
- B-B = BACK TO BACK
- = EXISTING
- = NEW

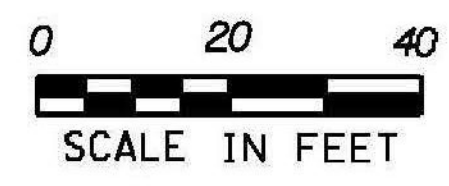

PROJECT NAME: RANDOLPH	FILE NAME: z10c270.dgn	PLOT DATE: 6/5/2014
PROJECT NUMBER: STP 2932 (1)	PROJECT LEADER: C. LATHROP	DRAWN BY: B. BRESLEND
	DESIGNED BY: B. BRESLEND	CHECKED BY: C. LATHROP
	PROJECT LAYOUT SHEET 32	SHEET 63 OF 276